

DELAWARE COUNTY, OHIO

EAST ALUM CREEK INTERCEPTOR


SANITARY SEWER AND PUMP STATION

Sanitary Sewer, Force Main, and Pump Station Improvements

STANDARD DRAWINGS

The Standard Drawings listed in the plans shall be considered a part thereof.

- 01 SEWER INSTALLATION
- 02 TYPICAL SERVICE CONNECTION
- 03 BRANCH CONNECTION AND RISER PIPE
- 05 MANHOLE CHANNEL DETAIL
- 06 TYPE "A" PRECAST CONCRETE MANHOLE
- 13 DROP MANHOLE
- 14 FORCE MAIN CONNECTION TO MANHOLE DETAIL
- 16 MANHOLE MARKING DETAIL
- 18 TYPICAL CONCRETE ENCASEMENT
- 20 WATERLINE CROSSINGS
- 21 OPEN CUT OF COUNTY & TOWNSHIP ROADS
- 22 PAVEMENT REPLACEMENT DETAILS
- 23 CONCRETE REACTION BACKING DETAILS
- 24 BACKING FOR VERTICAL BENDS
- 25 AUTOMATIC AIR RELEASE VALVE
- 26 TAPPING SLEEVE FOR CLAY PIPE
- 29 MANHOLE LANDING PLATFORM

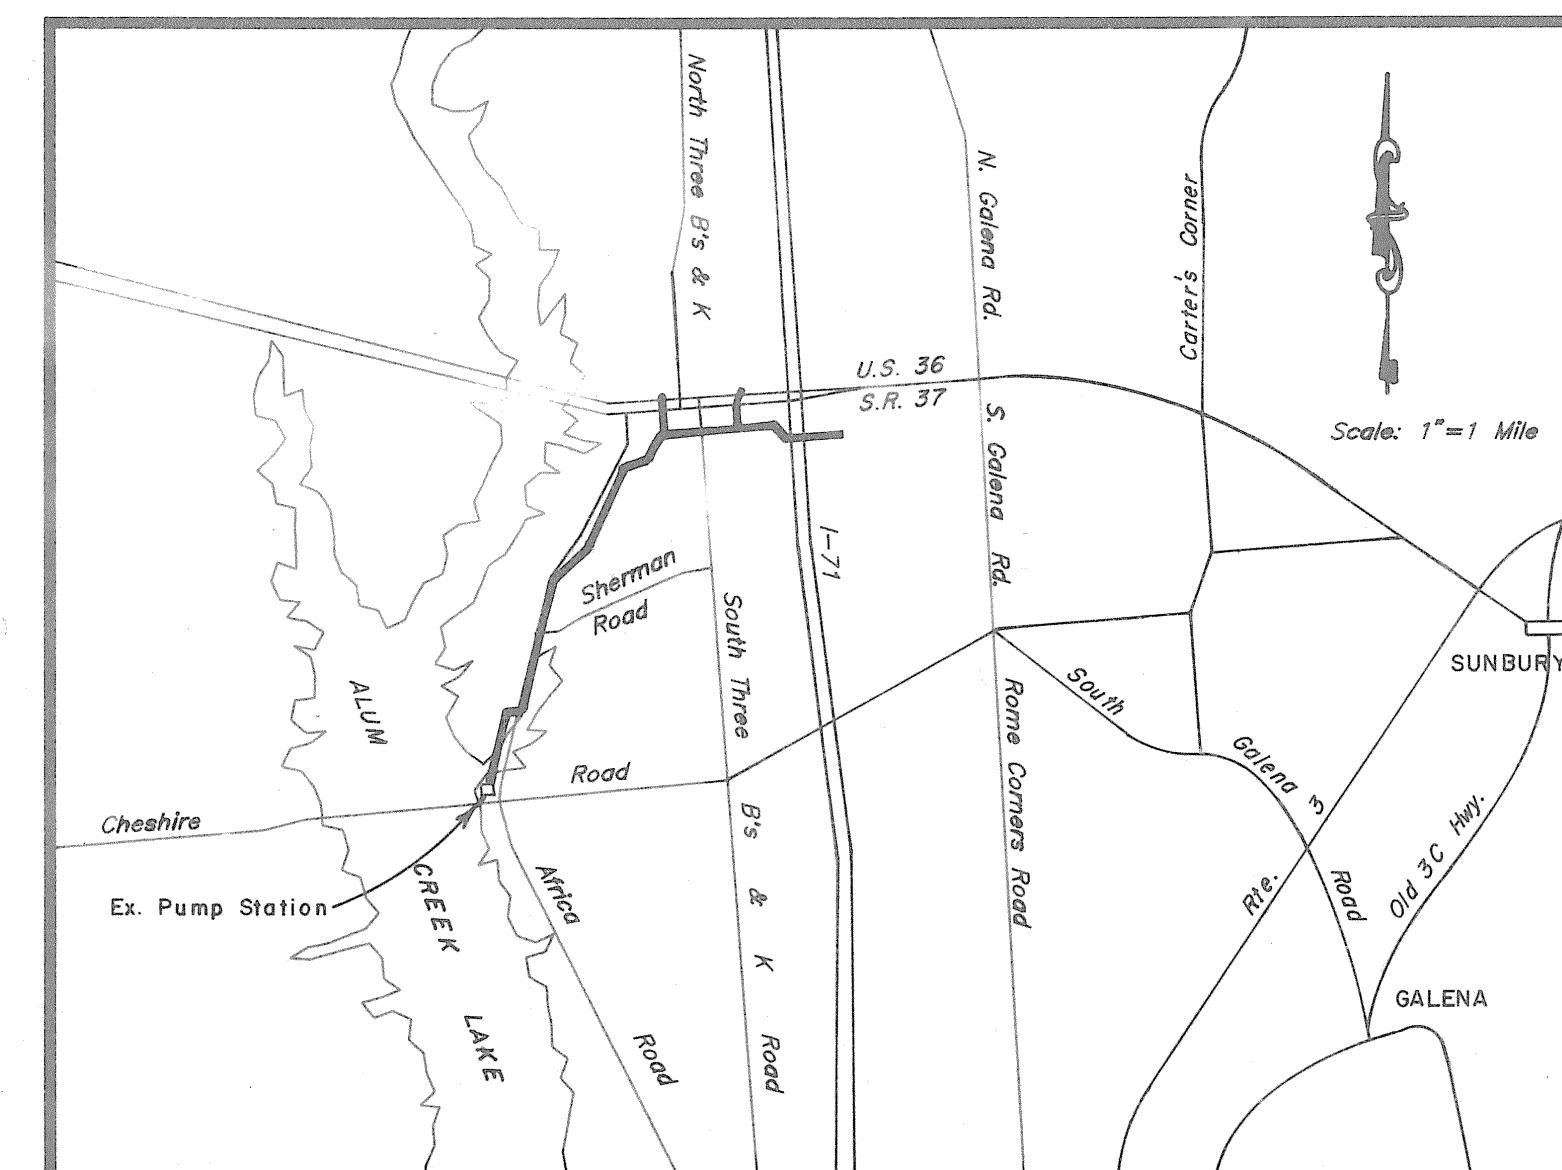

LOCATION MAP

PREPARED BY
EVANS, MECHWART, HAMBLETON & TILTON, INC.
 CONSULTING ENGINEERS & SURVEYORS
 GAHANNA, OHIO

John E. Johnson
Registered Engineer

John E. Johnson
Date 10/30/91

The signatures below signify only concurrence with the general purposes and general location of the project. All technical details remain the responsibility of the Engineer preparing the plans.

Jack Smelker
Delaware County Sanitary Engineer


John E. Johnson
Date 12/2/91

Bob Jackson
Delaware County Commissioner

Bob Jackson
Date 12-2-91


Markie Shrest
Delaware County Commissioner

Markie Shrest
Date

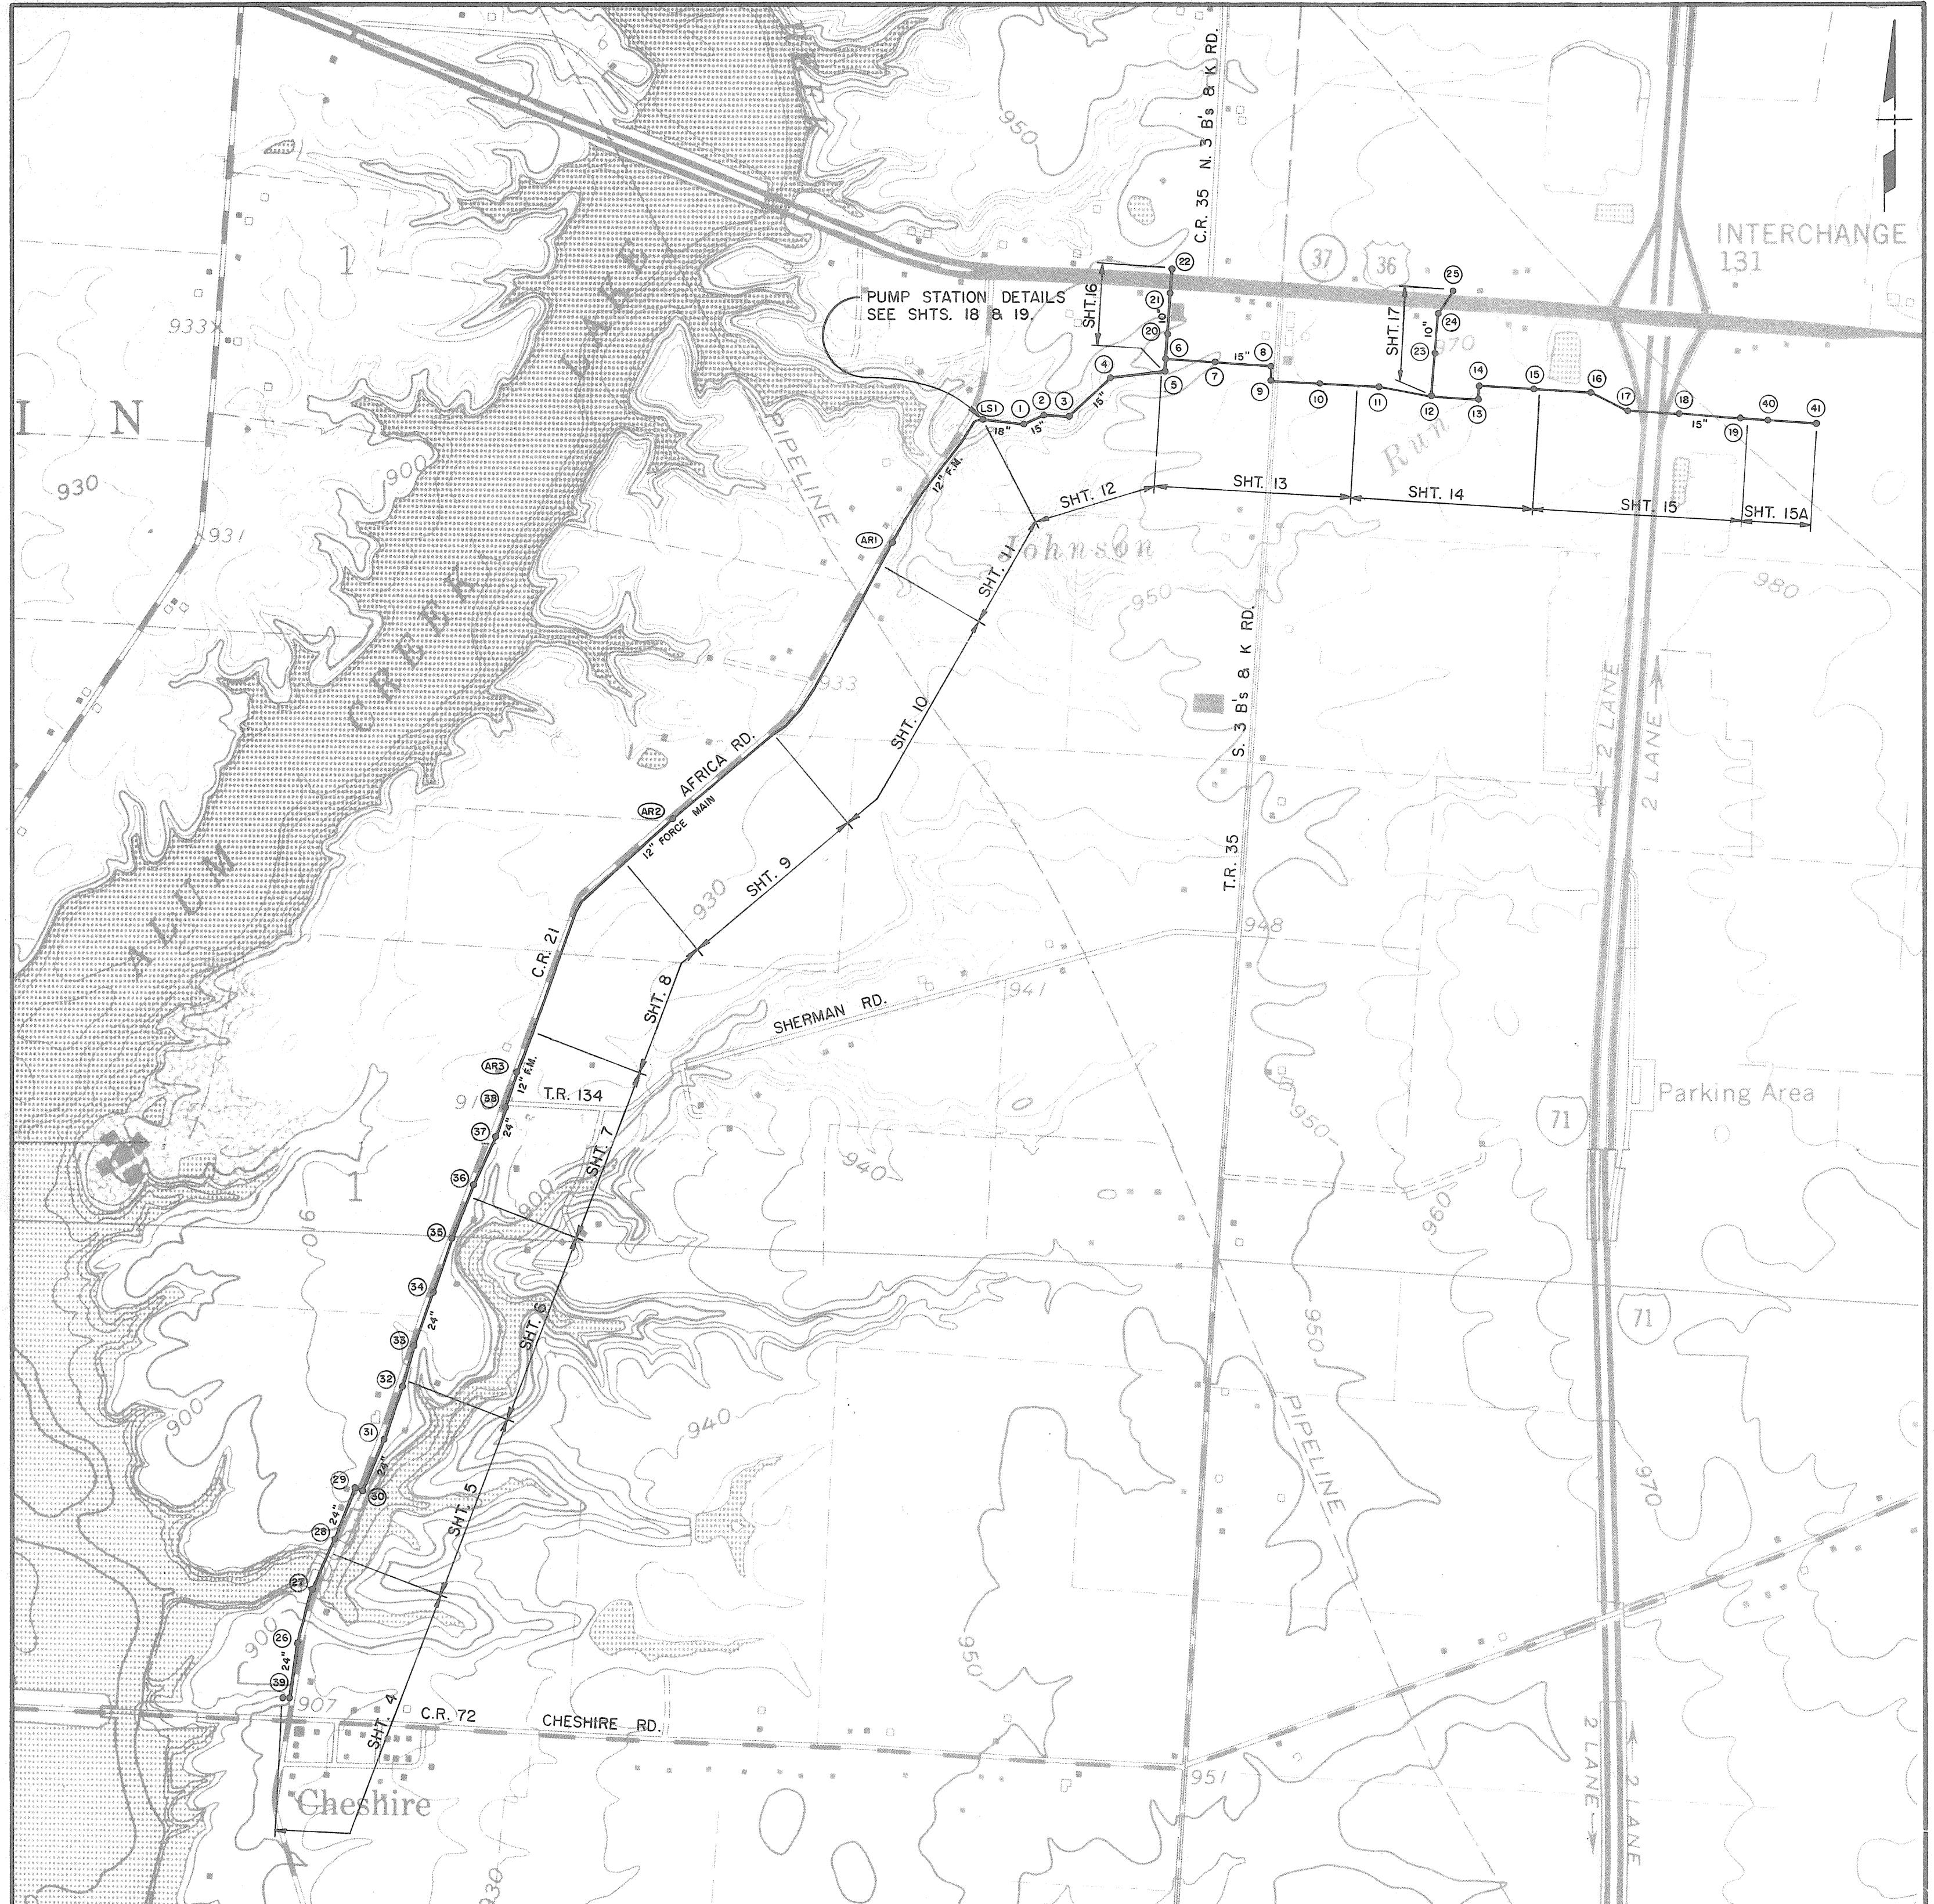

BENCH MARKS

- | | | |
|---------|---|--------------|
| B.M. | Chiseled square on SE corner of lift station 150' N of Cheshire Rd. & Africa Rd. intersection, 75' W of Africa Rd. Delaware County B.M. #109A. | Elev. 901.66 |
| B.M. #1 | Spike in E side of utility pole, W side of Africa Rd., 0.25 mi. N of Cheshire & 400' S of entrance to boat ramp. Delaware County B.M. #108. | Elev. 903.59 |
| B.M. #2 | Spike in W side of utility pole, E side of Africa Rd., 0.40 mi. N of Cheshire & 200' S of entrance to boat ramp. | Elev. 914.57 |
| B.M. #3 | Spike in W side of utility pole #D102A82, E side of Africa Rd., 0.60 mi. N of Cheshire. Delaware County B.M. #107. | Elev. 912.96 |
| B.M. #4 | Spike in W side of utility pole, E side of Africa Rd., 400' S of Sherman Rd., 0.80 mi. N of Cheshire. | Elev. 915.81 |
| B.M. #5 | Spike in E side of 18" Hickory 20' W of Africa Rd. & 400' N of Sherman Rd. | Elev. 924.03 |
| B.M. | Spike in E side of 12" Elm 30' W of Africa Rd. at S line of residence #1008. Delaware County B.M. #106. | Elev. 926.97 |
| B.M. #6 | Spike in W side of 18" Elm 50' E of Africa Rd. at S line of residence #1008 extended E & 1.3 mi. N of Cheshire. | Elev. 929.00 |
| B.M. #7 | Spike in W side of utility pole on E side of Africa Rd. at N line of residence #1008 extended E & 1.6 mi. N of Cheshire. Delaware County B.M. #105. | Elev. 928.67 |
| B.M. #8 | Spike in E side of utility pole #D121A9, W side of Africa Rd., 1.7 mi. N of Cheshire. | Elev. 934.40 |

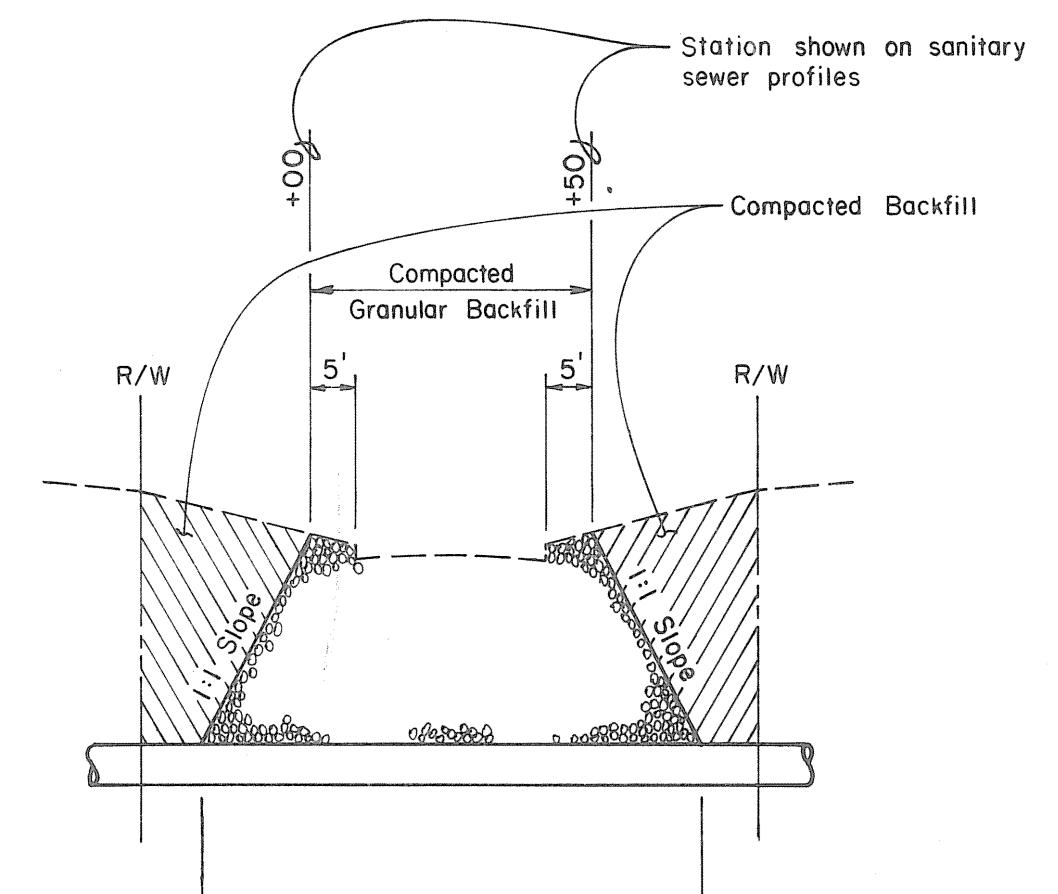

DETAIL OF BACKFILL IN R/W



No Scale


| ADDENDUM I REVISIONS | DATE |
|----------------------|----------|
| REVISIONS | 11/02/92 |



Delaware County, Ohio
**EAST ALUM CREEK INTERCEPTOR
SANITARY SEWER & PUMP STATION**
 Sanitary Sewer, Force Main and Pump Station Improvements



SCALE 1" = 800'

EVANS, MICHWART, HAMBLETON & TILTON, INC.
 CONSULTING ENGINEERS & SURVEYORS

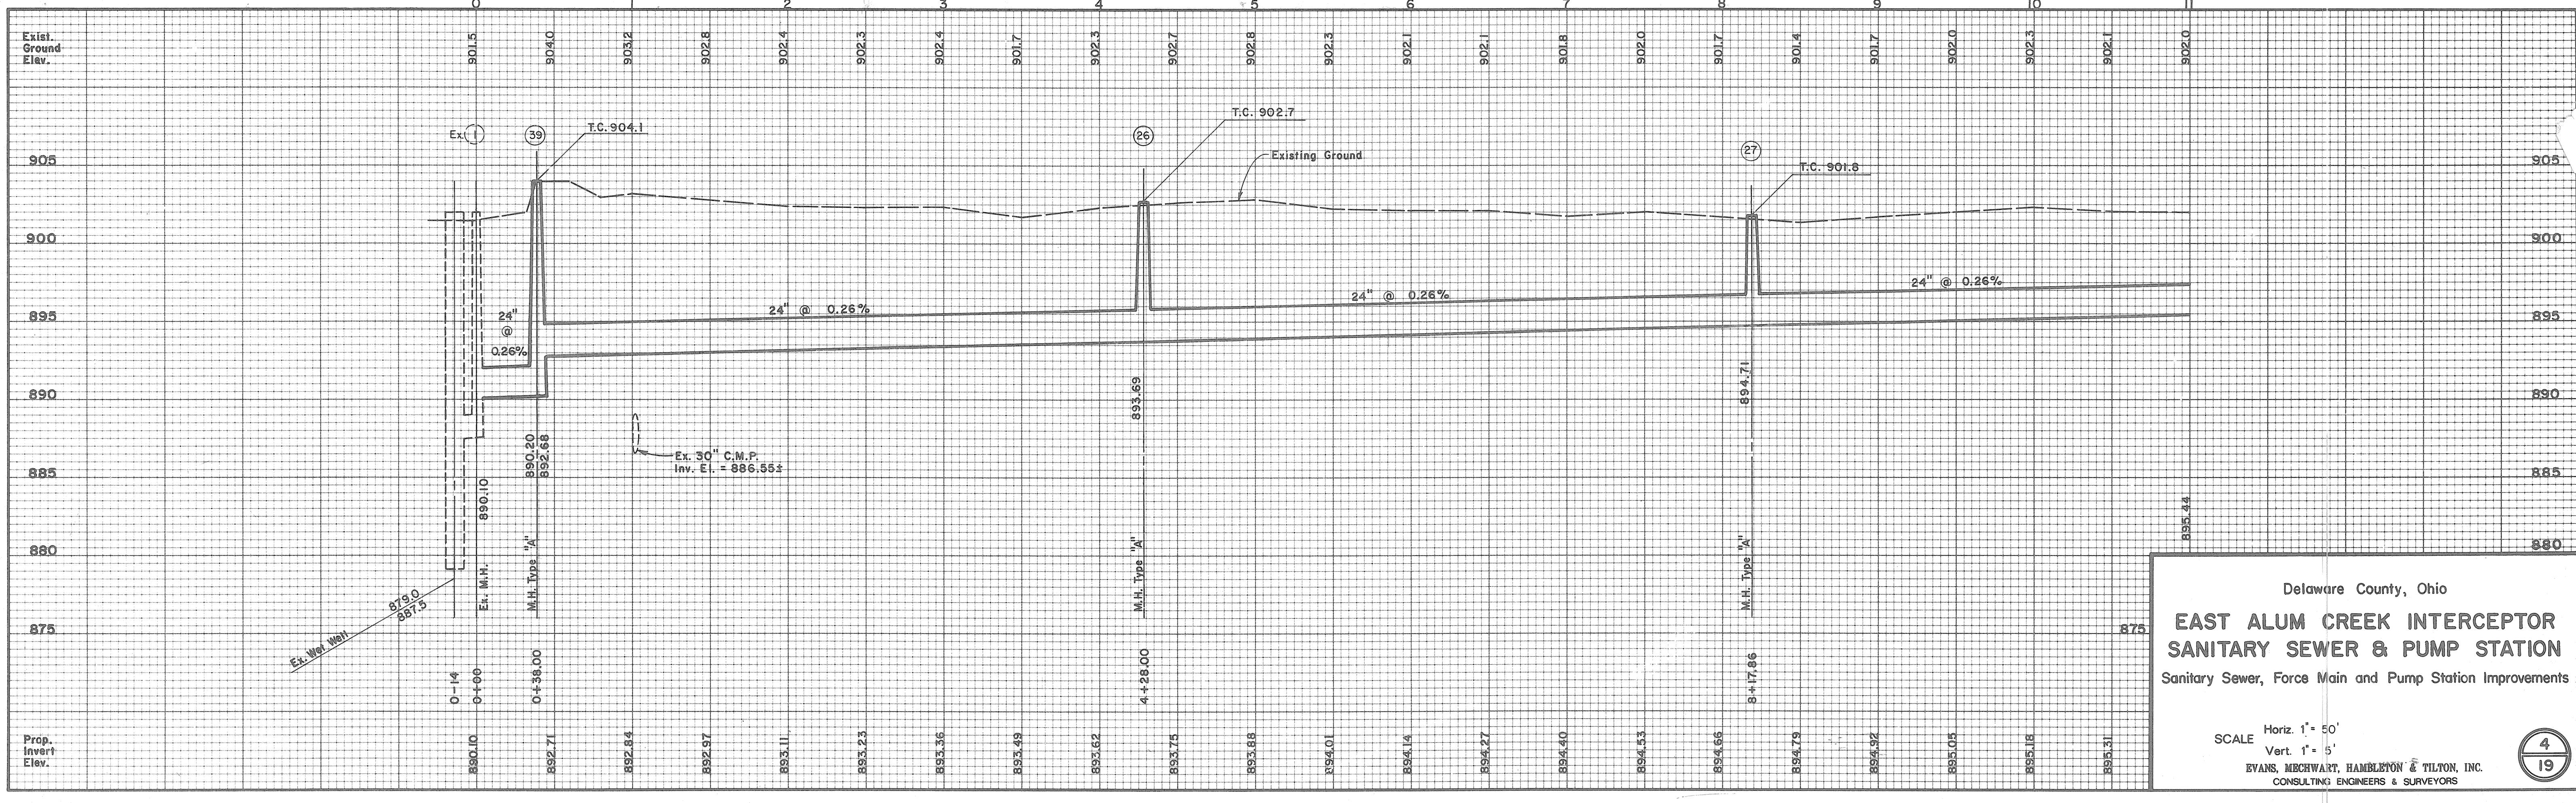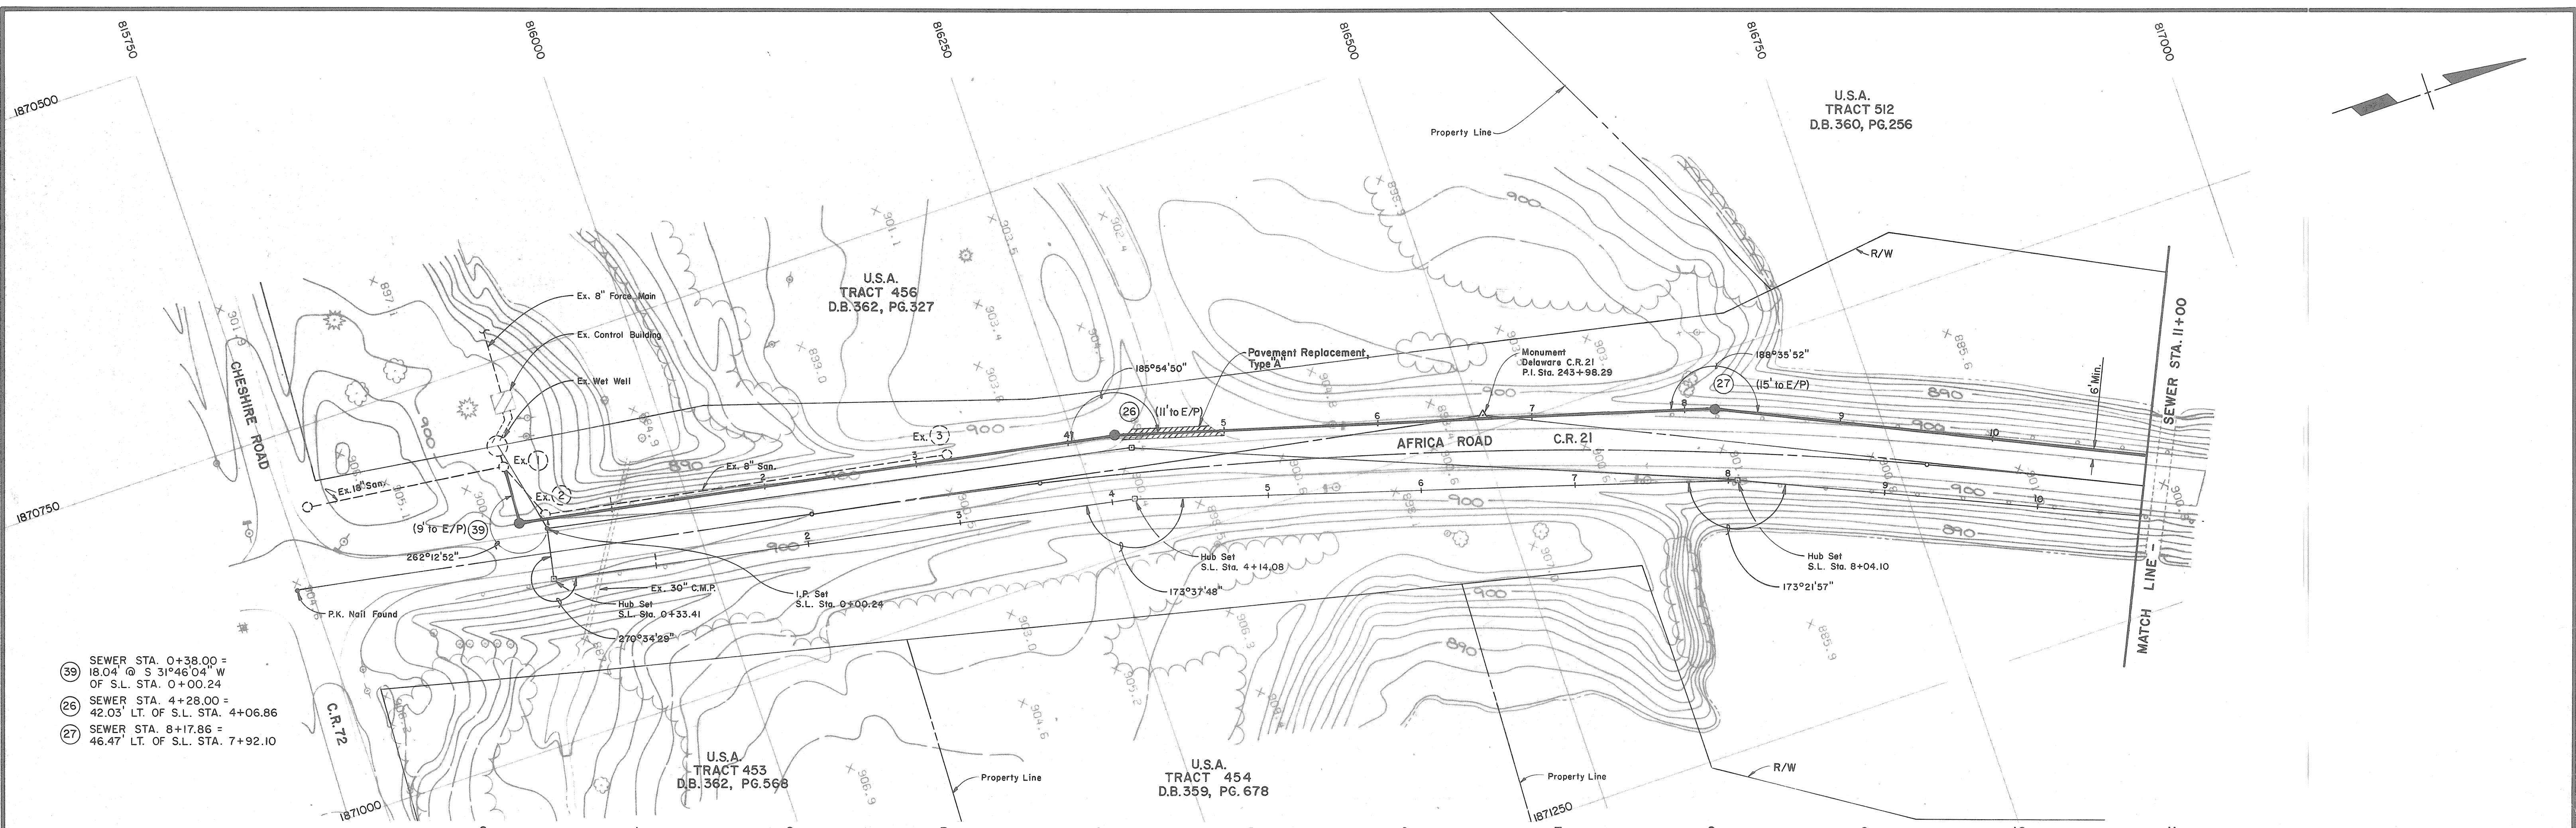


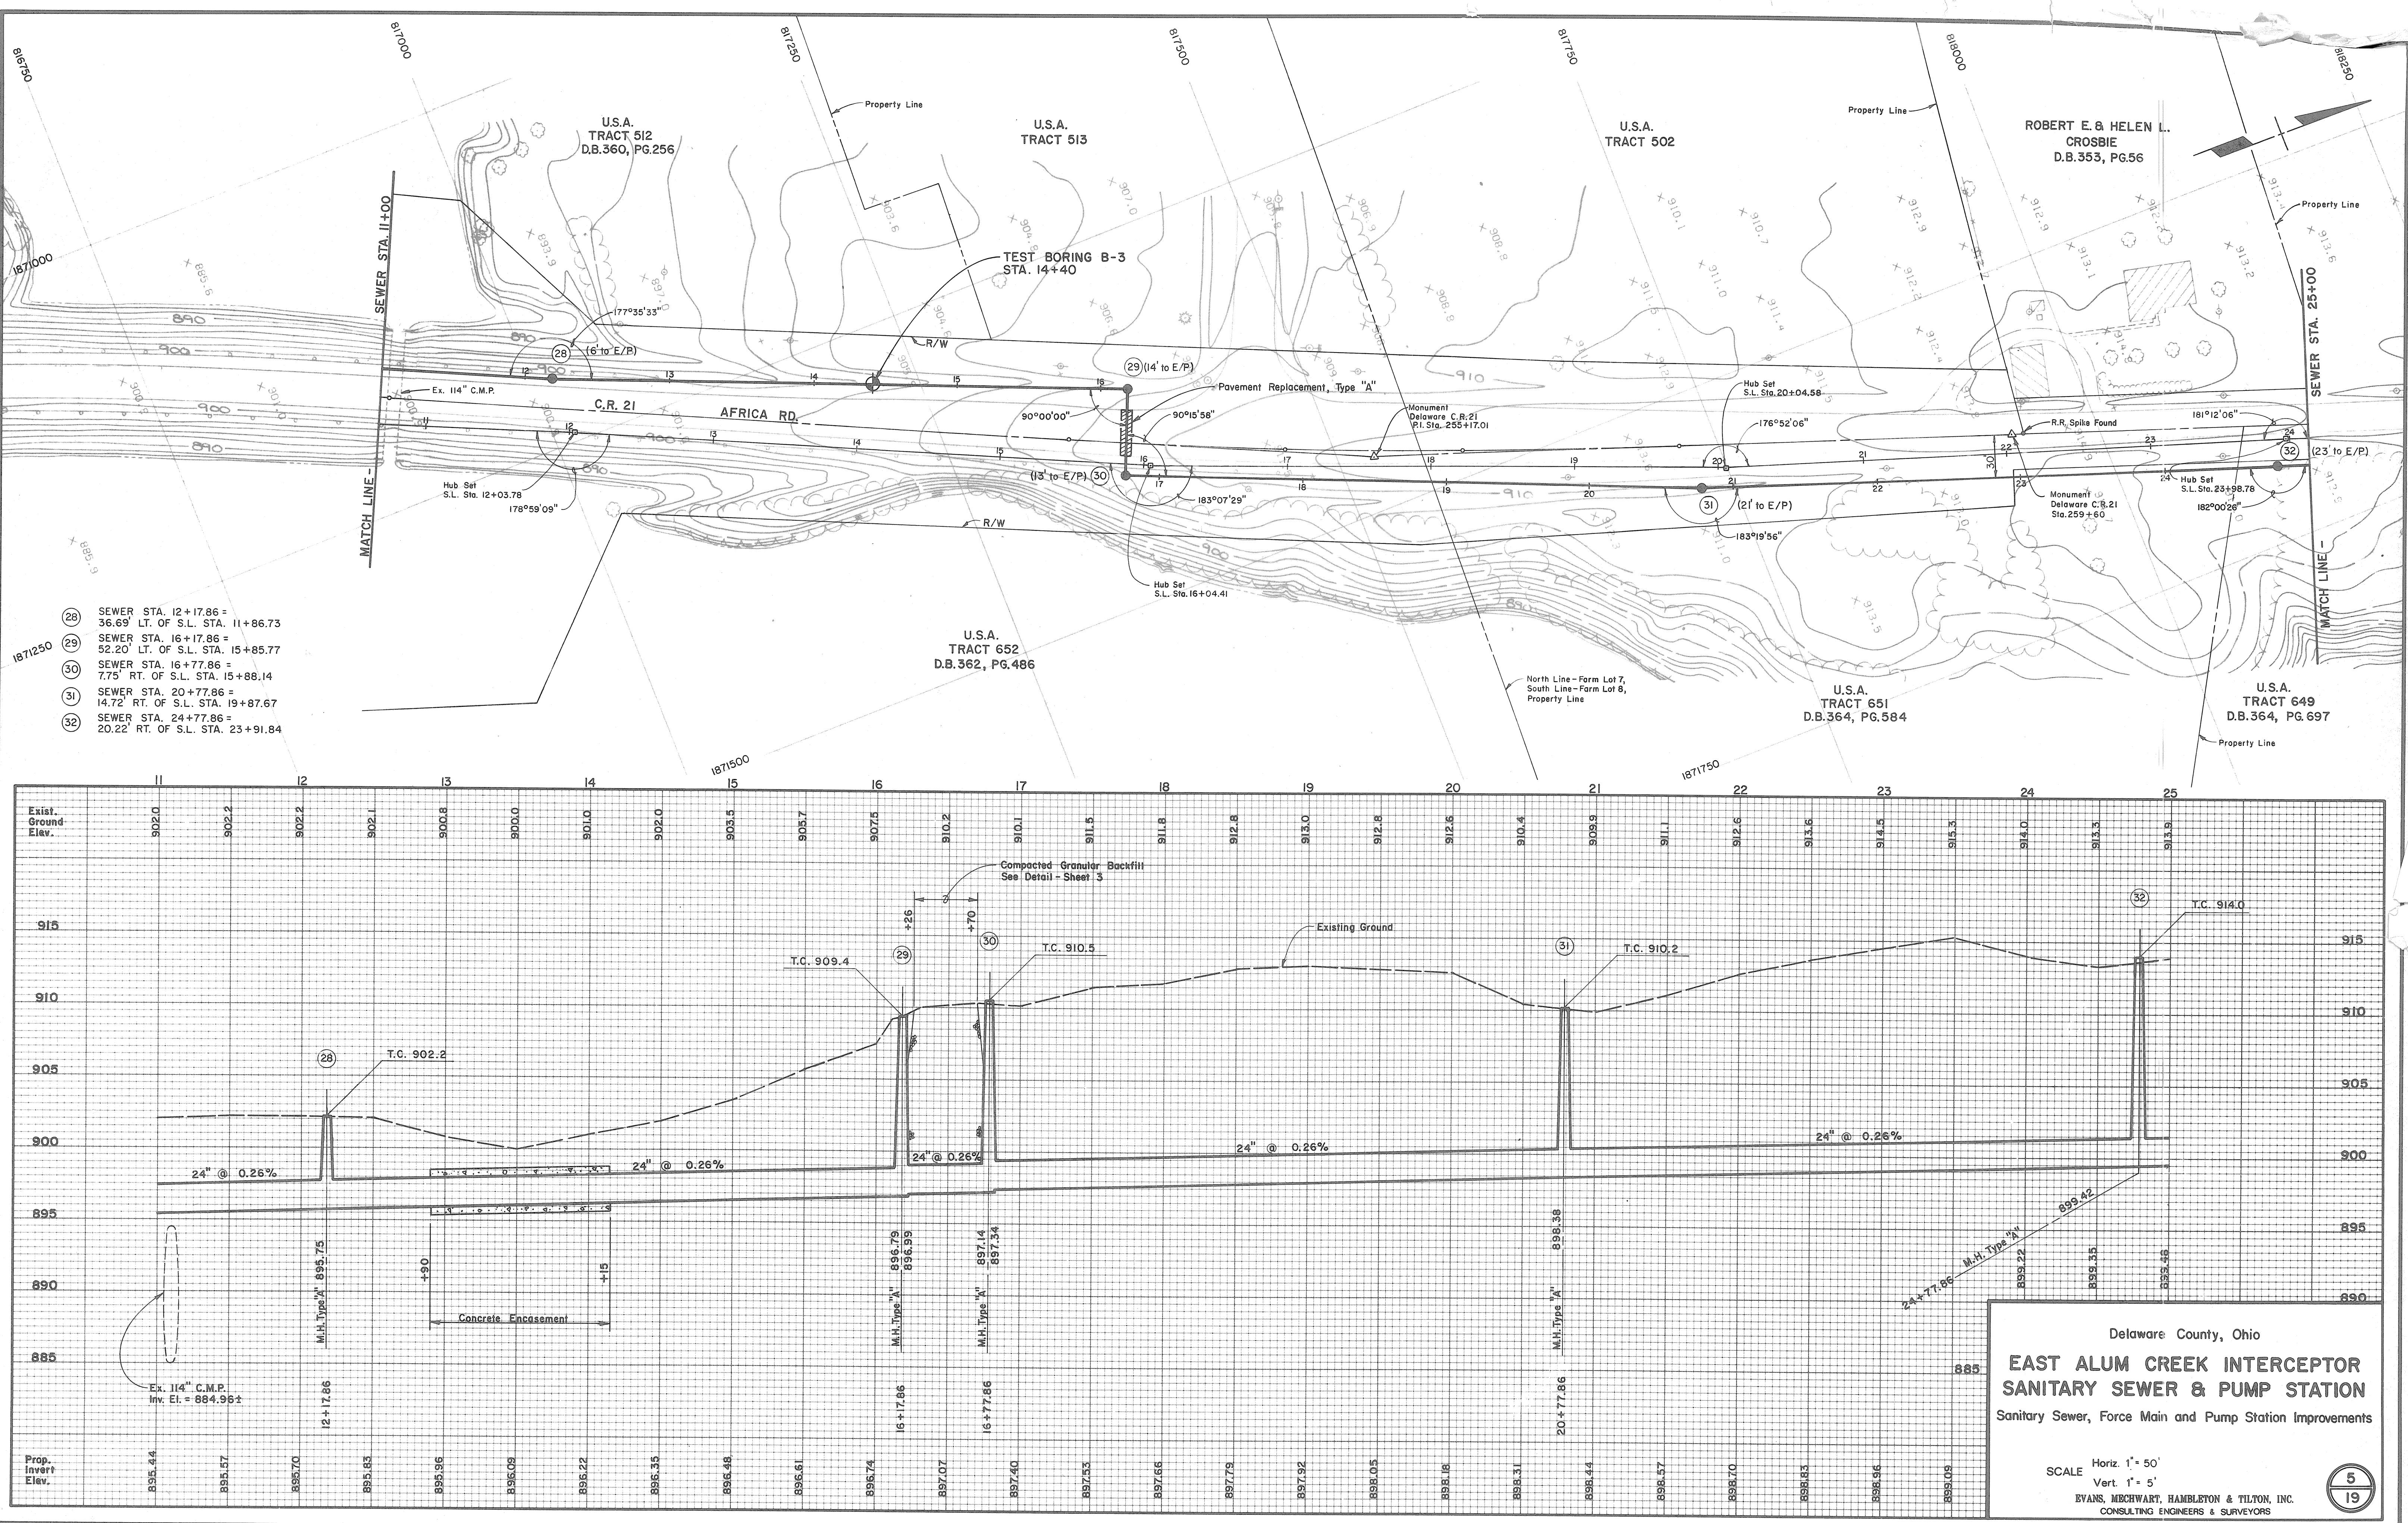


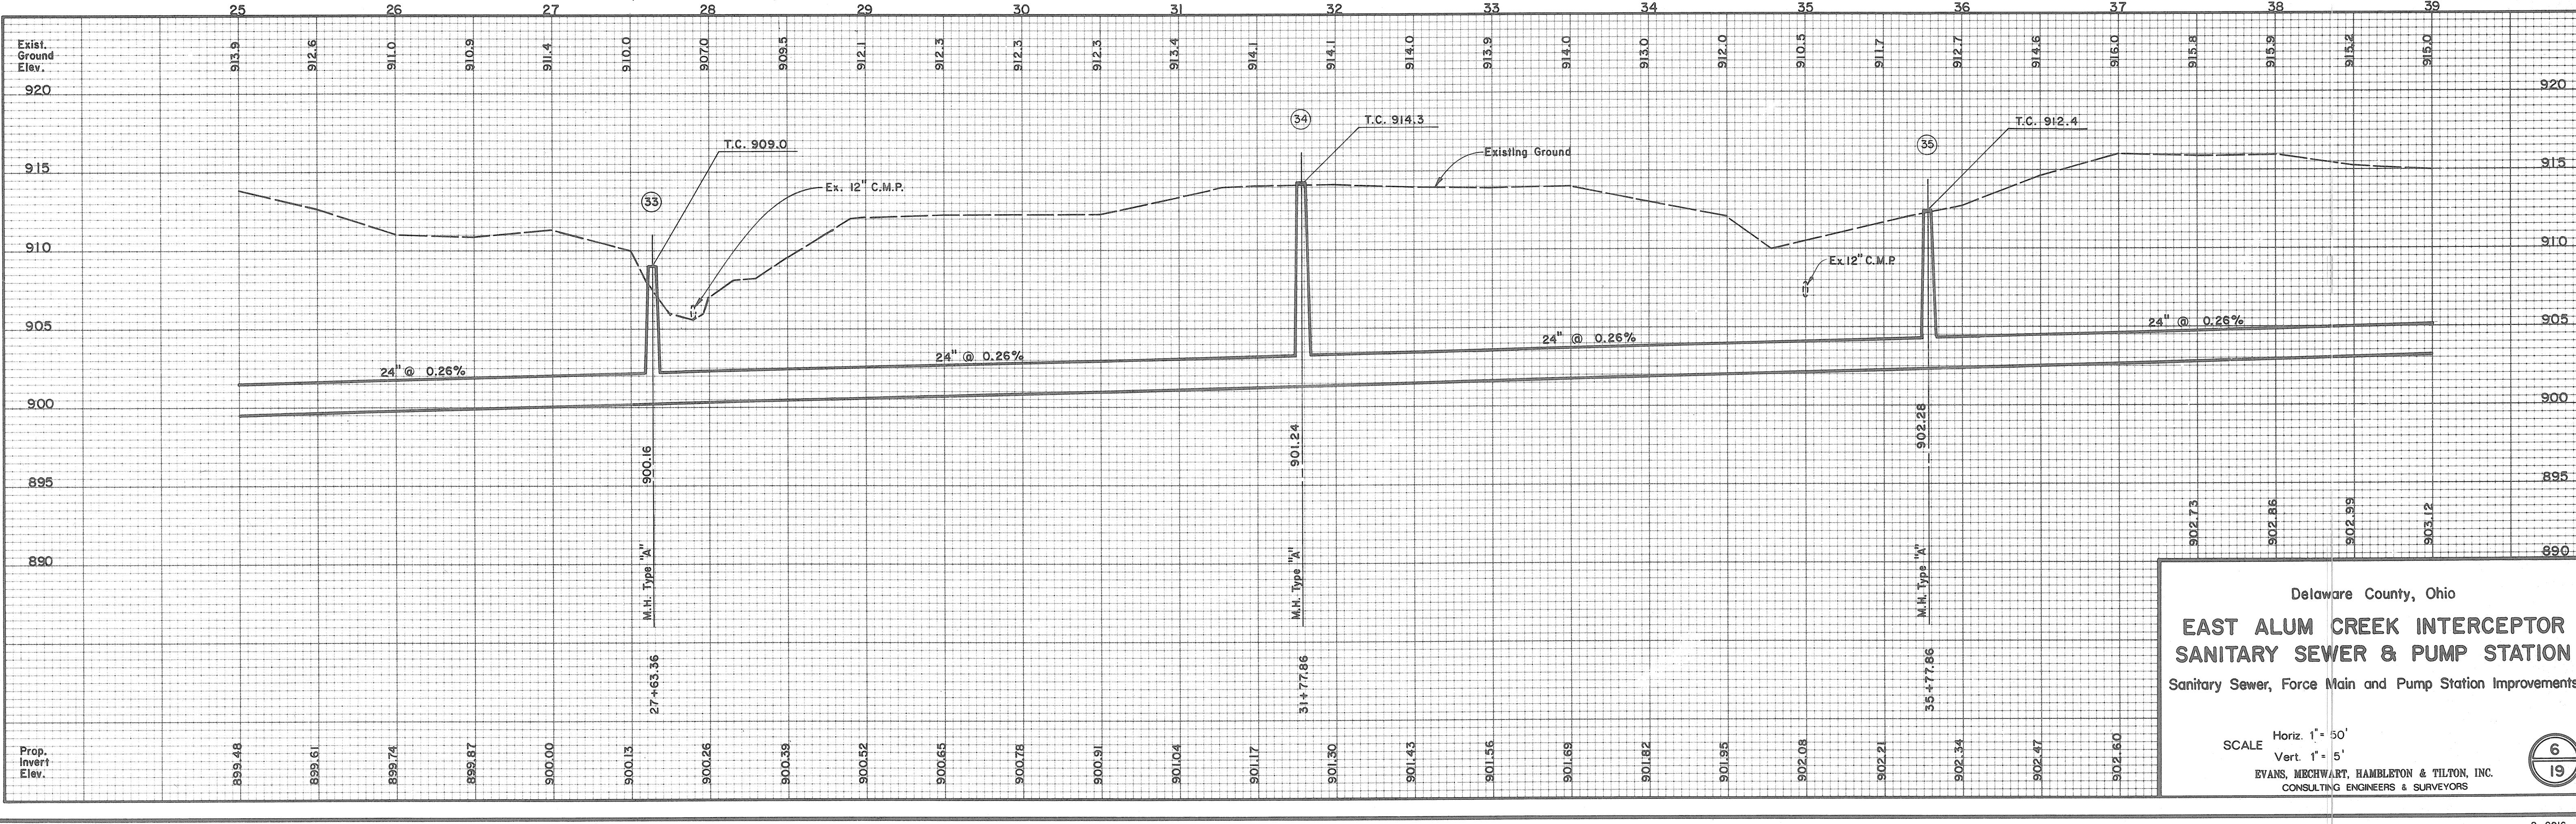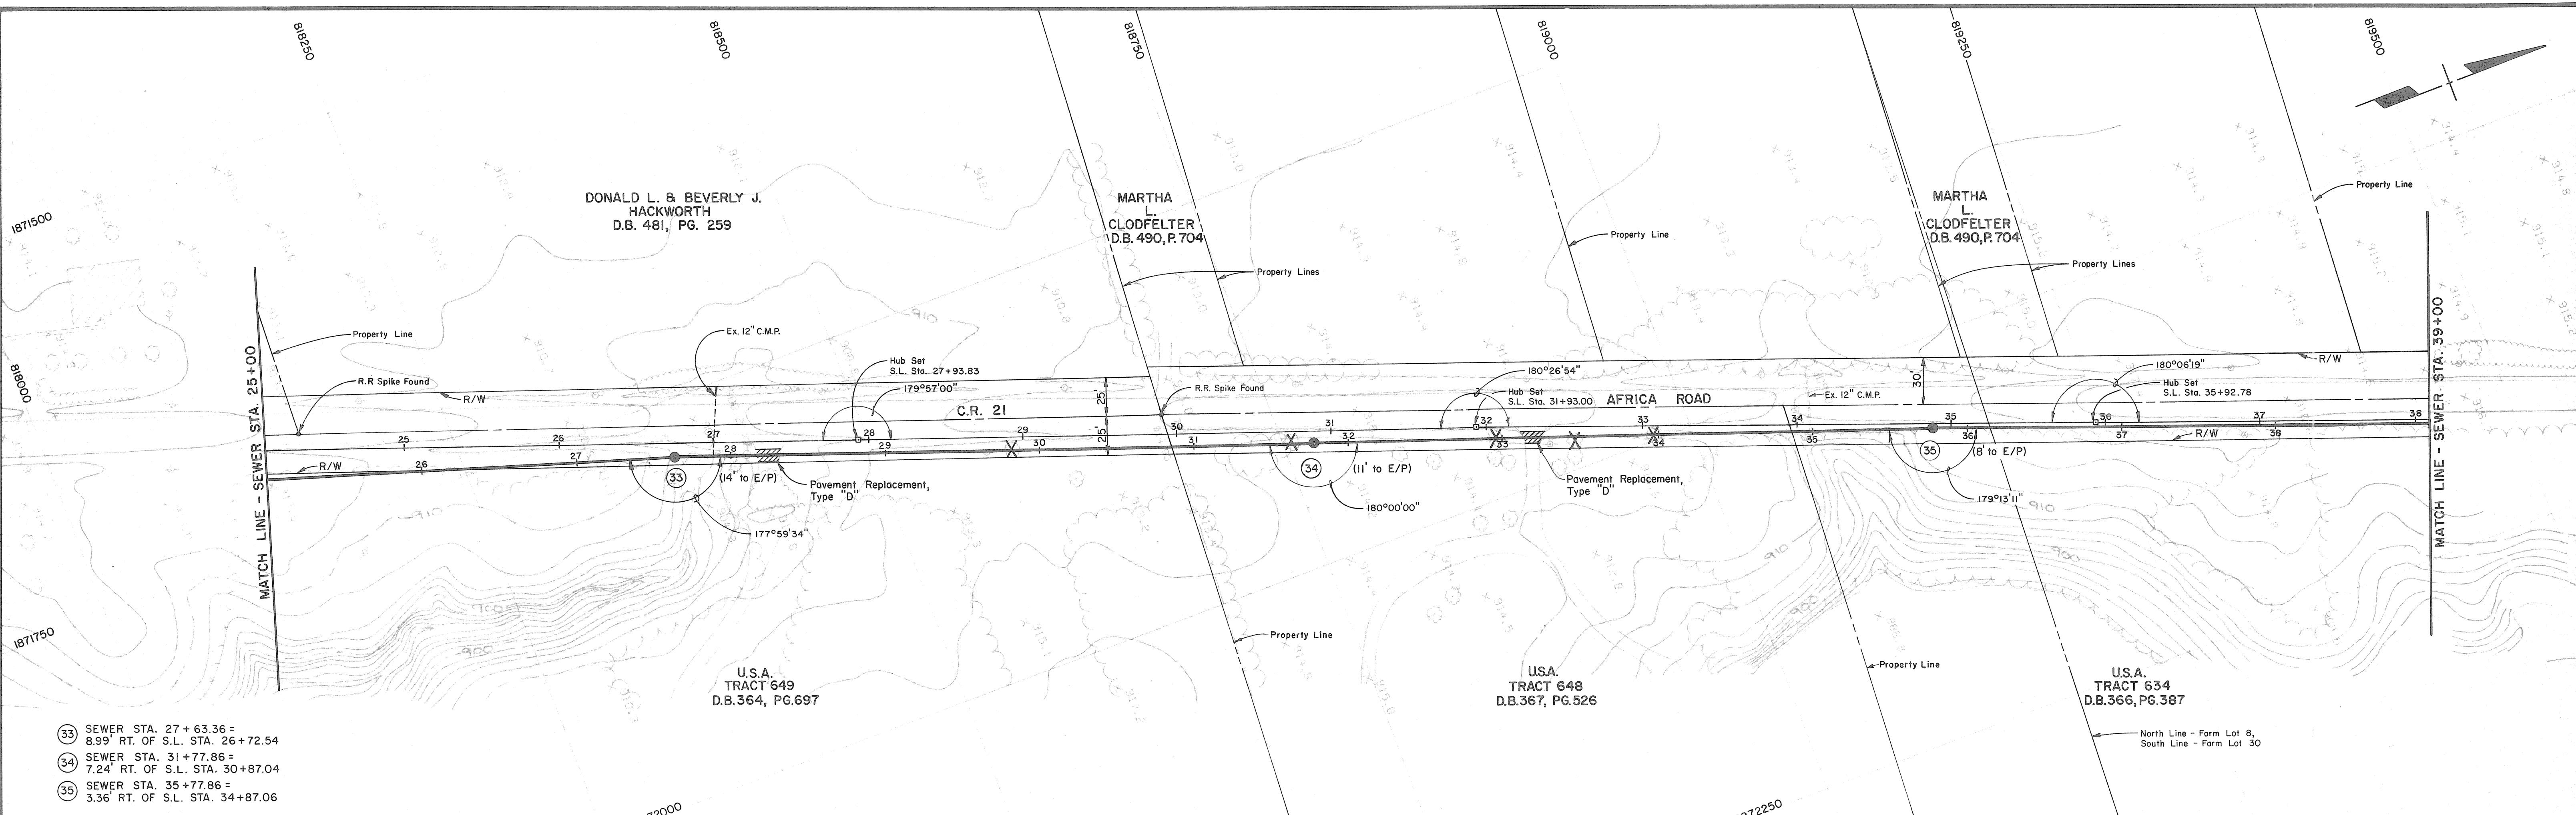


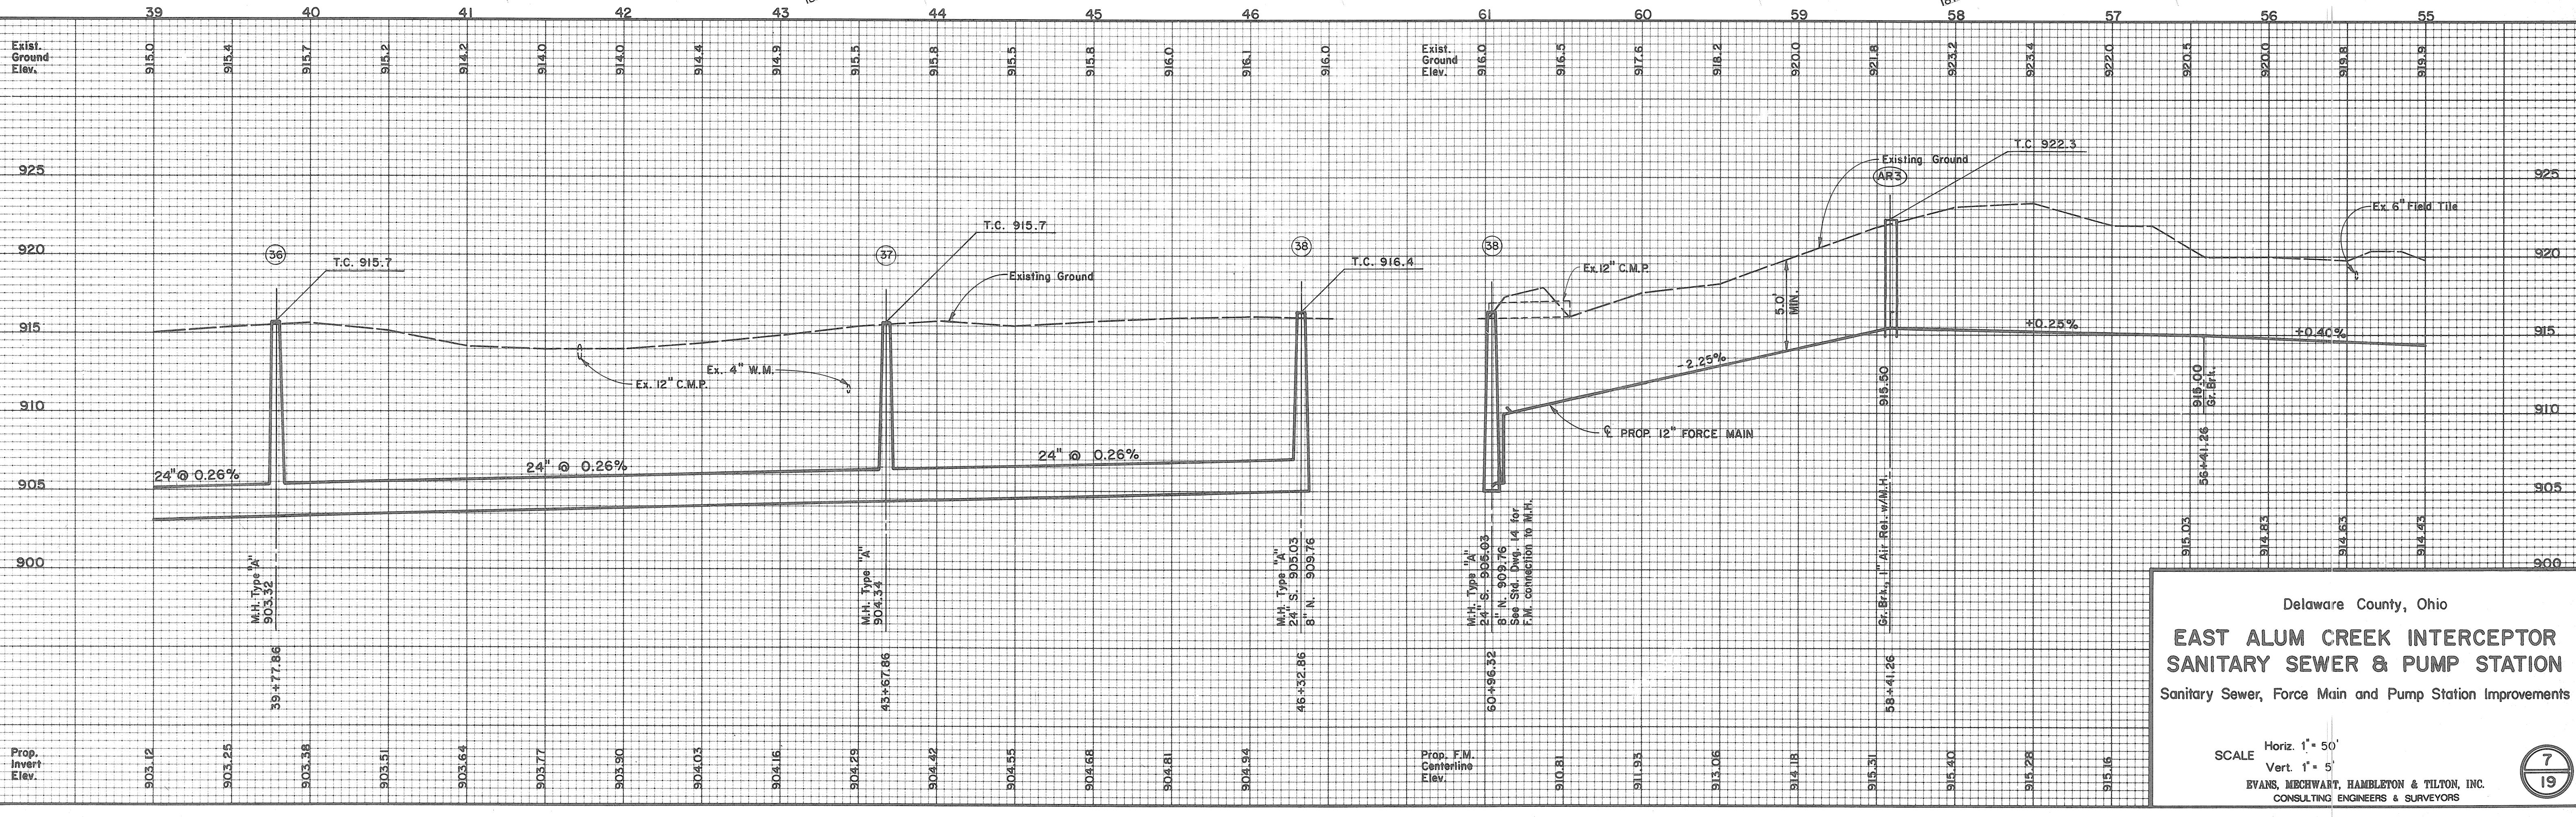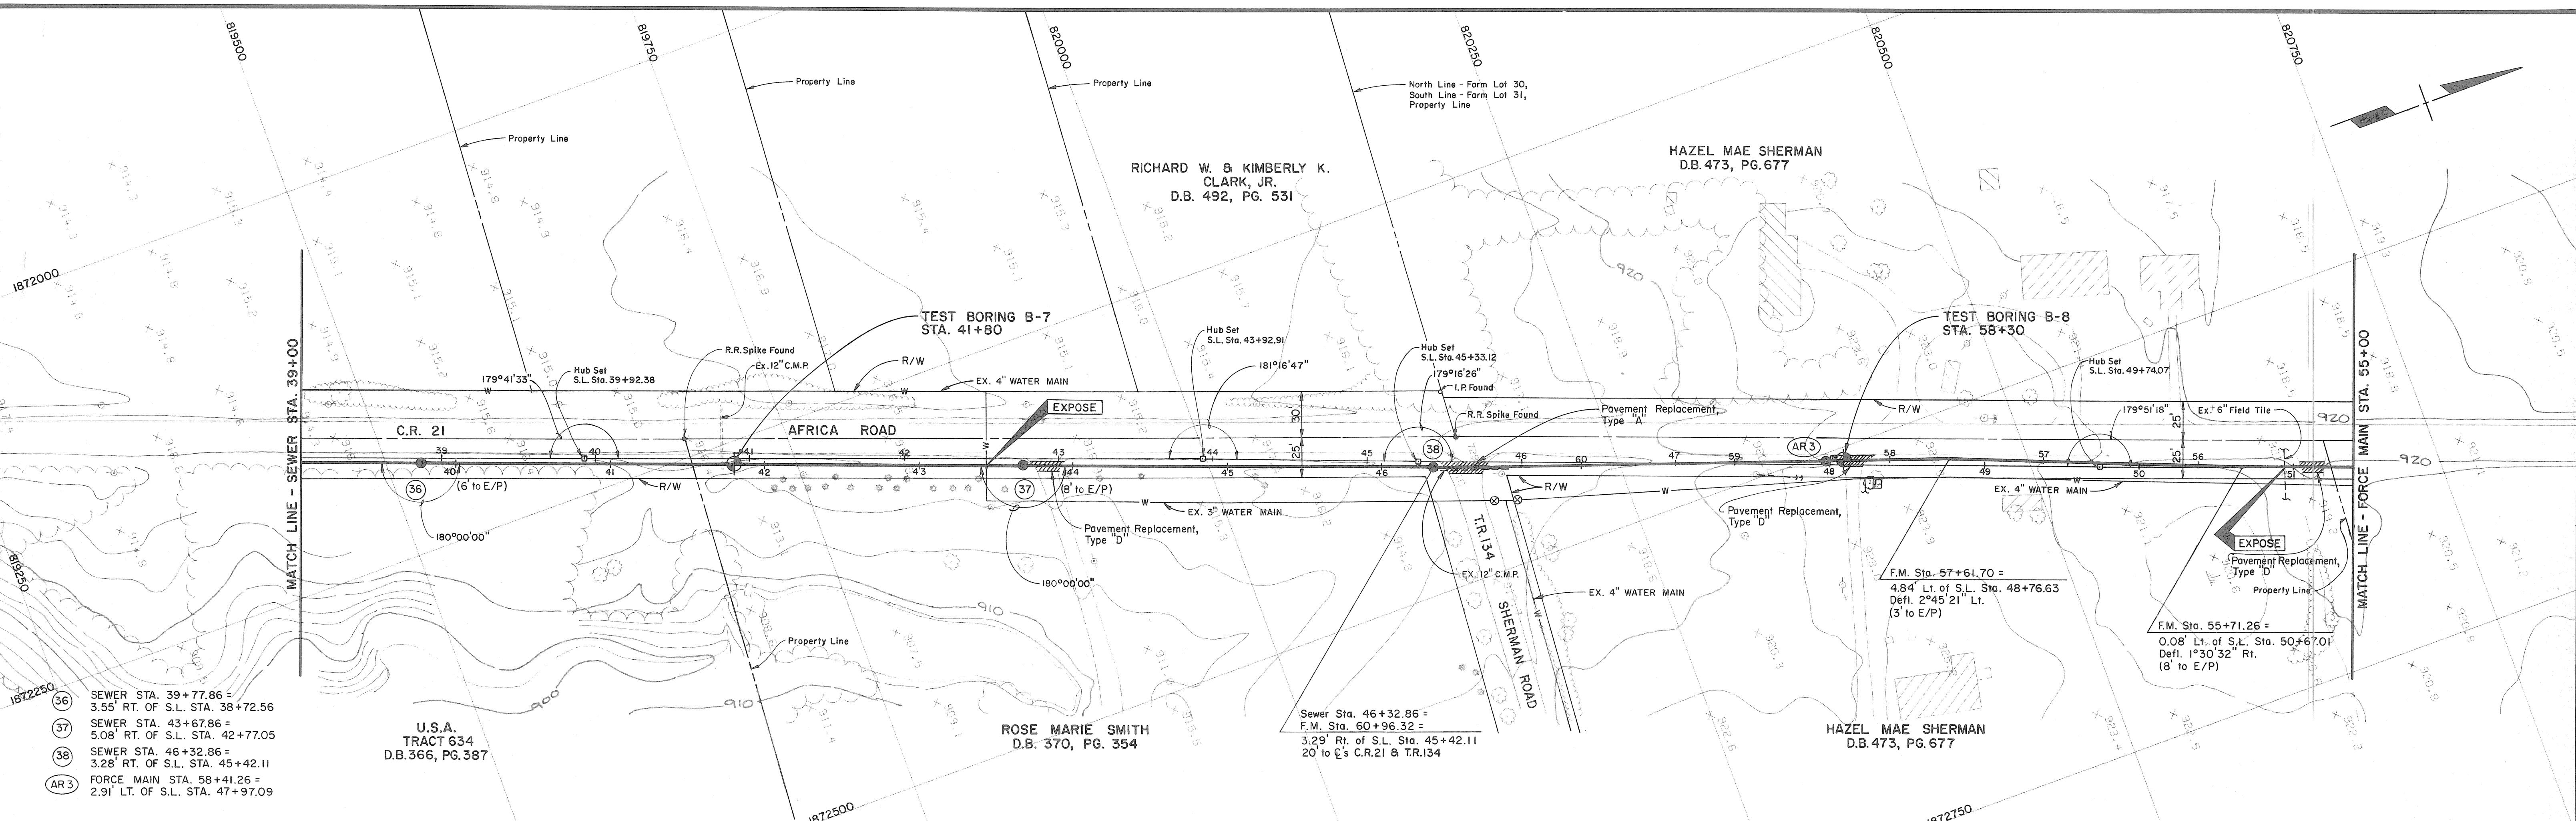




Delaware County, Ohio
**EAST ALUM CREEK INTERCEPTOR
SANITARY SEWER & PUMP STATION**
 Sanitary Sewer, Force Main and Pump Station Improvements



SCALE Horiz. 1' = 50'
 Vert. 1' = 5'
 EVANS, MECHWART, HAMBLETON & TILTON, INC.
 CONSULTING ENGINEERS & SURVEYORS

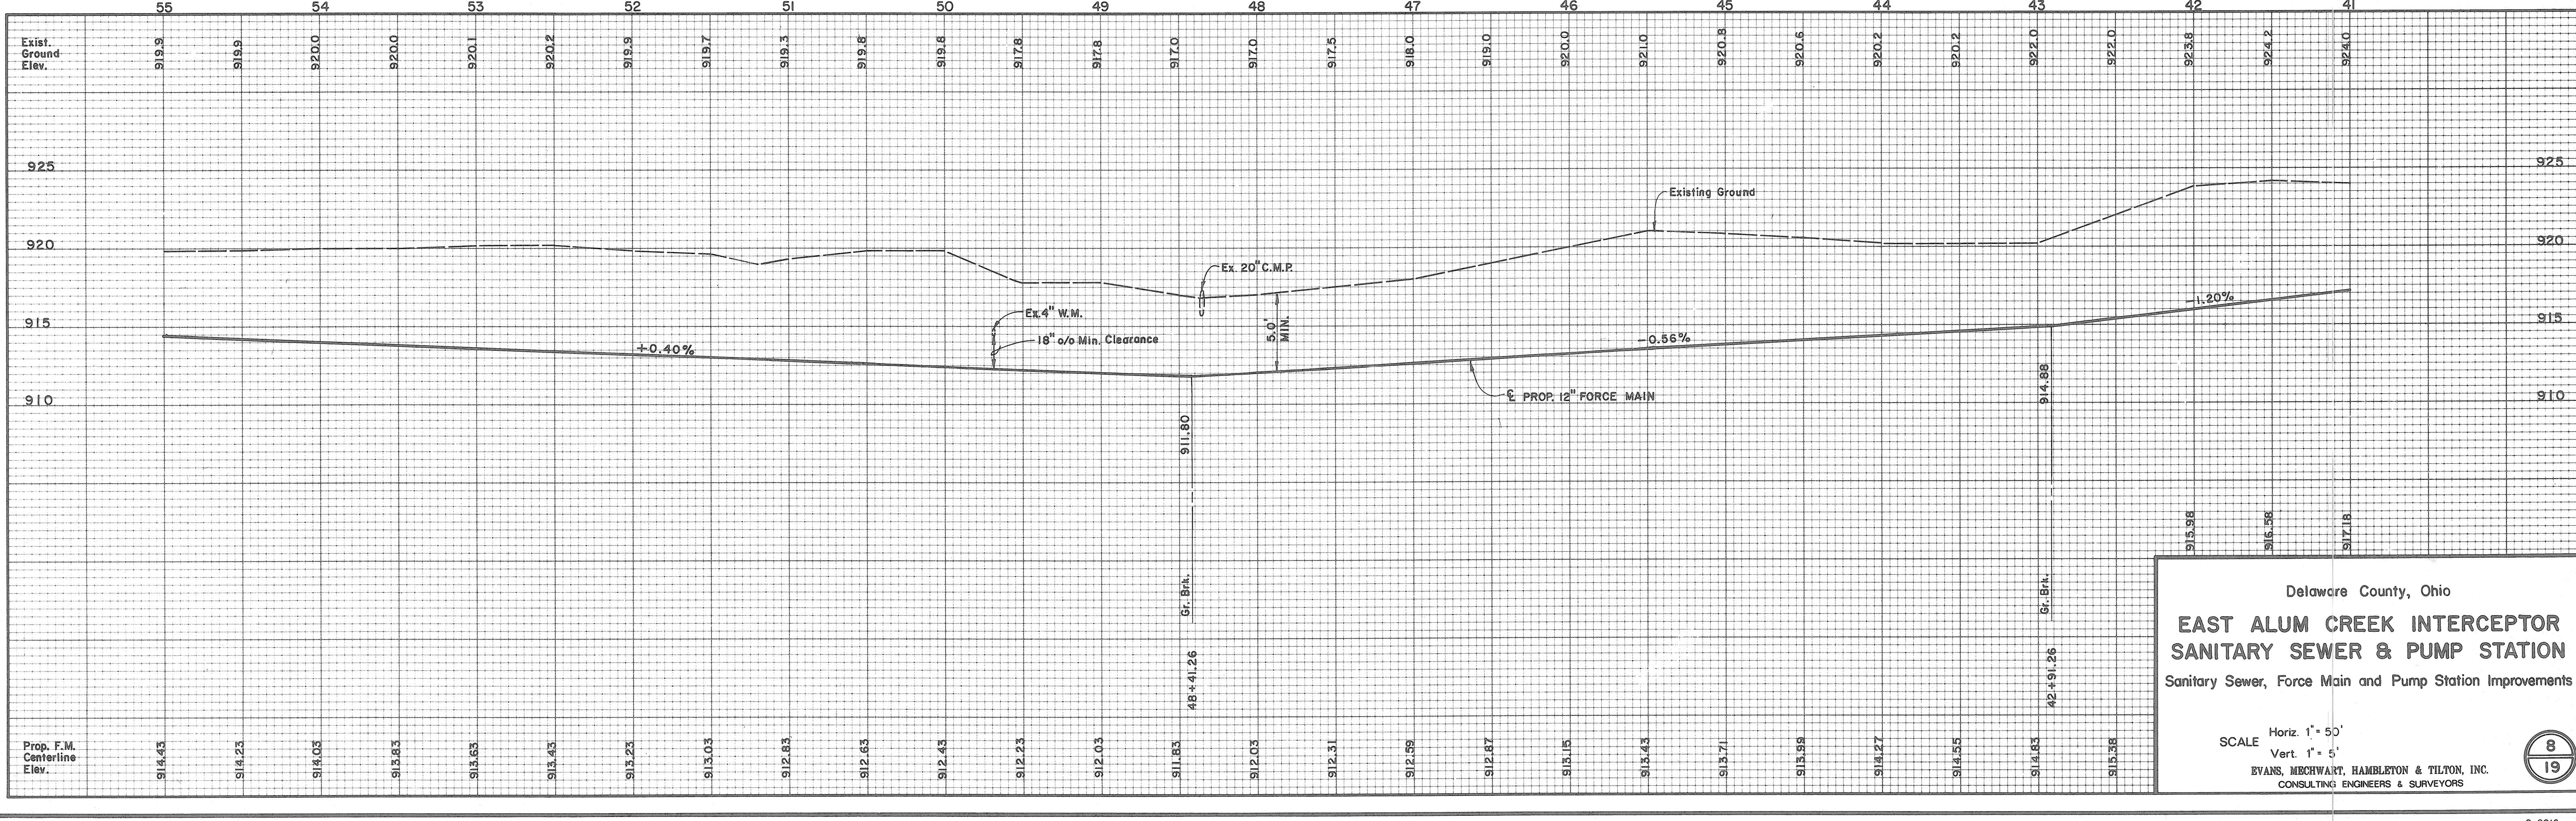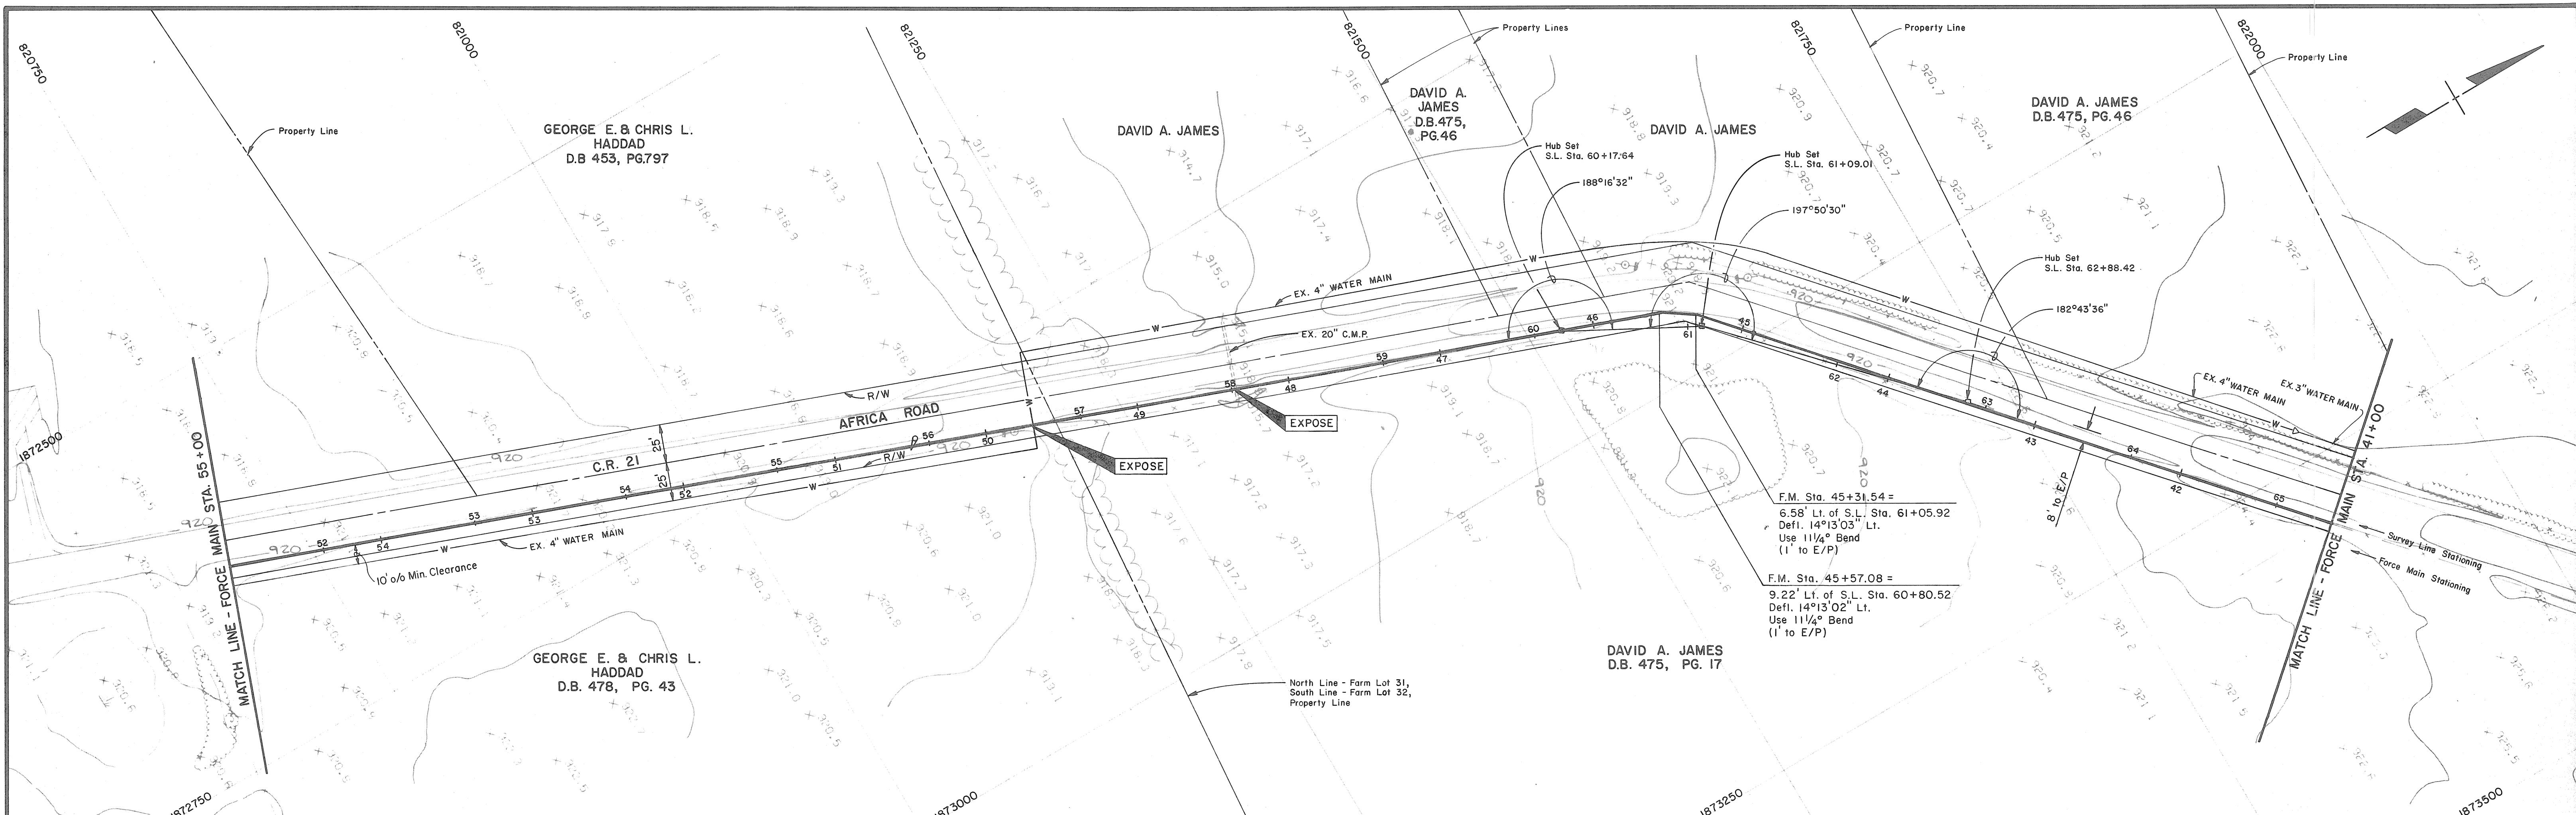

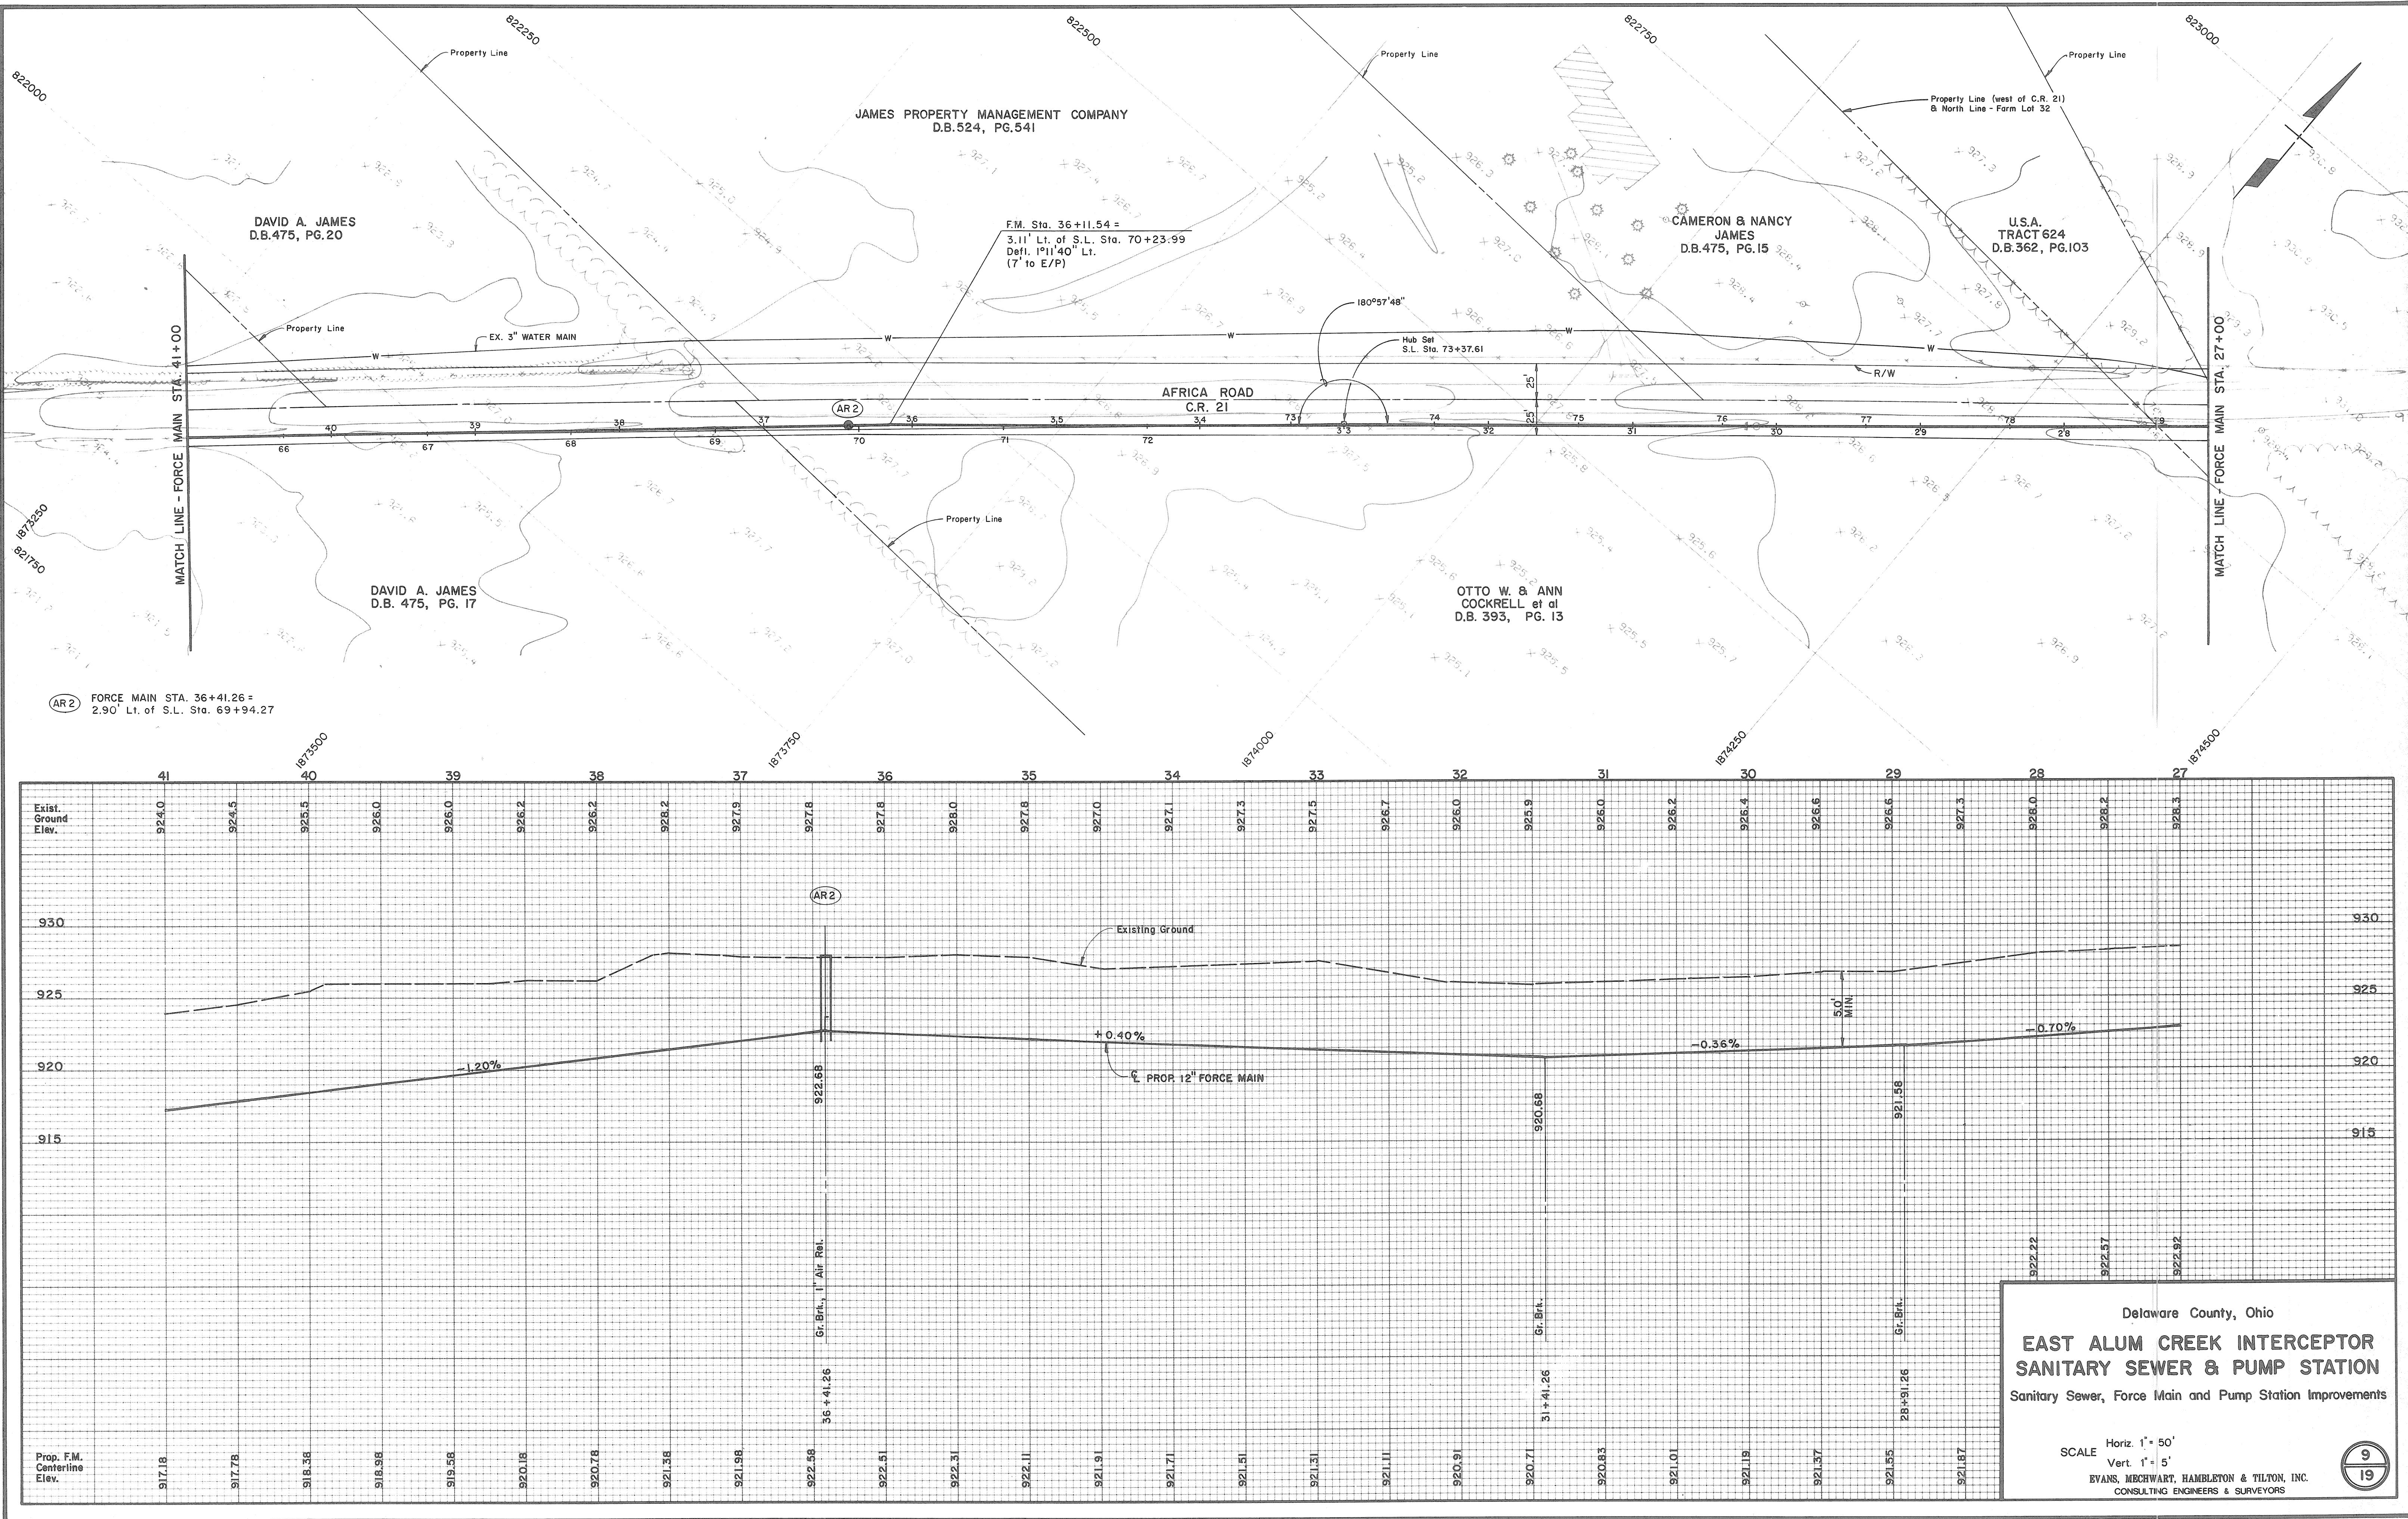

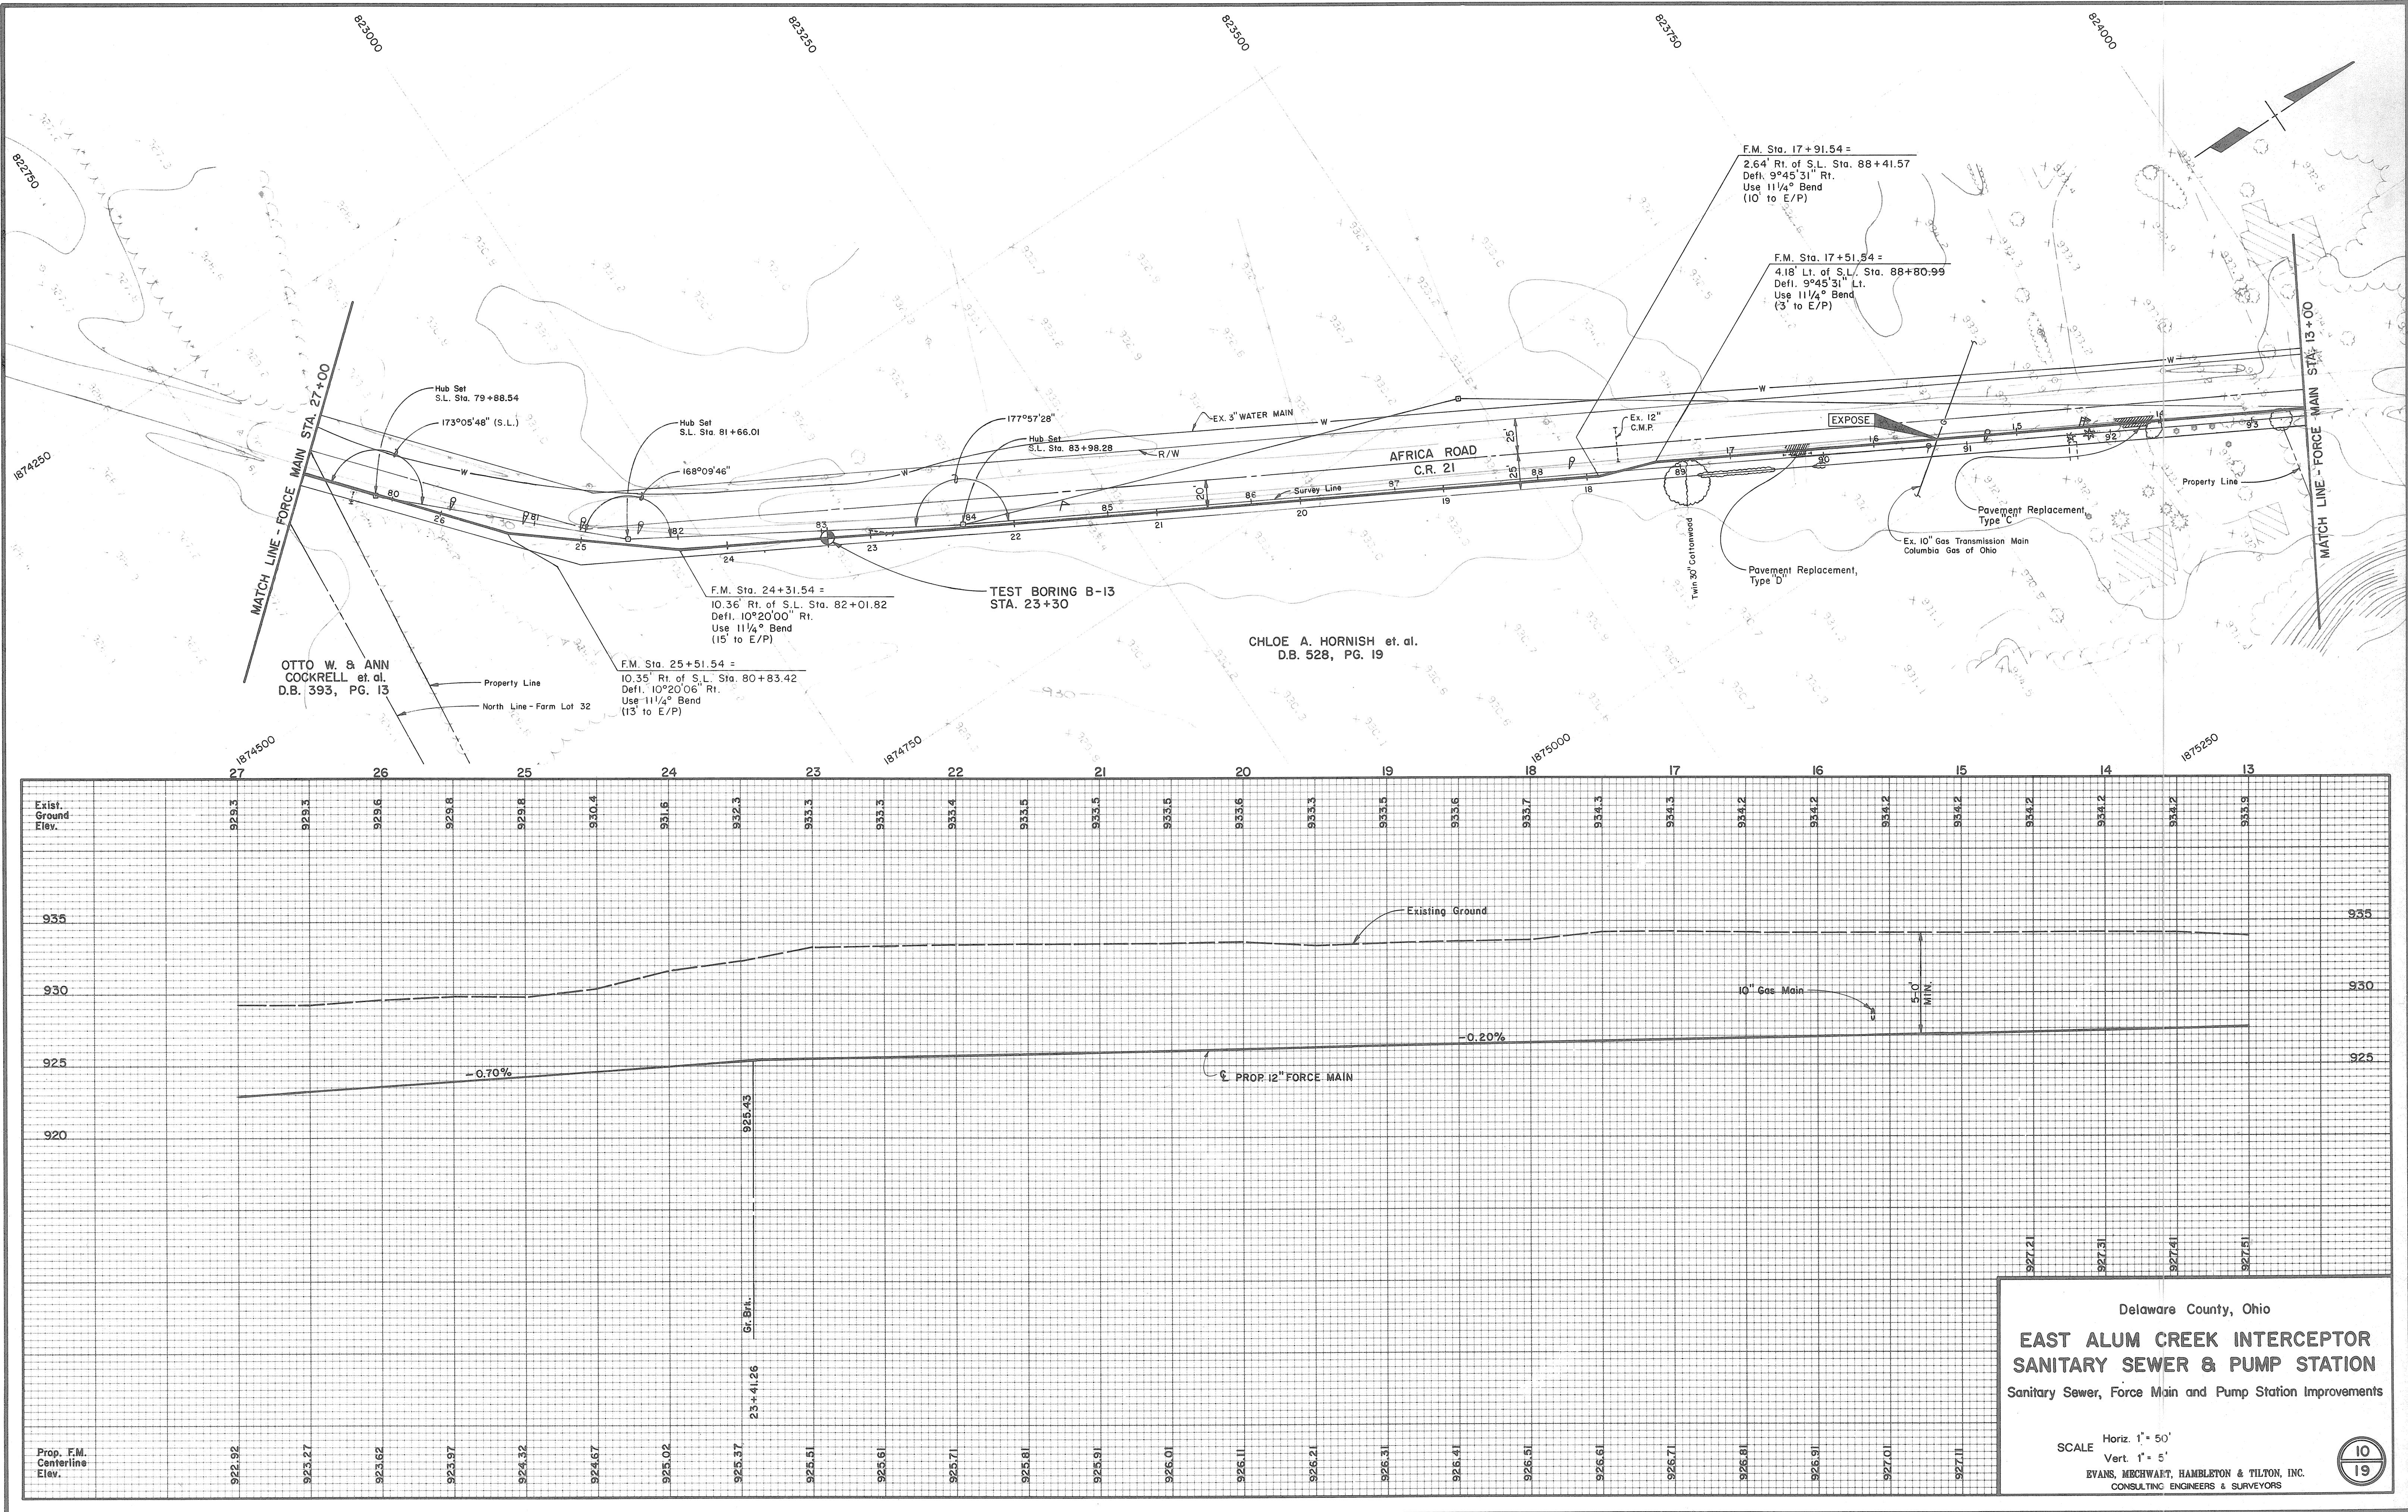

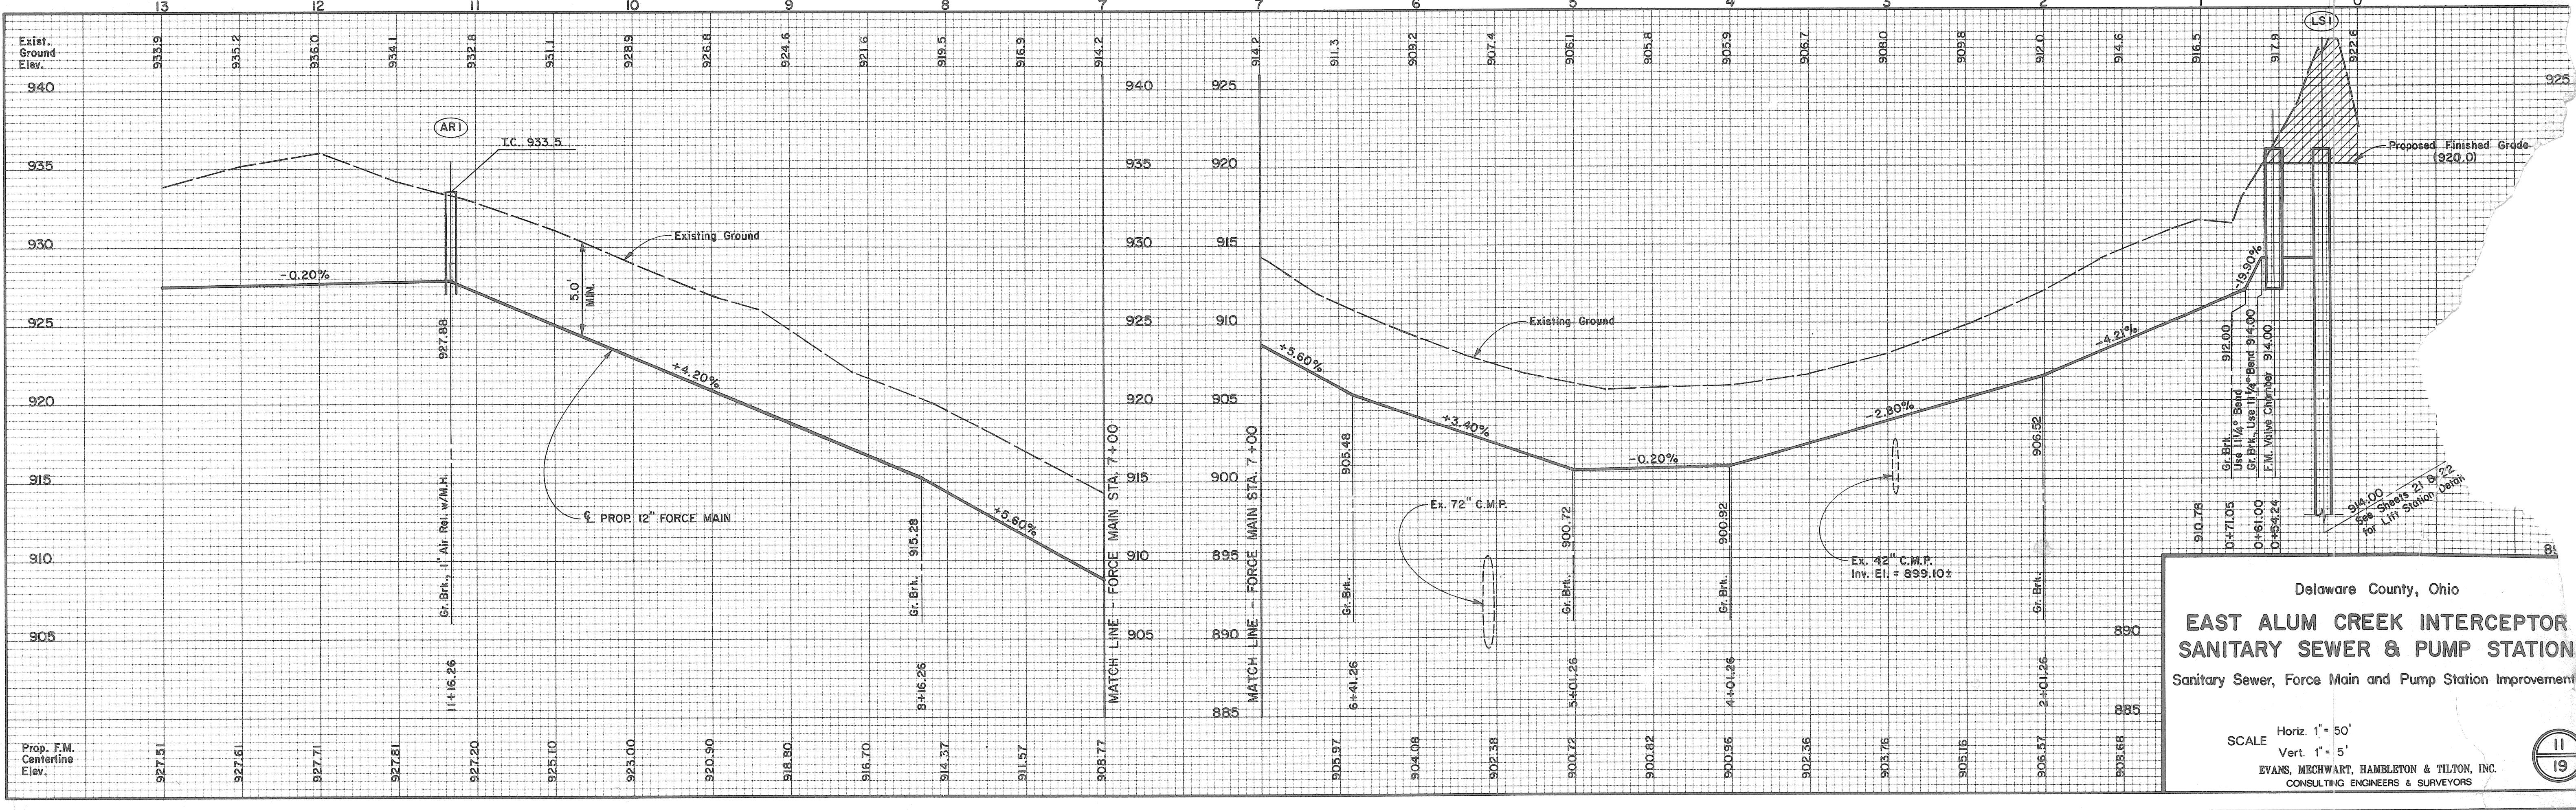
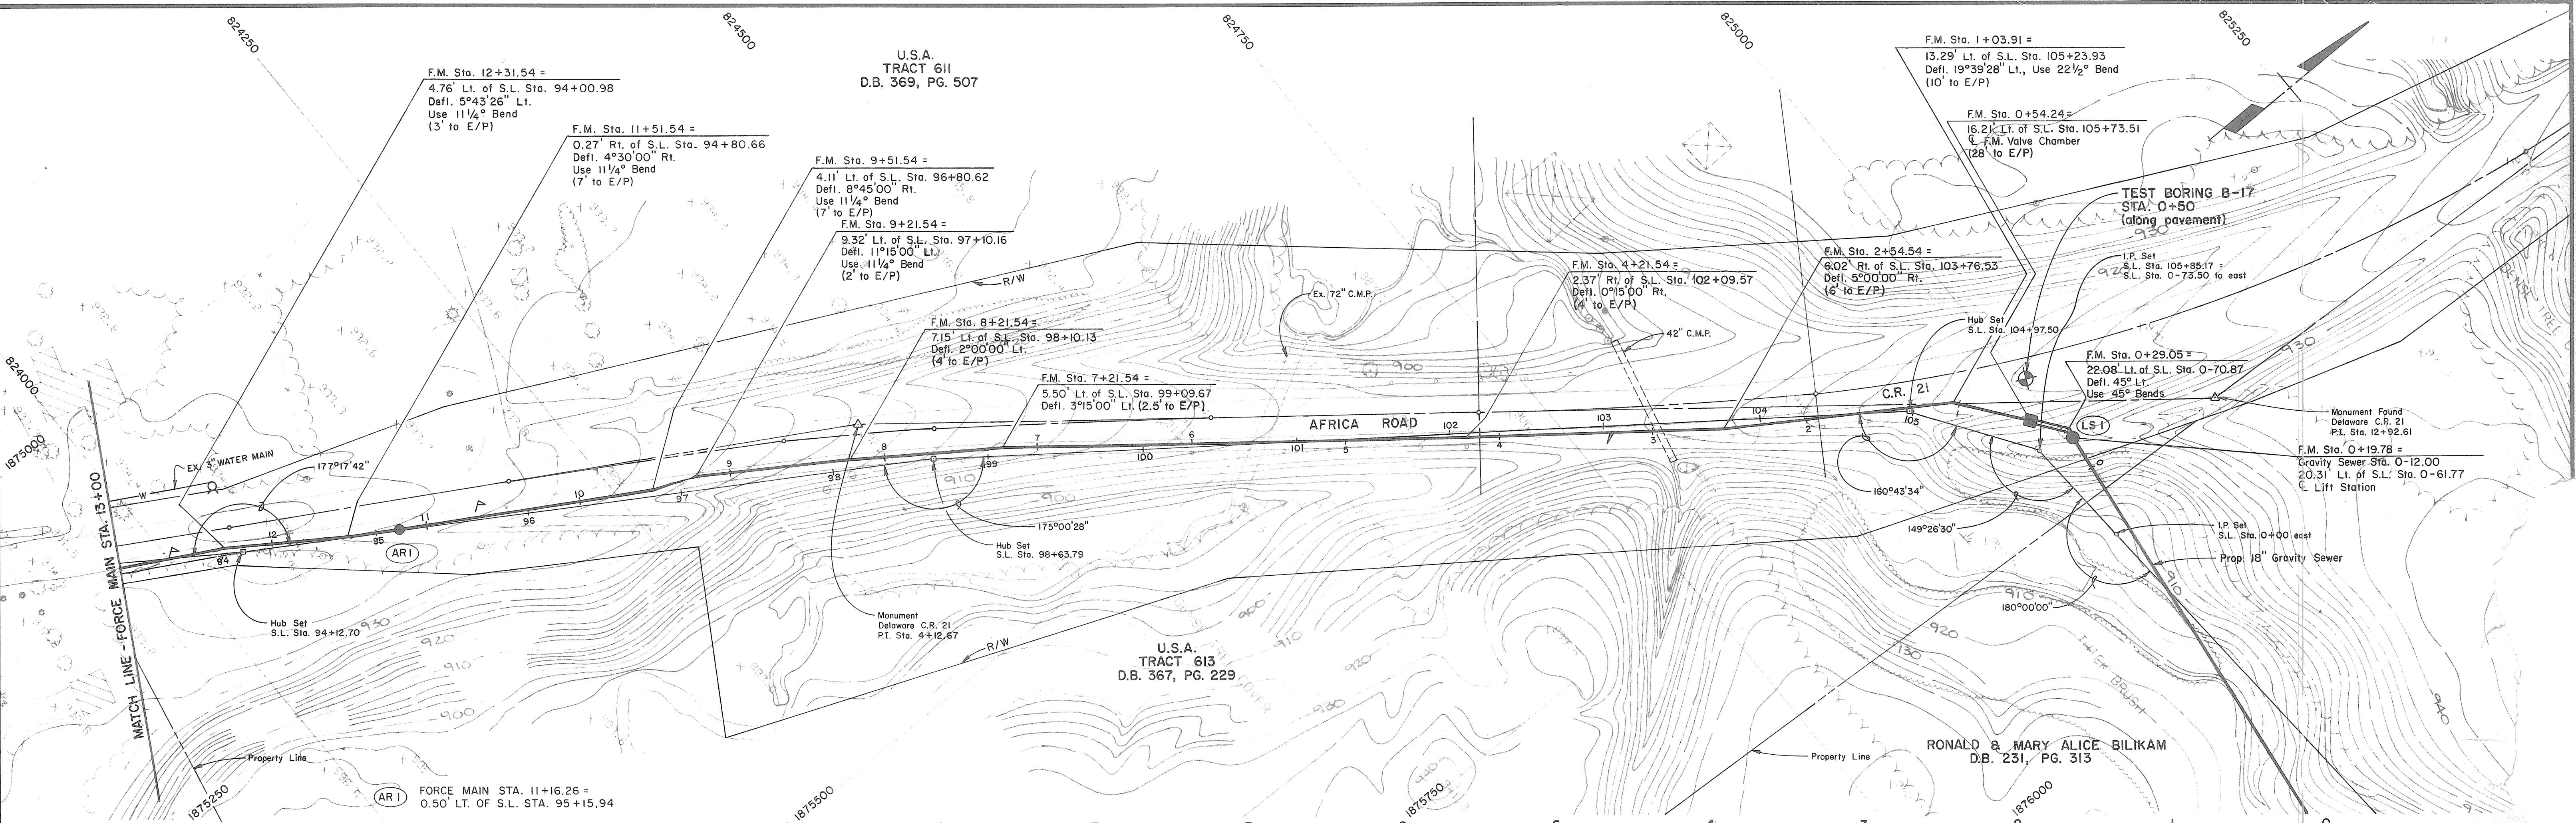


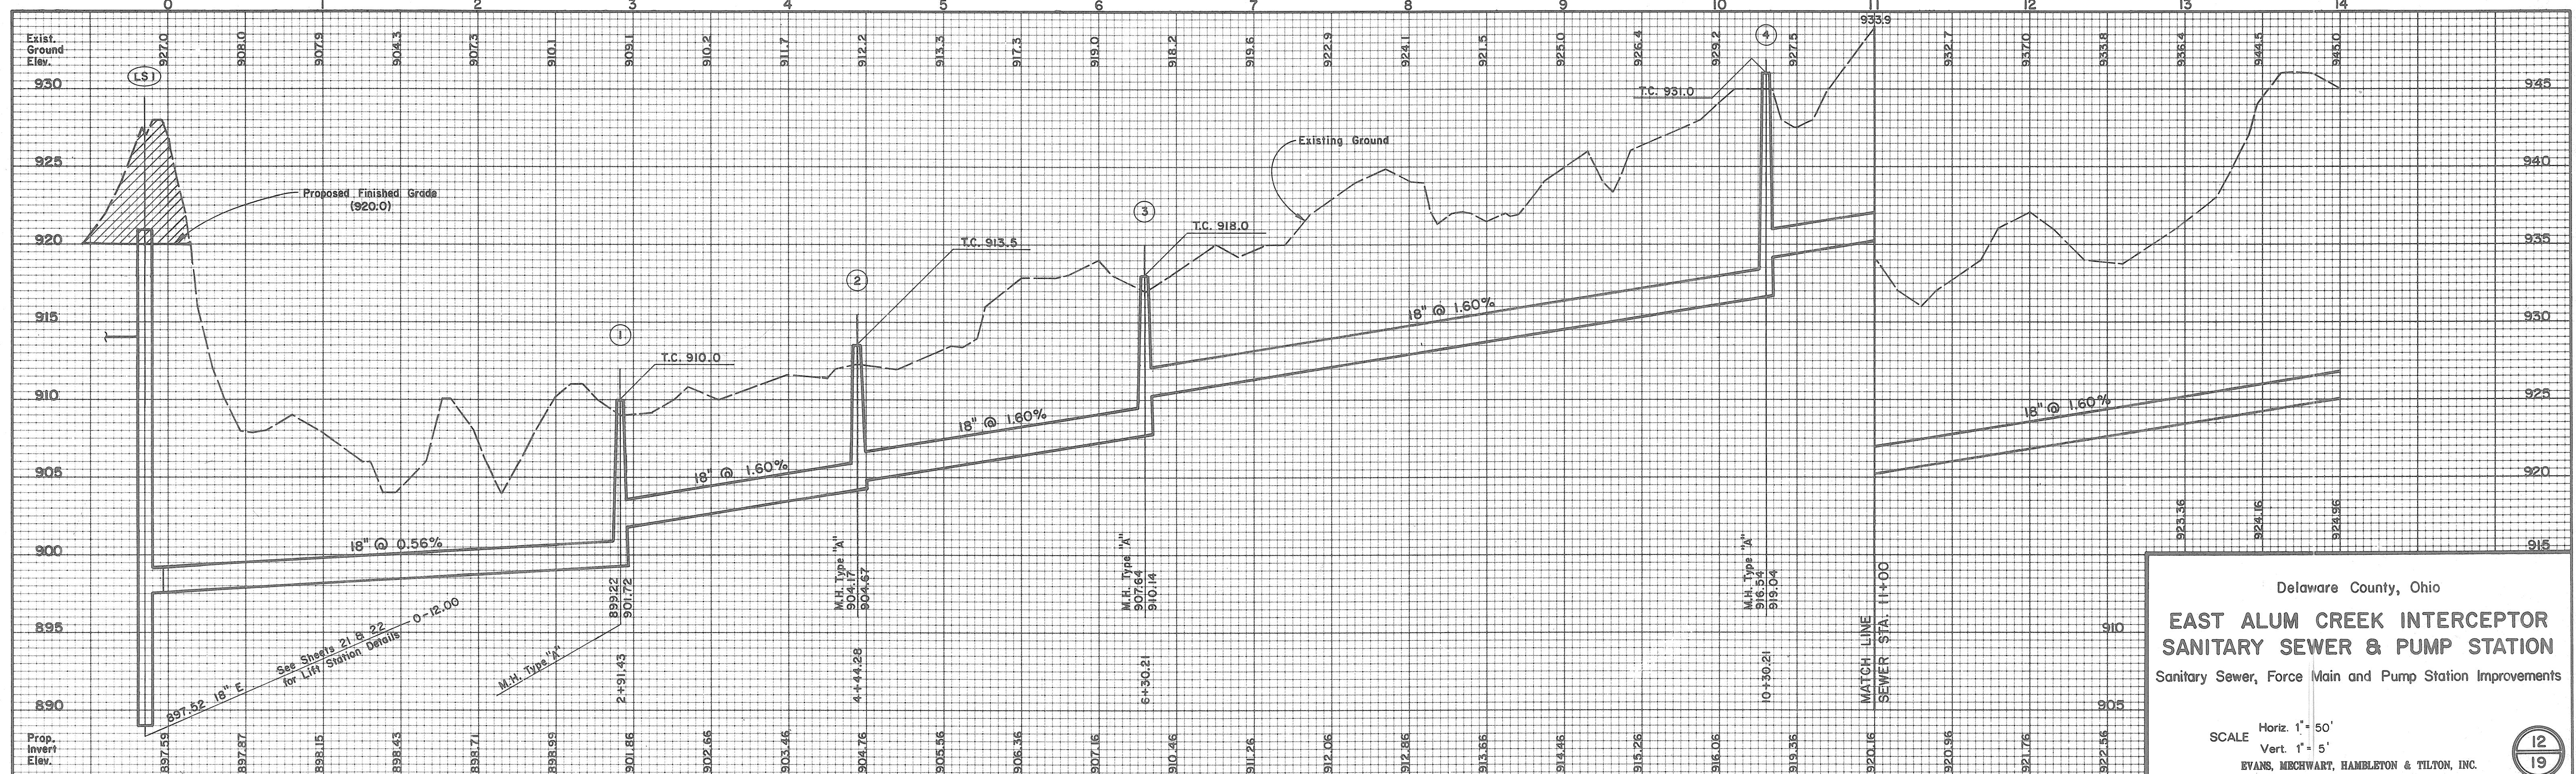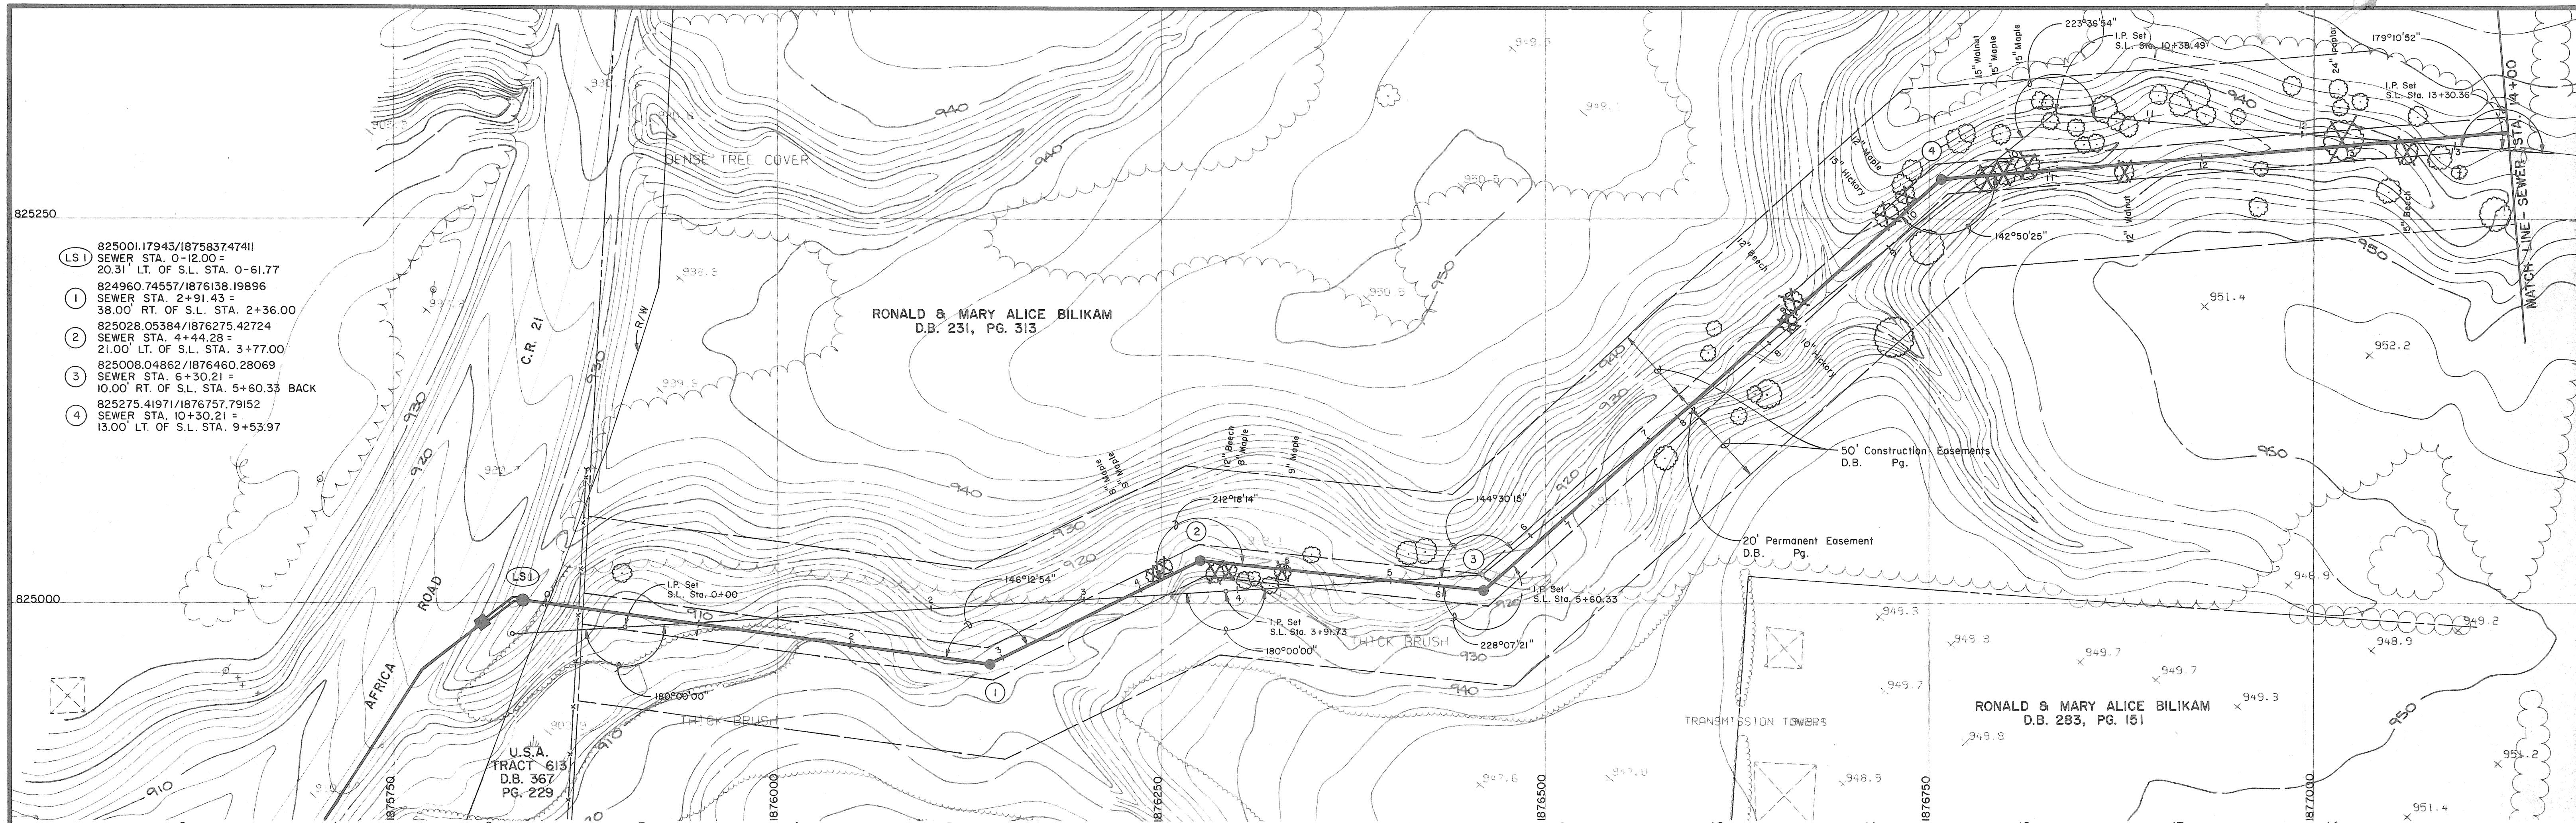




Delaware County, Ohio
EAST ALUM CREEK INTERCEPTOR
SANITARY SEWER & PUMP STATION
Sanitary Sewer, Force Main and Pump Station Improvements



SCALE Horiz. 1" = 50'
Vert. 1" = 5'
EVANS, McDOWELL, HAMILTON & TILTON, INC.
CONSULTING ENGINEERS & SURVEYORS

12
19

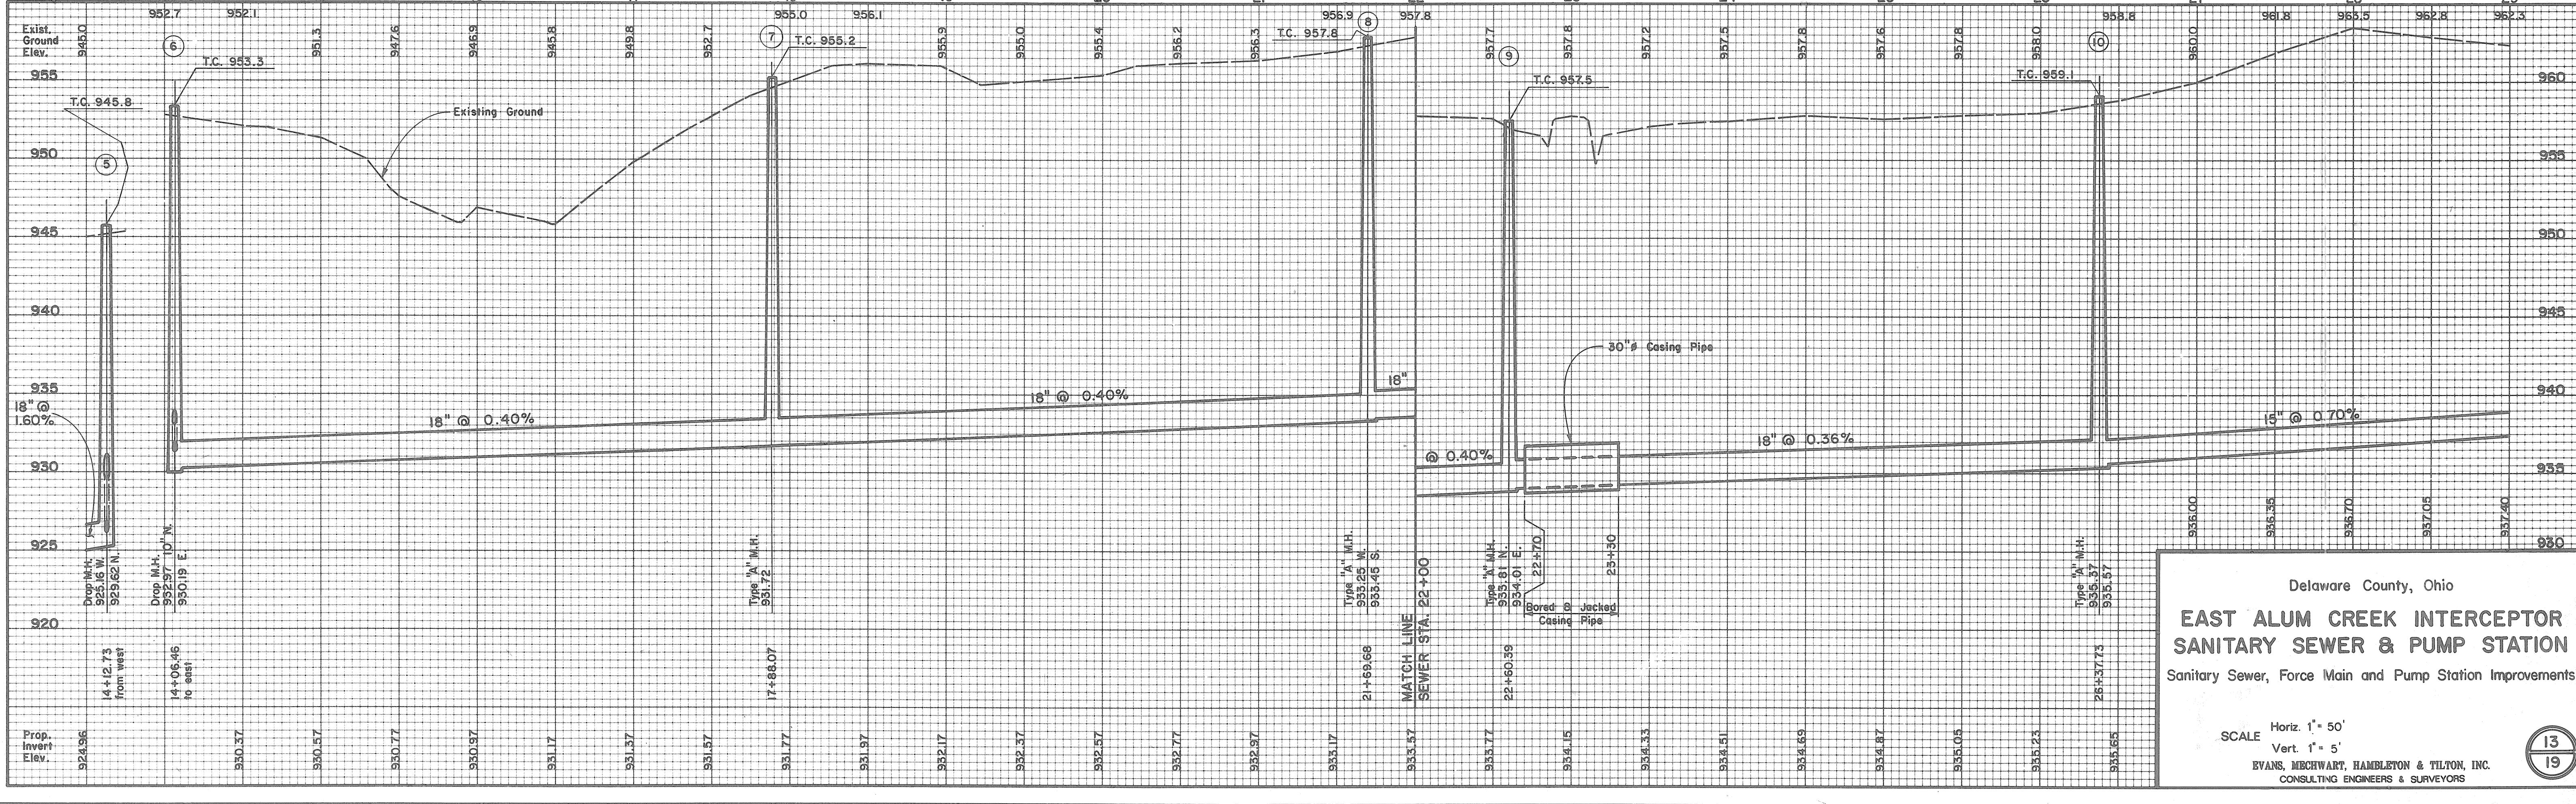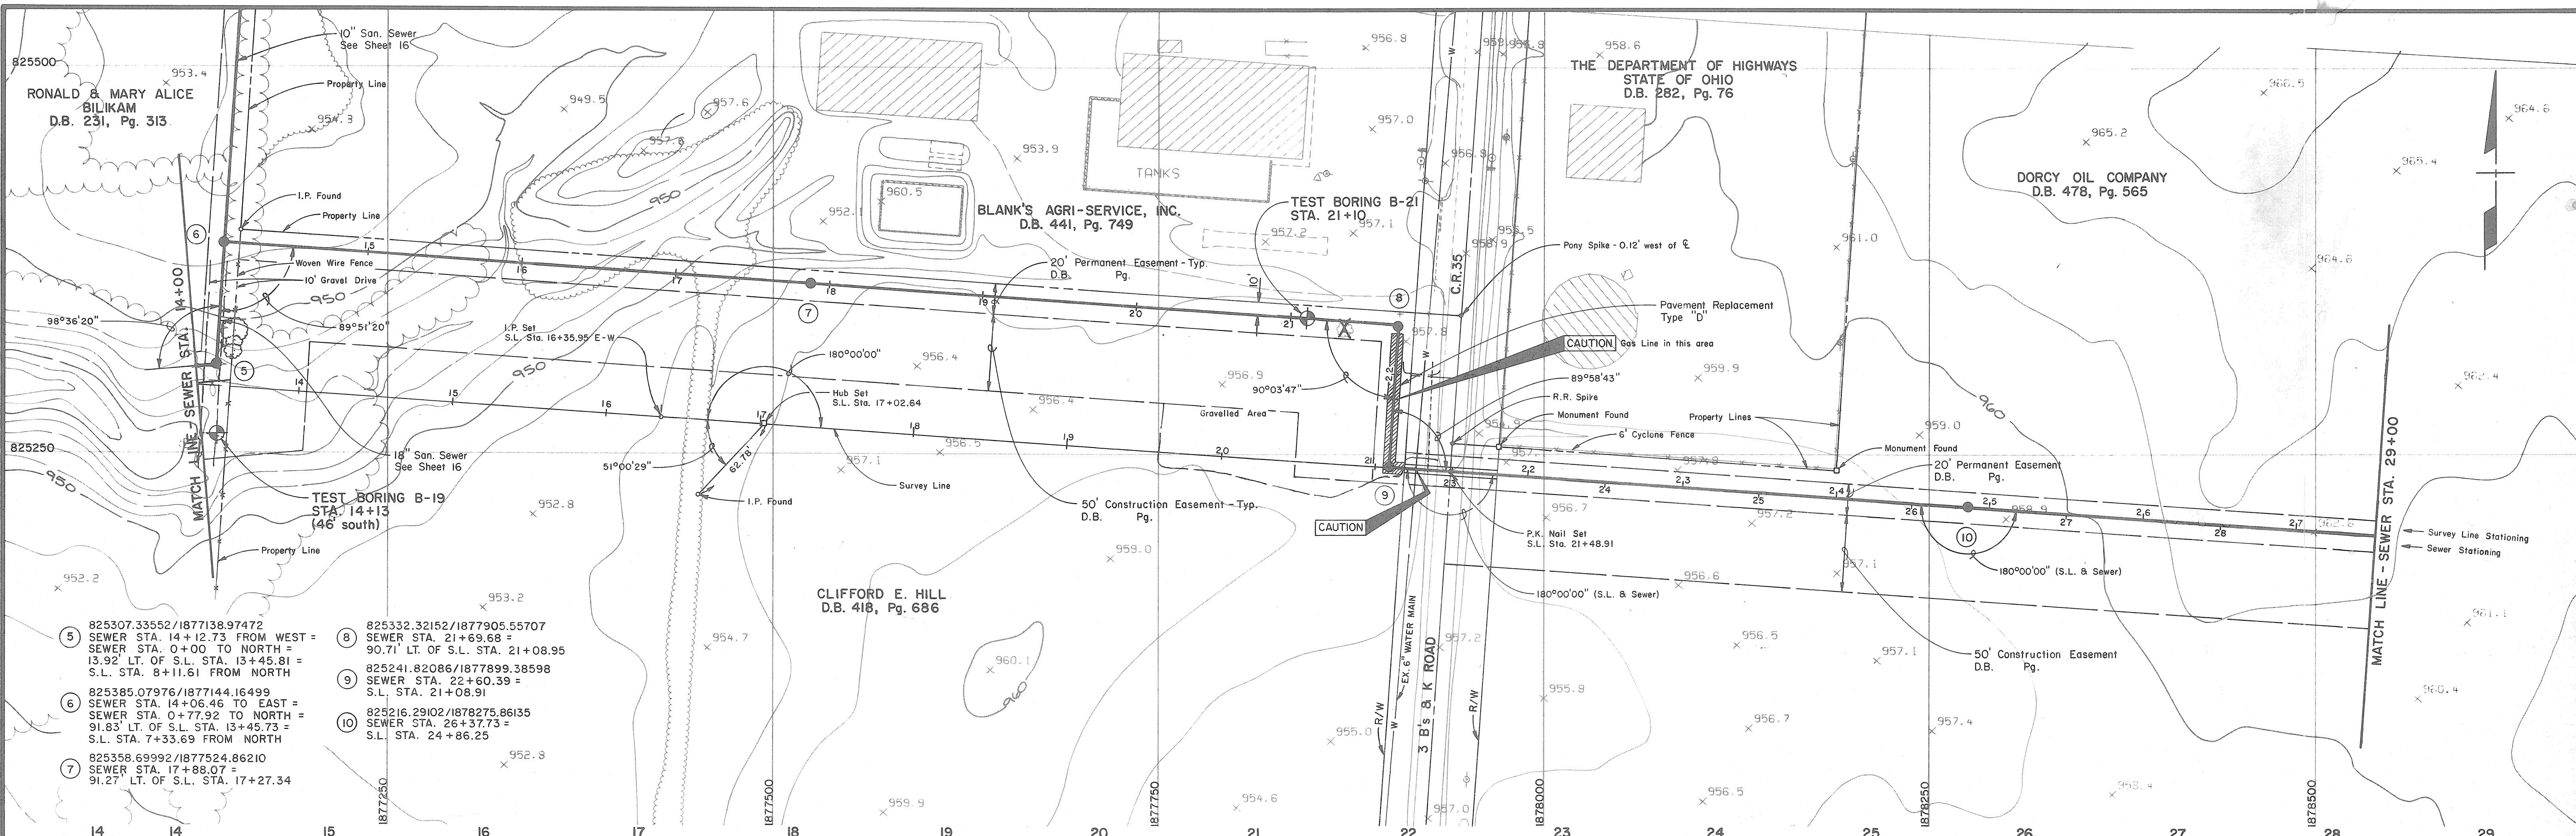

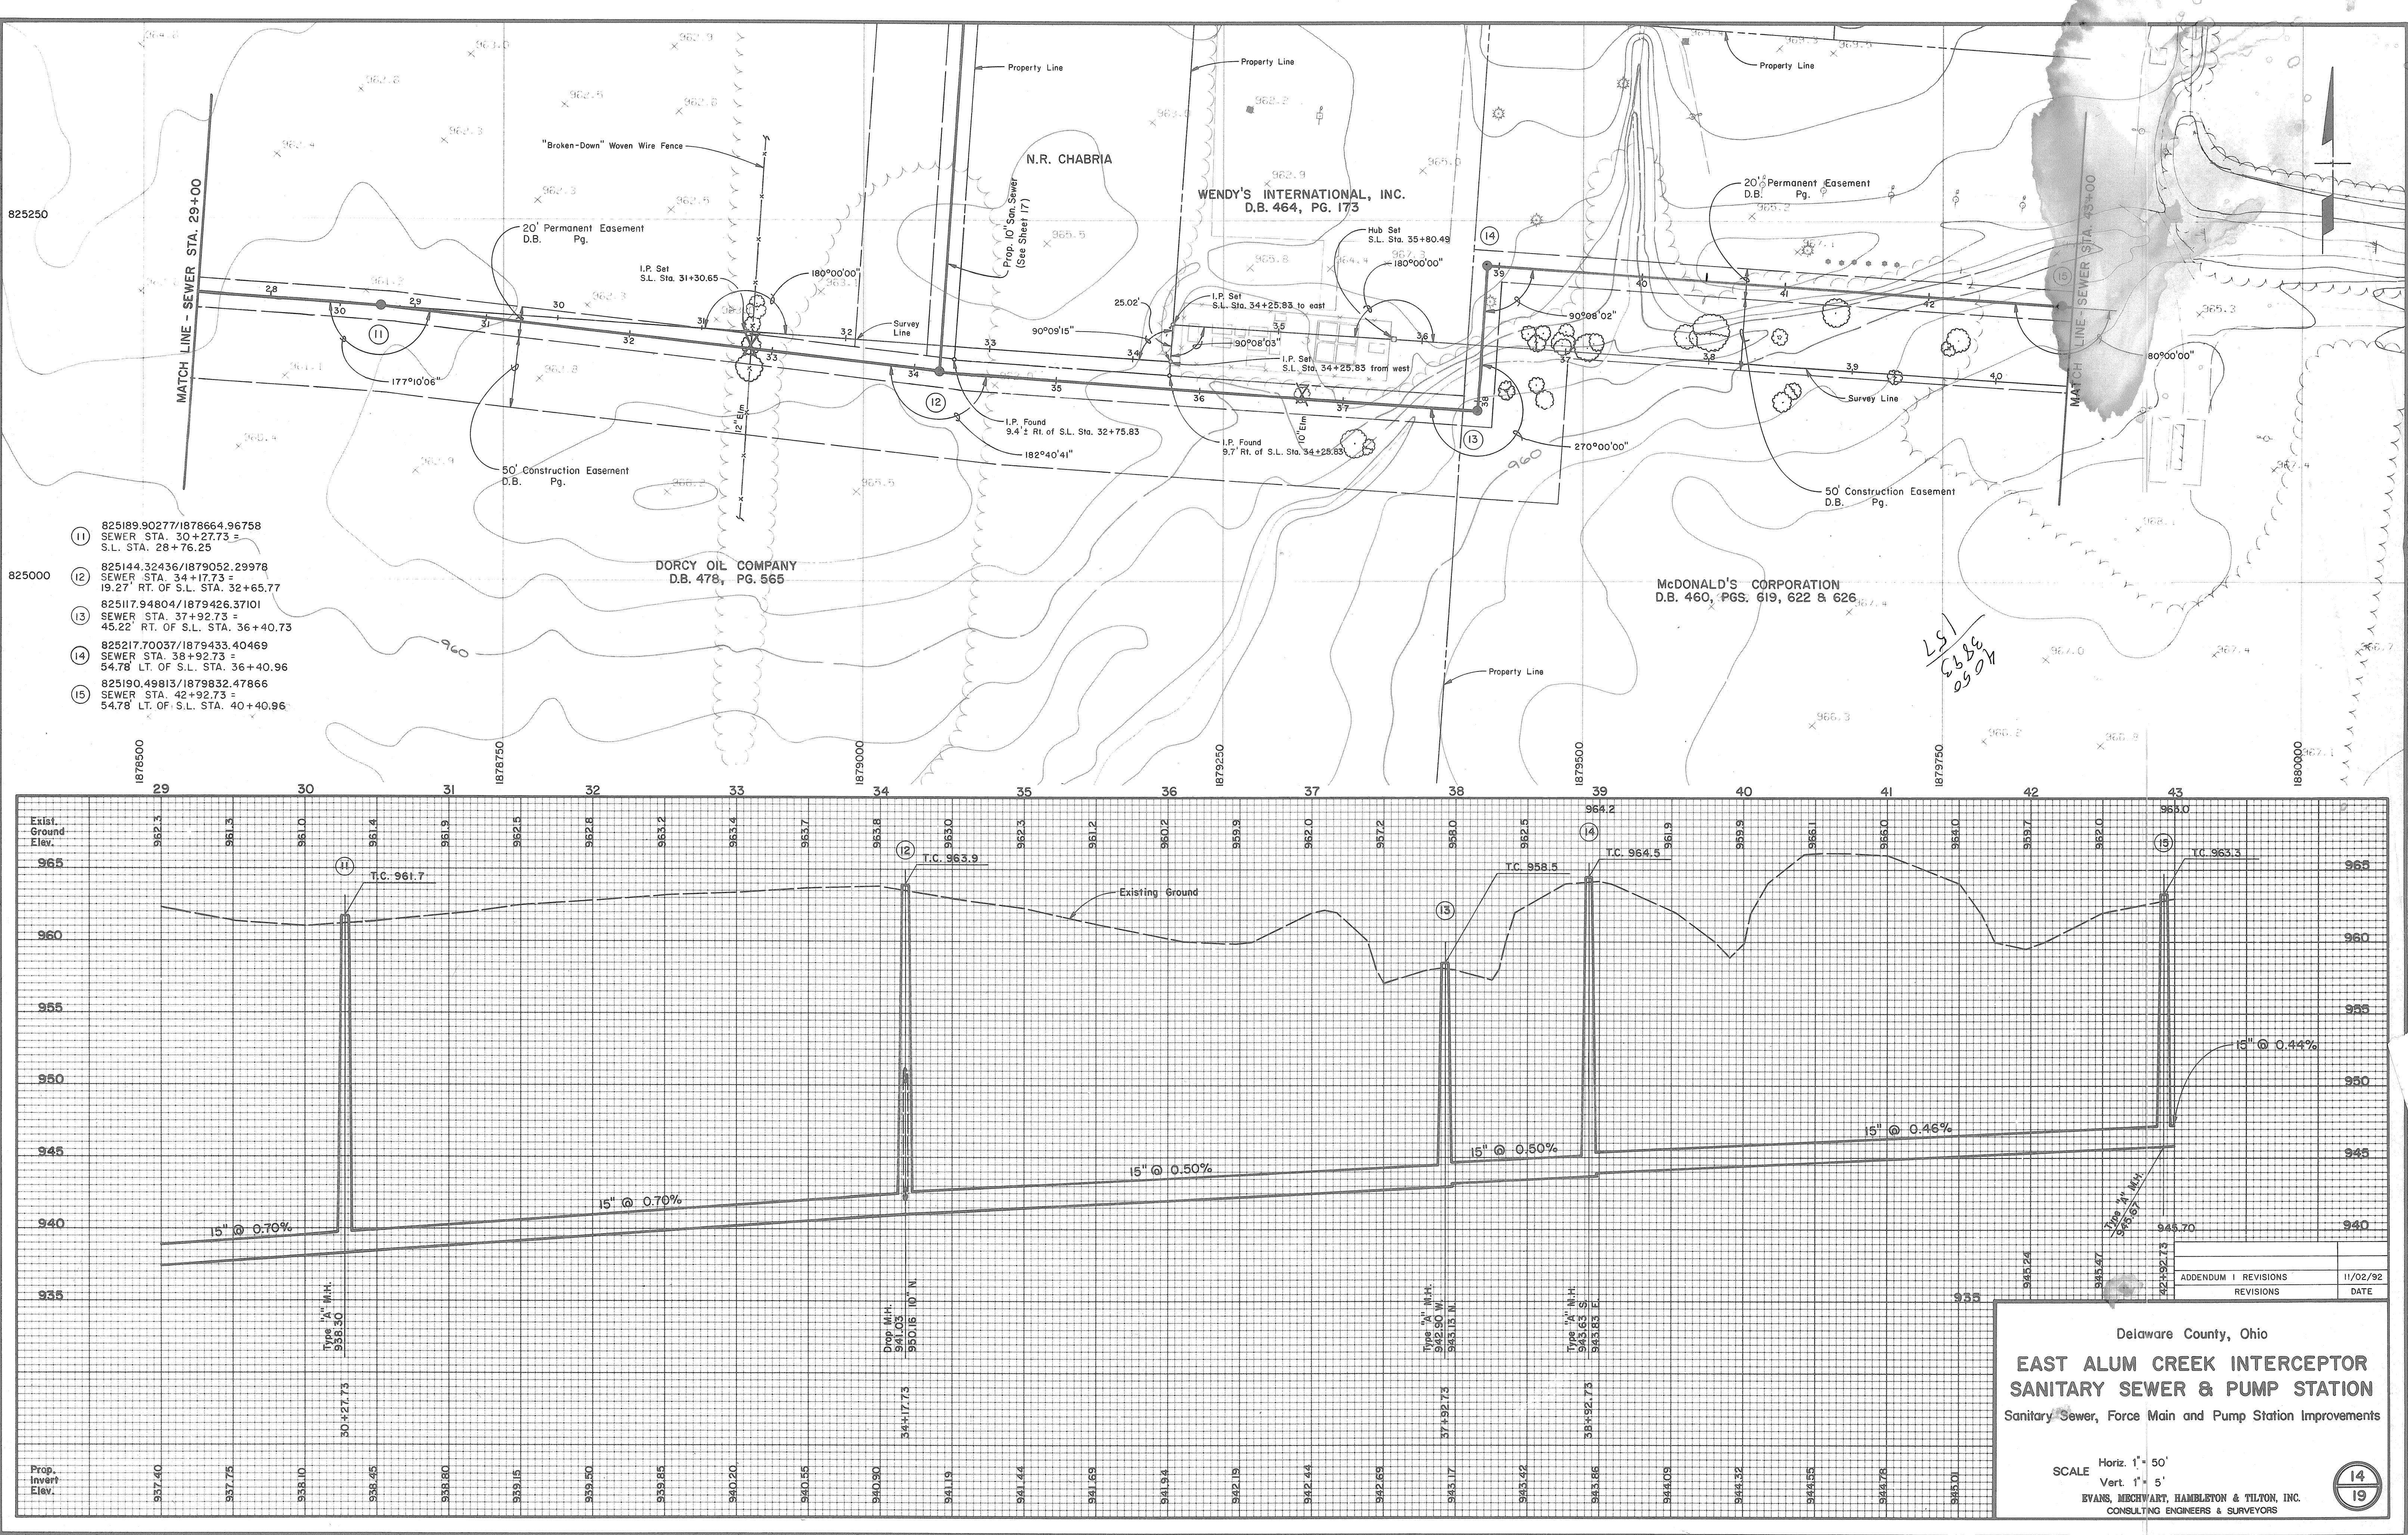

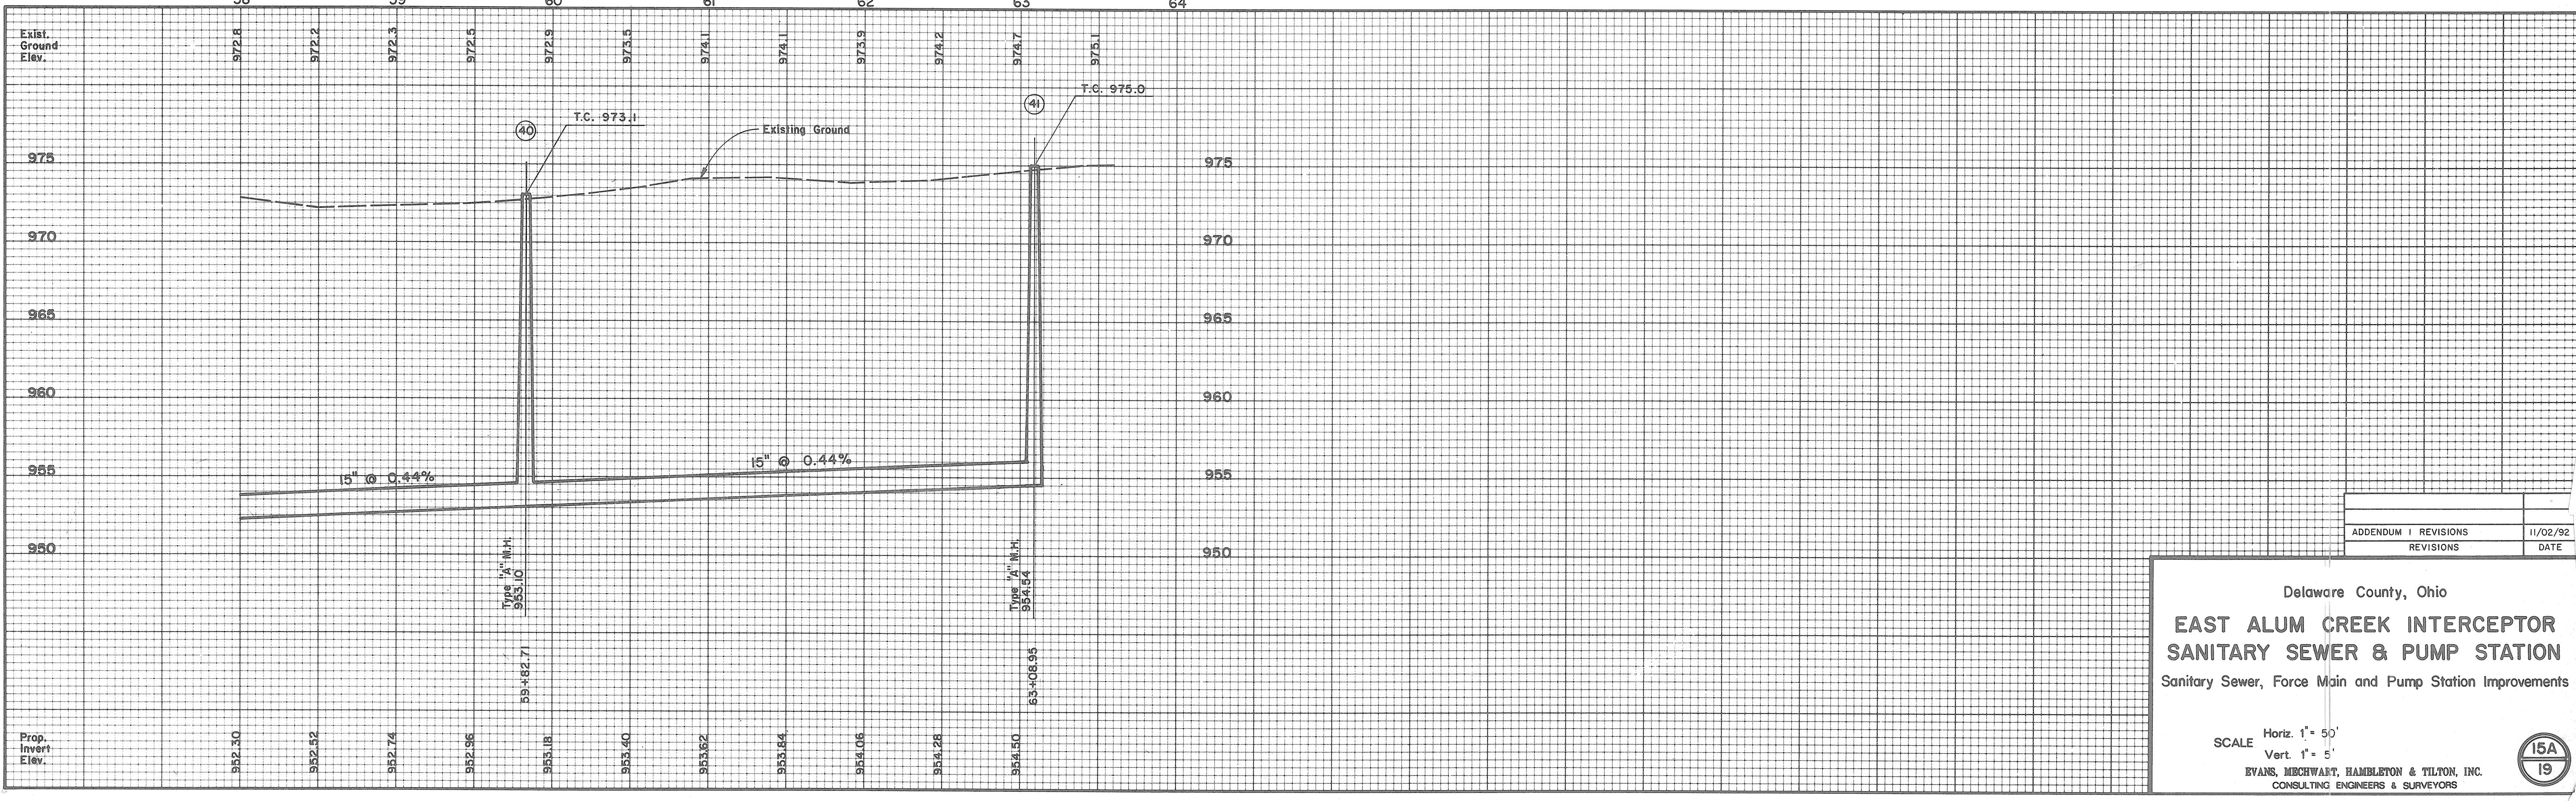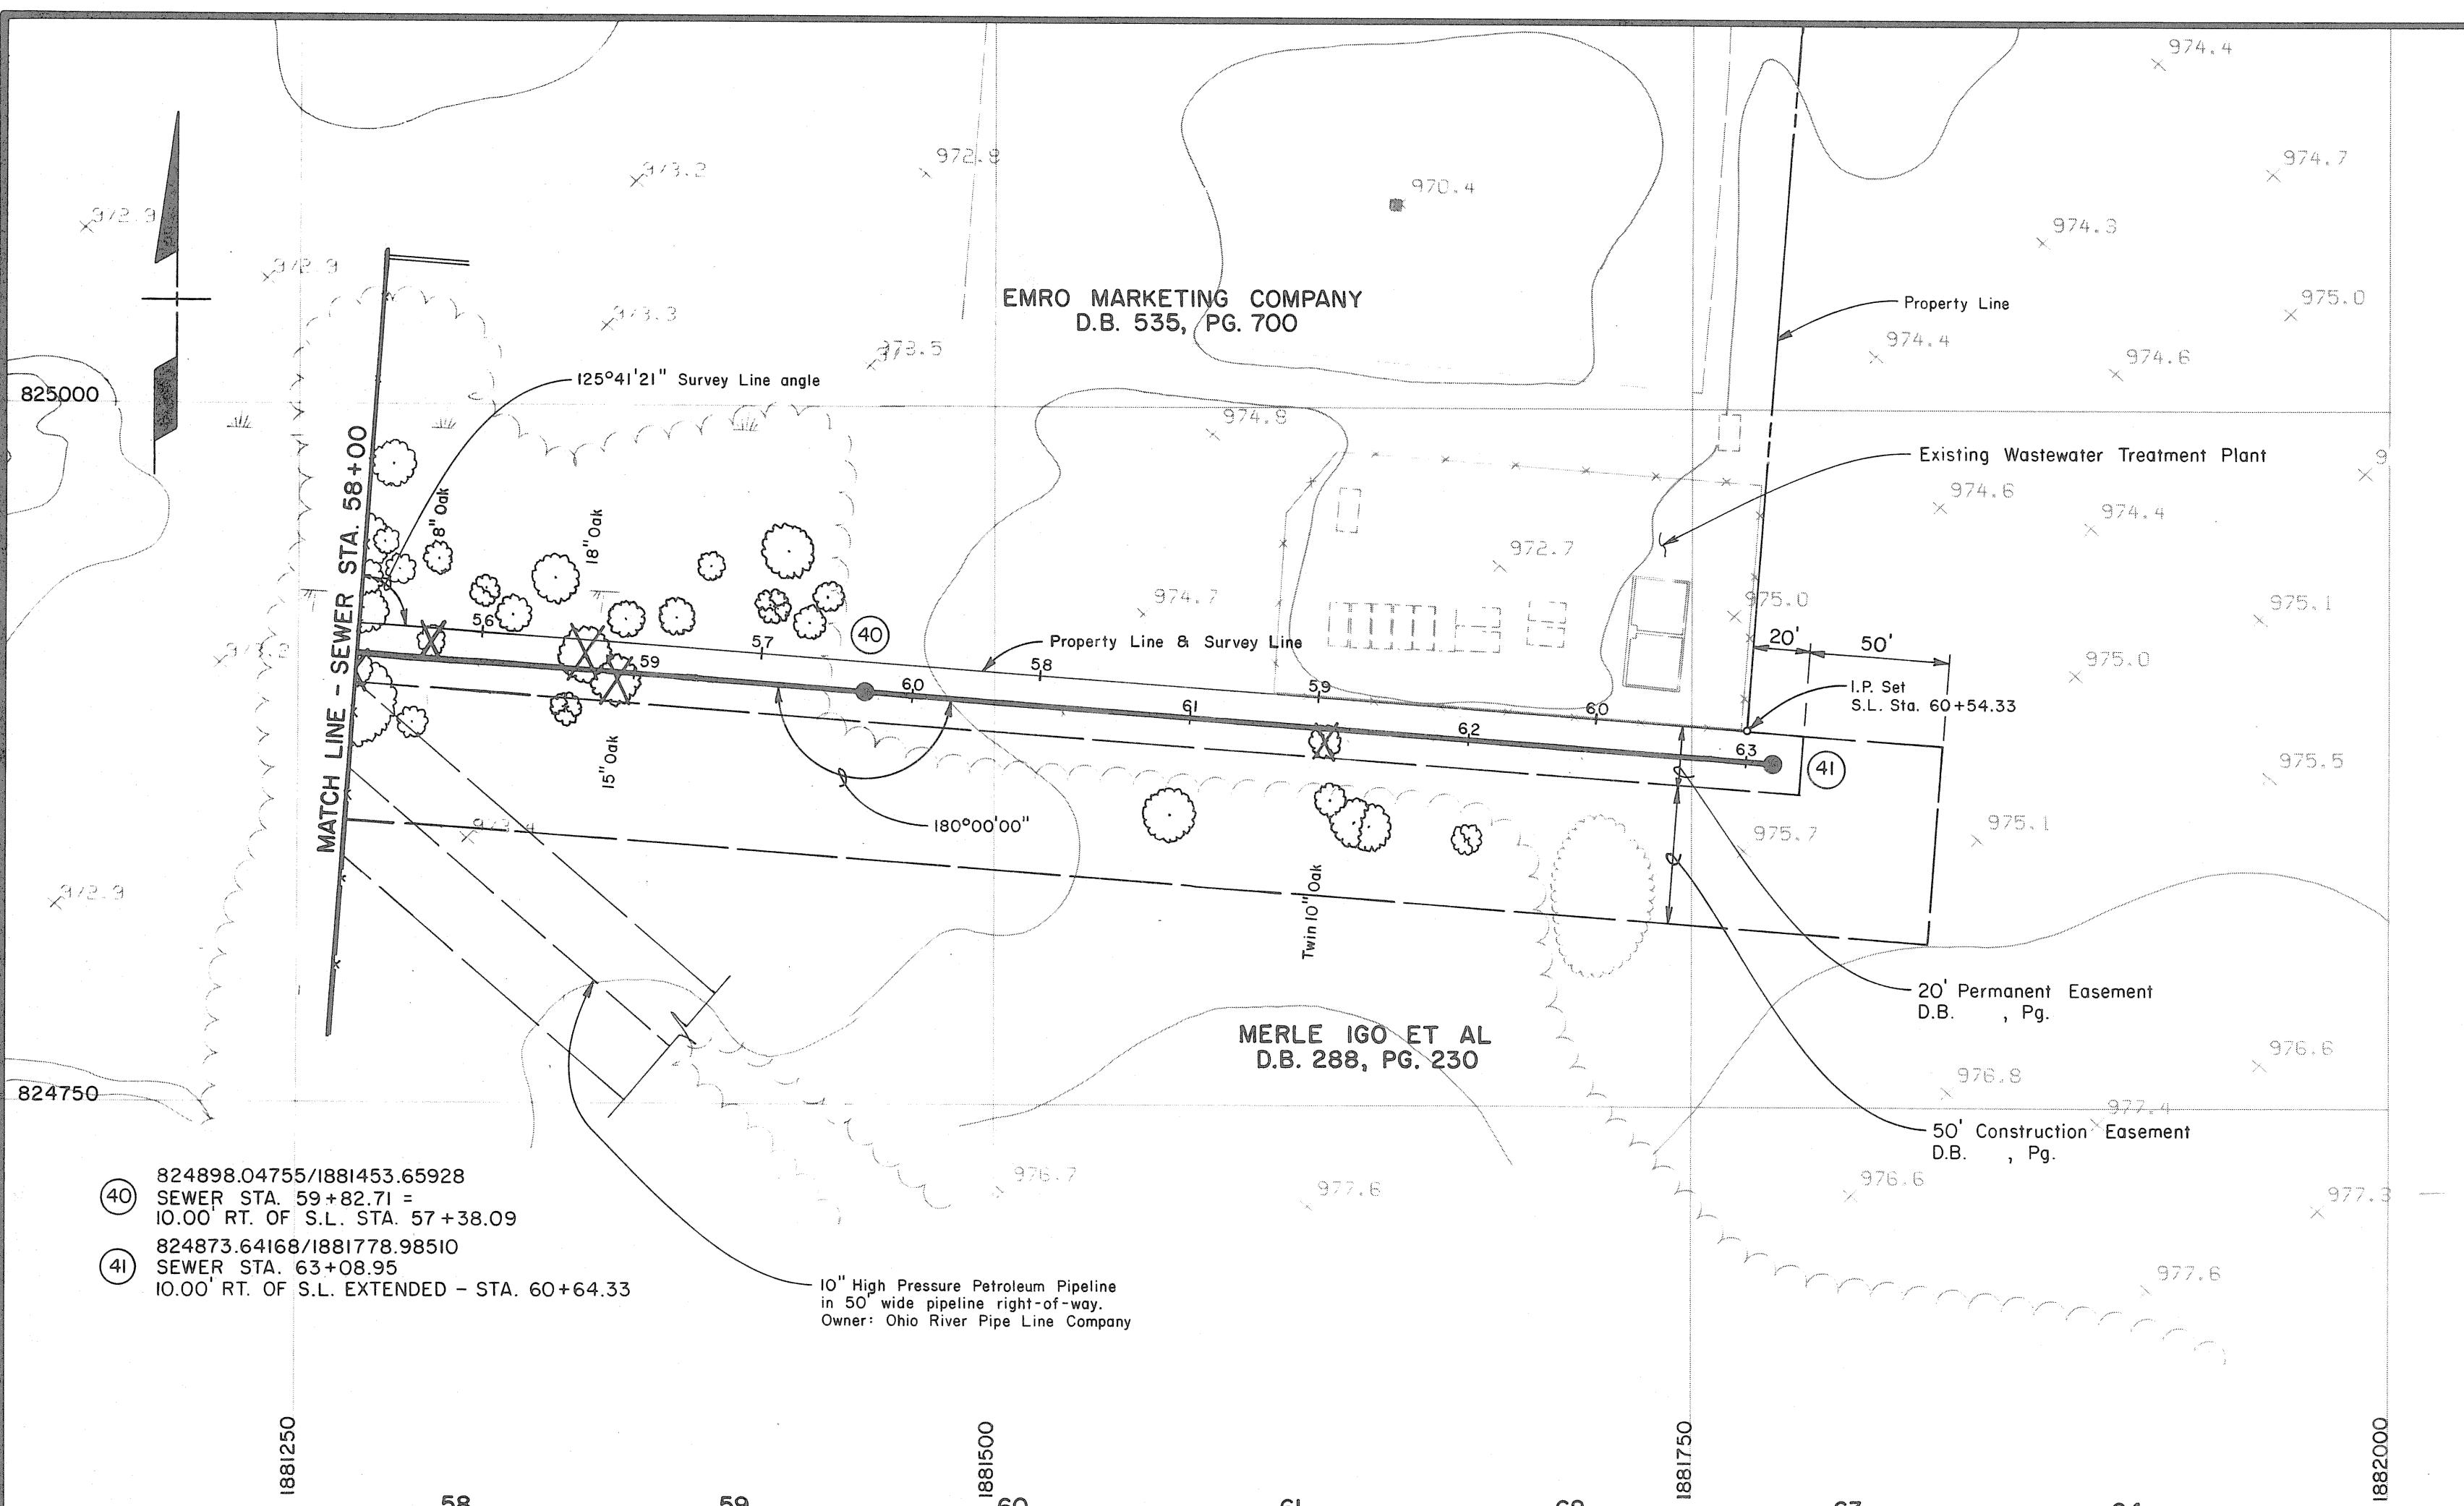

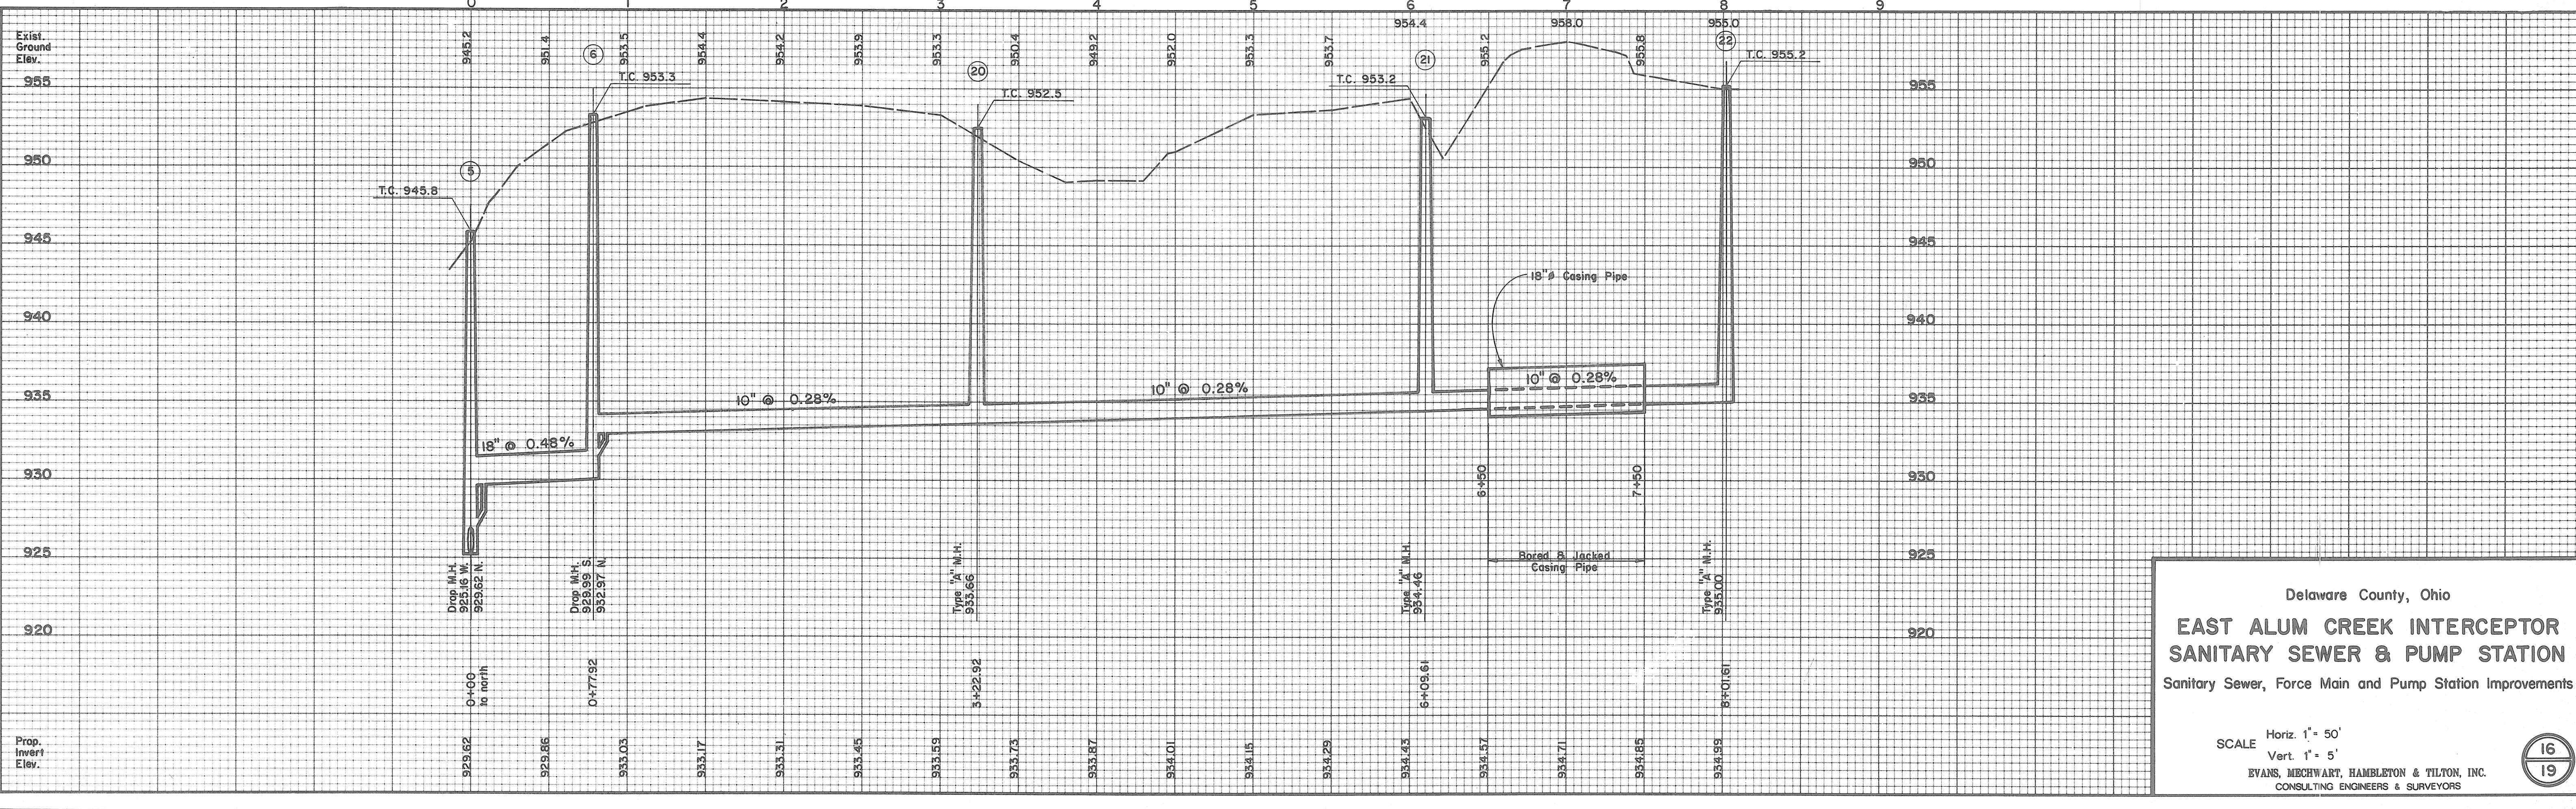
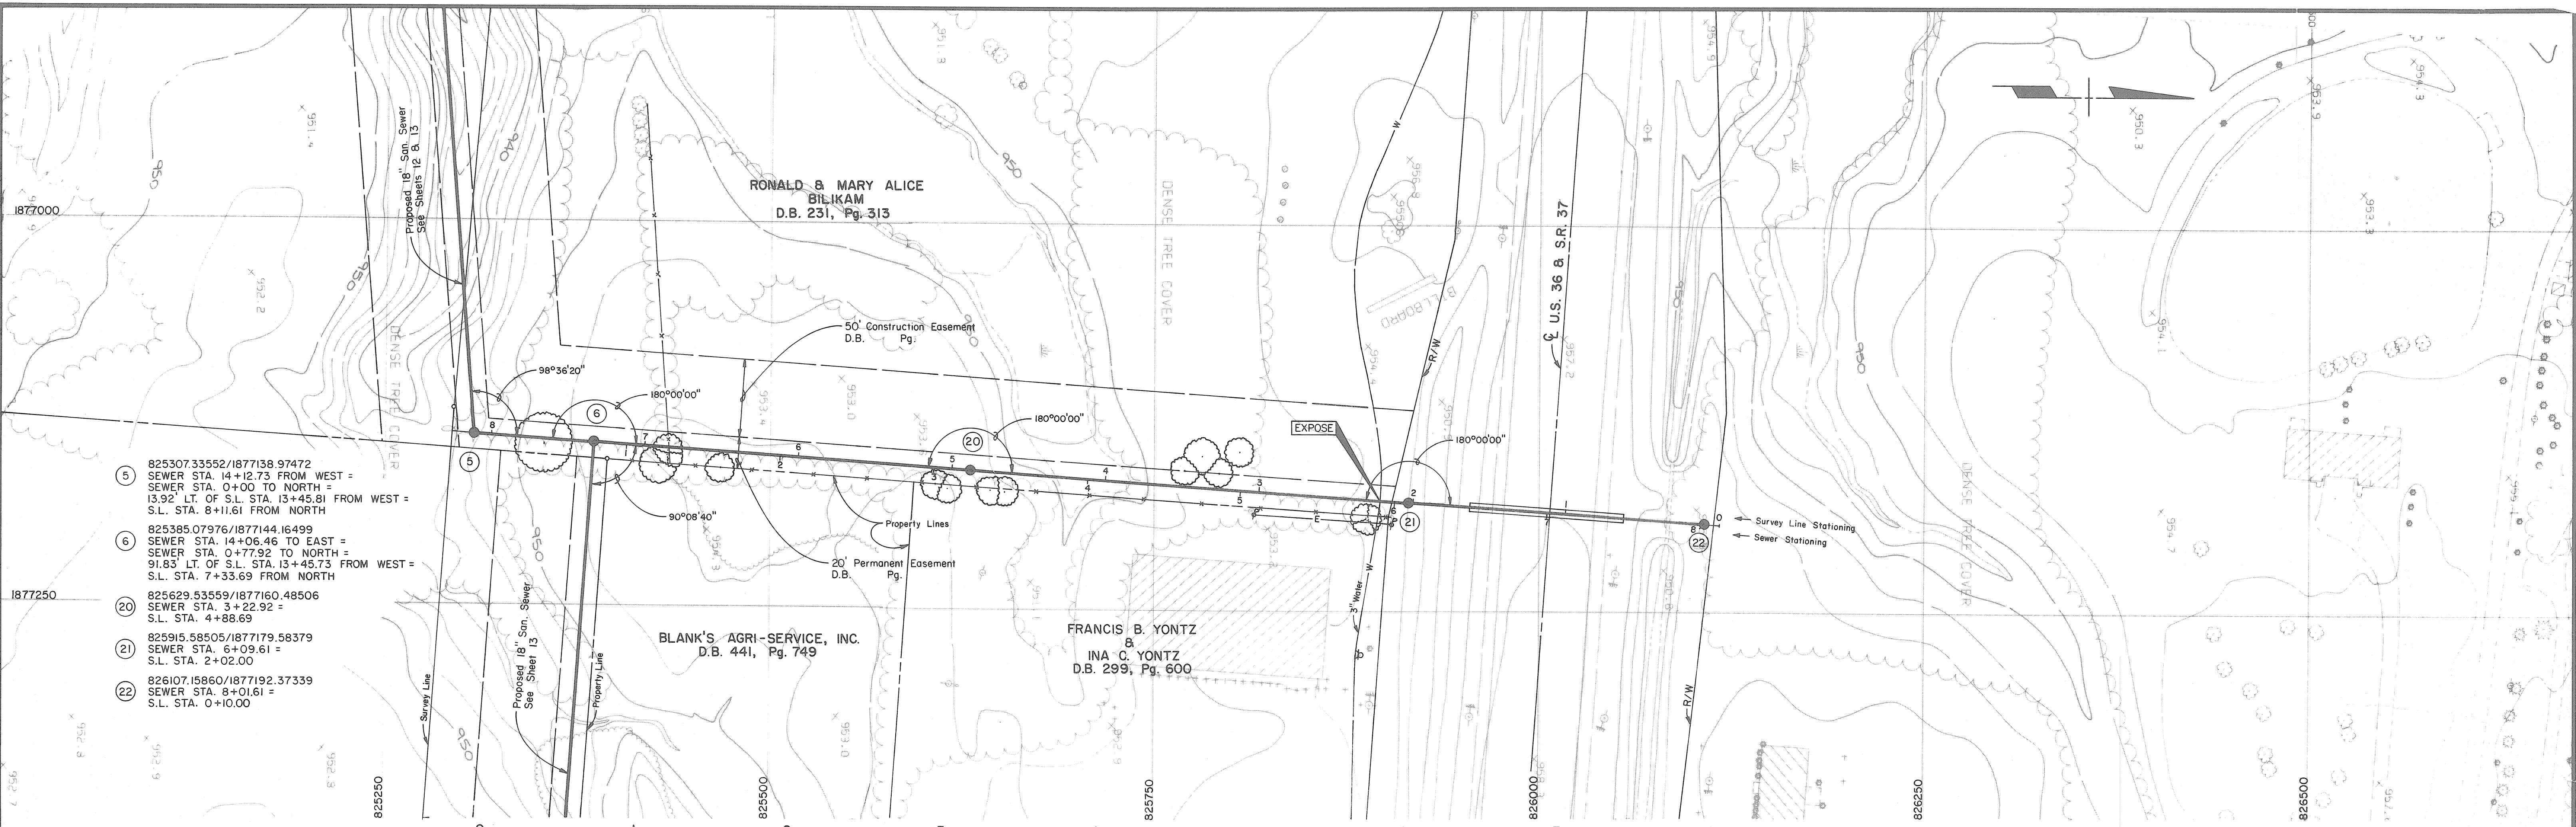


Delaware County, Ohio

EAST ALUM CREEK INTERCEPTOR SANITARY SEWER & PUMP STATION

Sanitary Sewer, Force Main and Pump Station Improvements


SCALE Horiz. 1" = 50'
Vert. 1" = 5'
EVANS, MECHWART, HAMILTON & TILTON, INC.
CONSULTING ENGINEERS & SURVEYORS

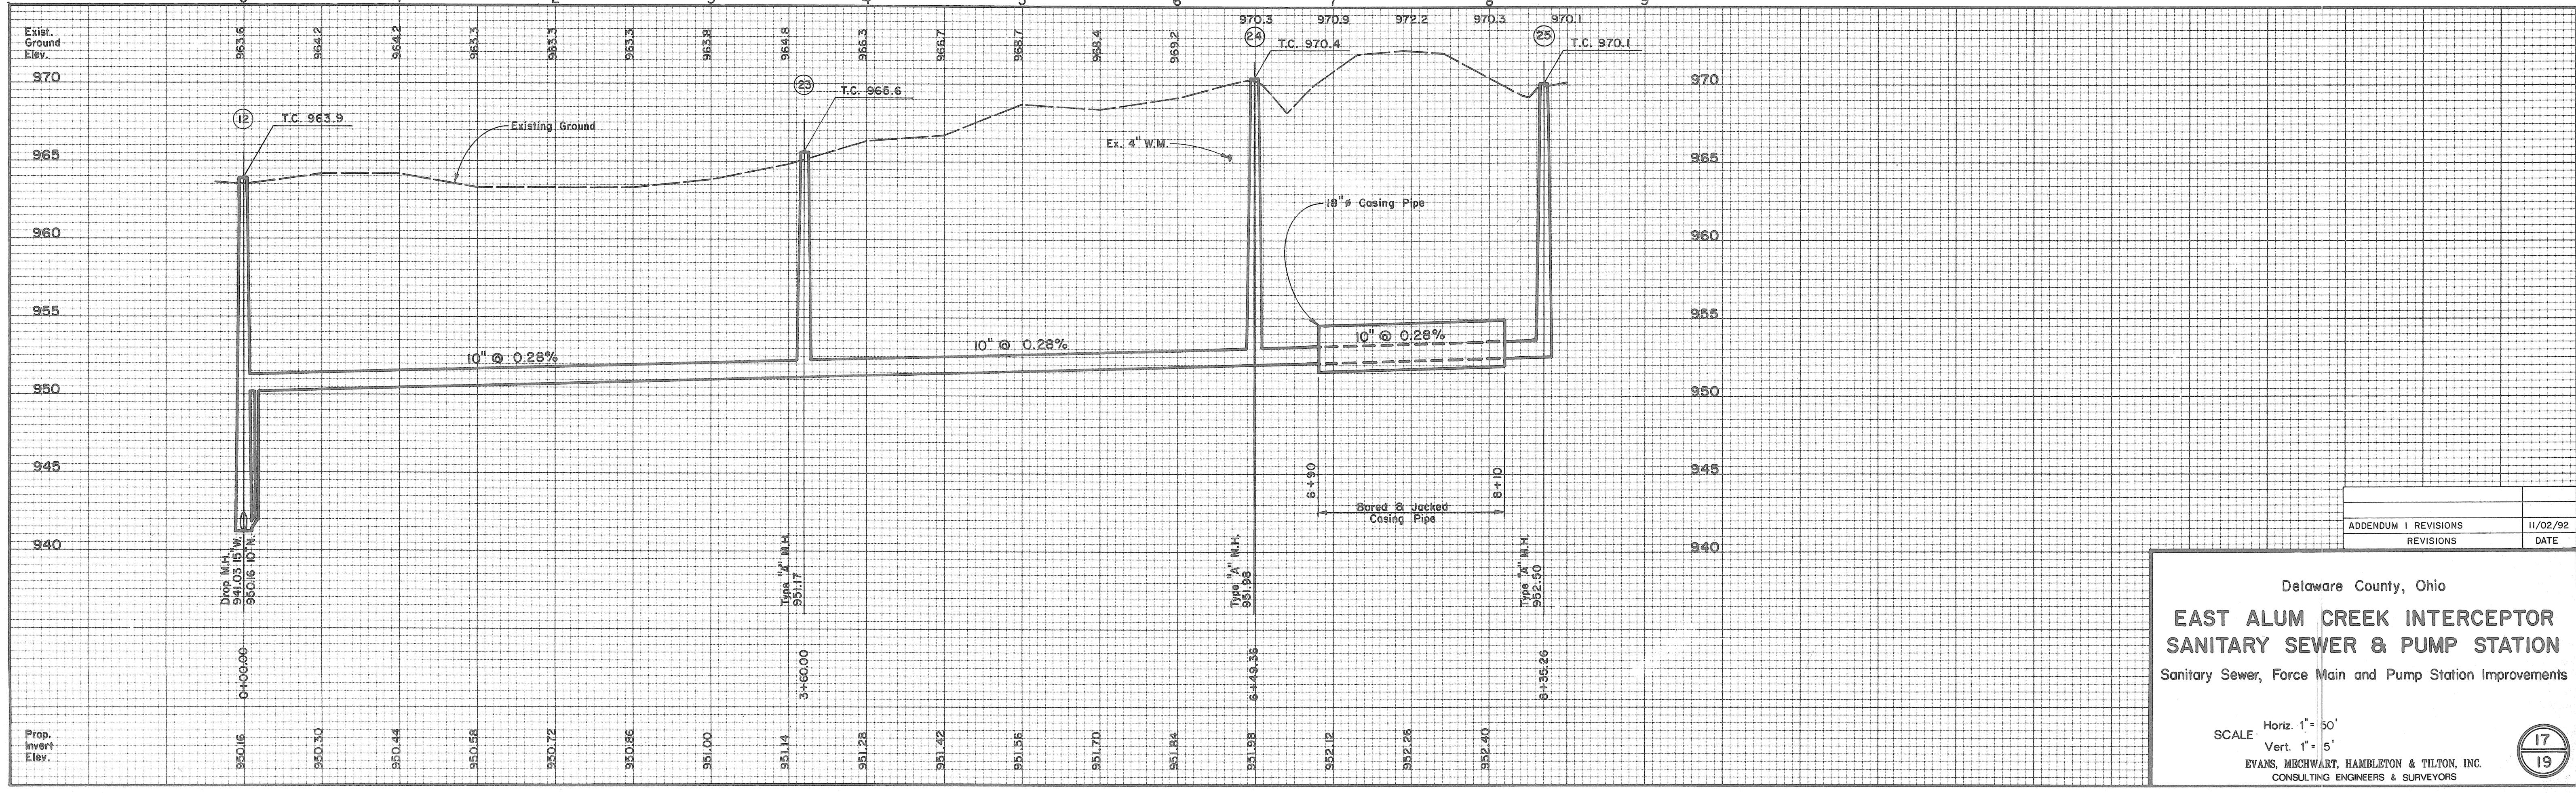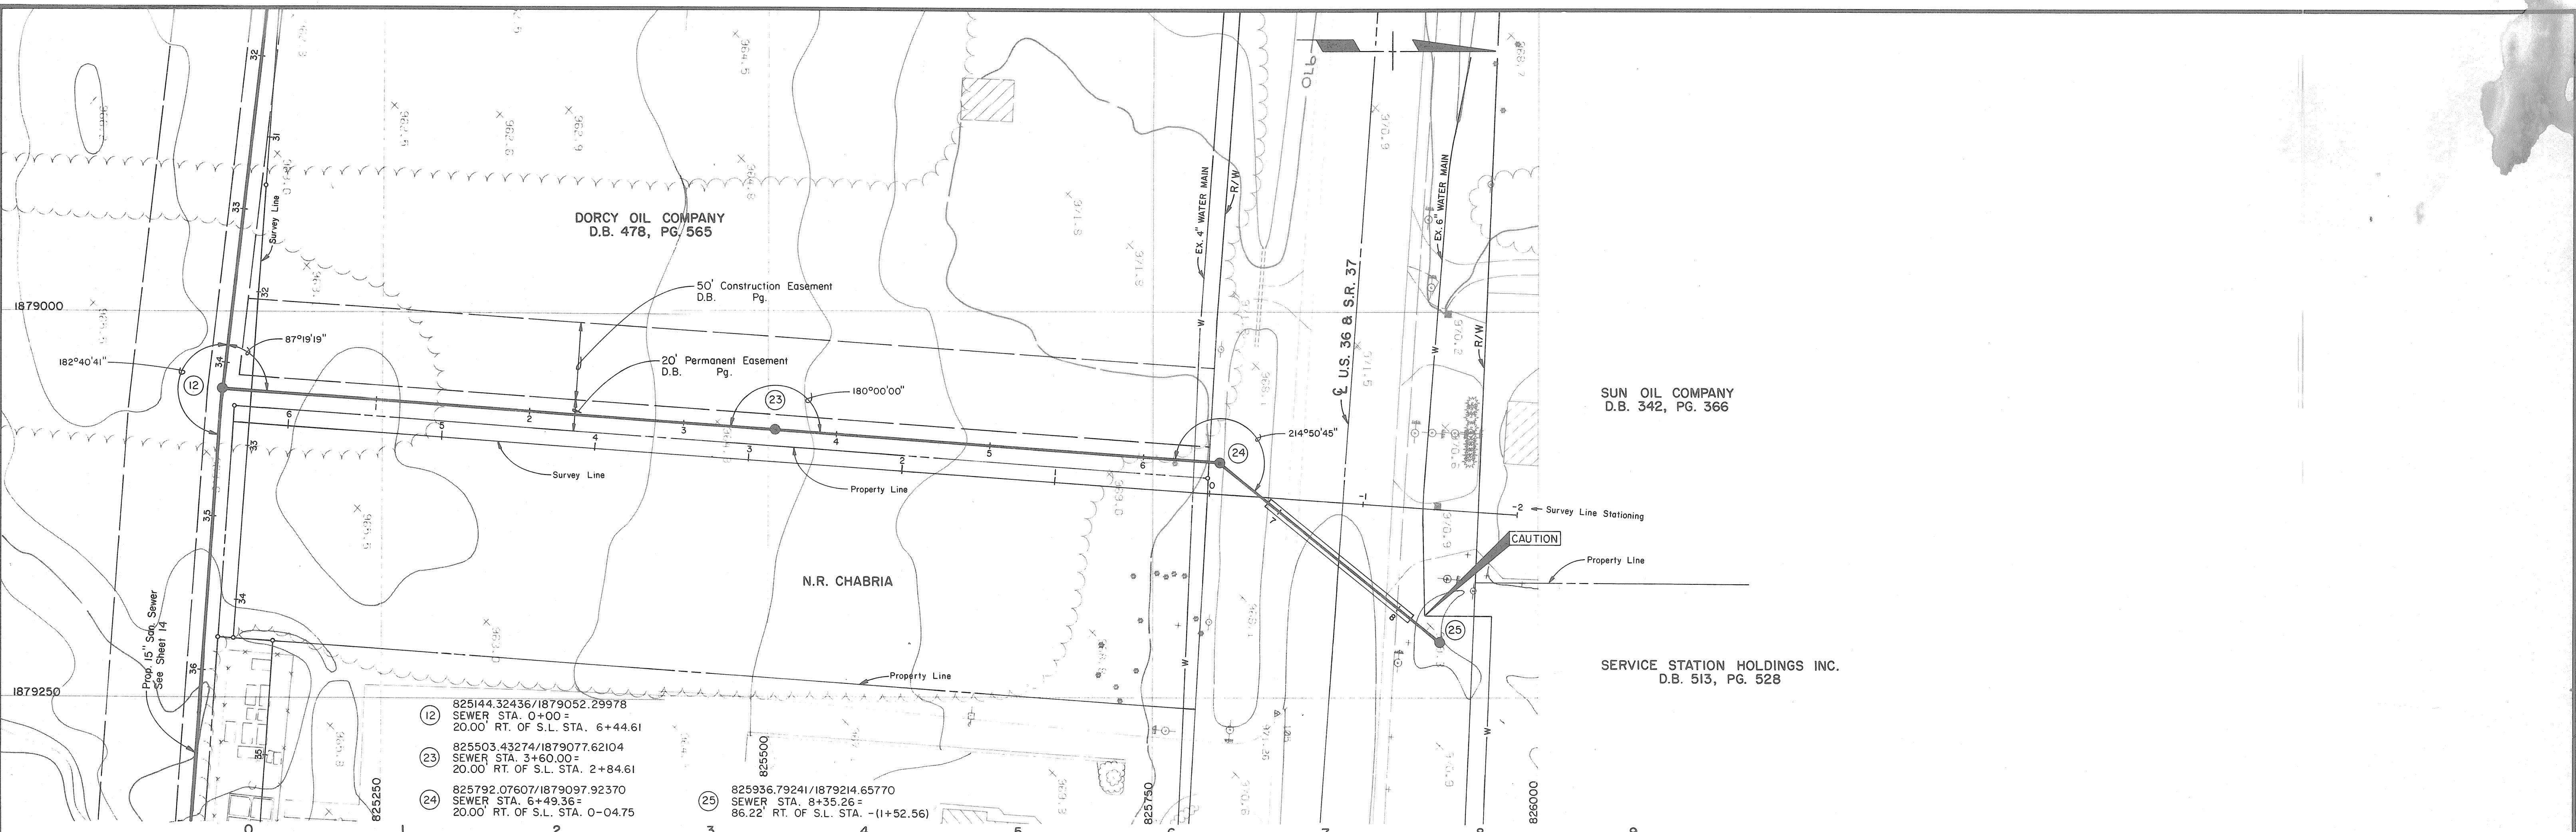

ADDENDUM I REVISIONS
REVISIONS DATE


Delaware County, Ohio
EAST ALUM CREEK INTERCEPTOR SANITARY SEWER & PUMP STATION
Sanitary Sewer, Force Main and Pump Station Improvements

SCALE Horiz. 1' = 50'
Vert. 1' = 5'
EVANS, MICHWART, HAMBLETON & TILTON, INC.
CONSULTING ENGINEERS & SURVEYORS

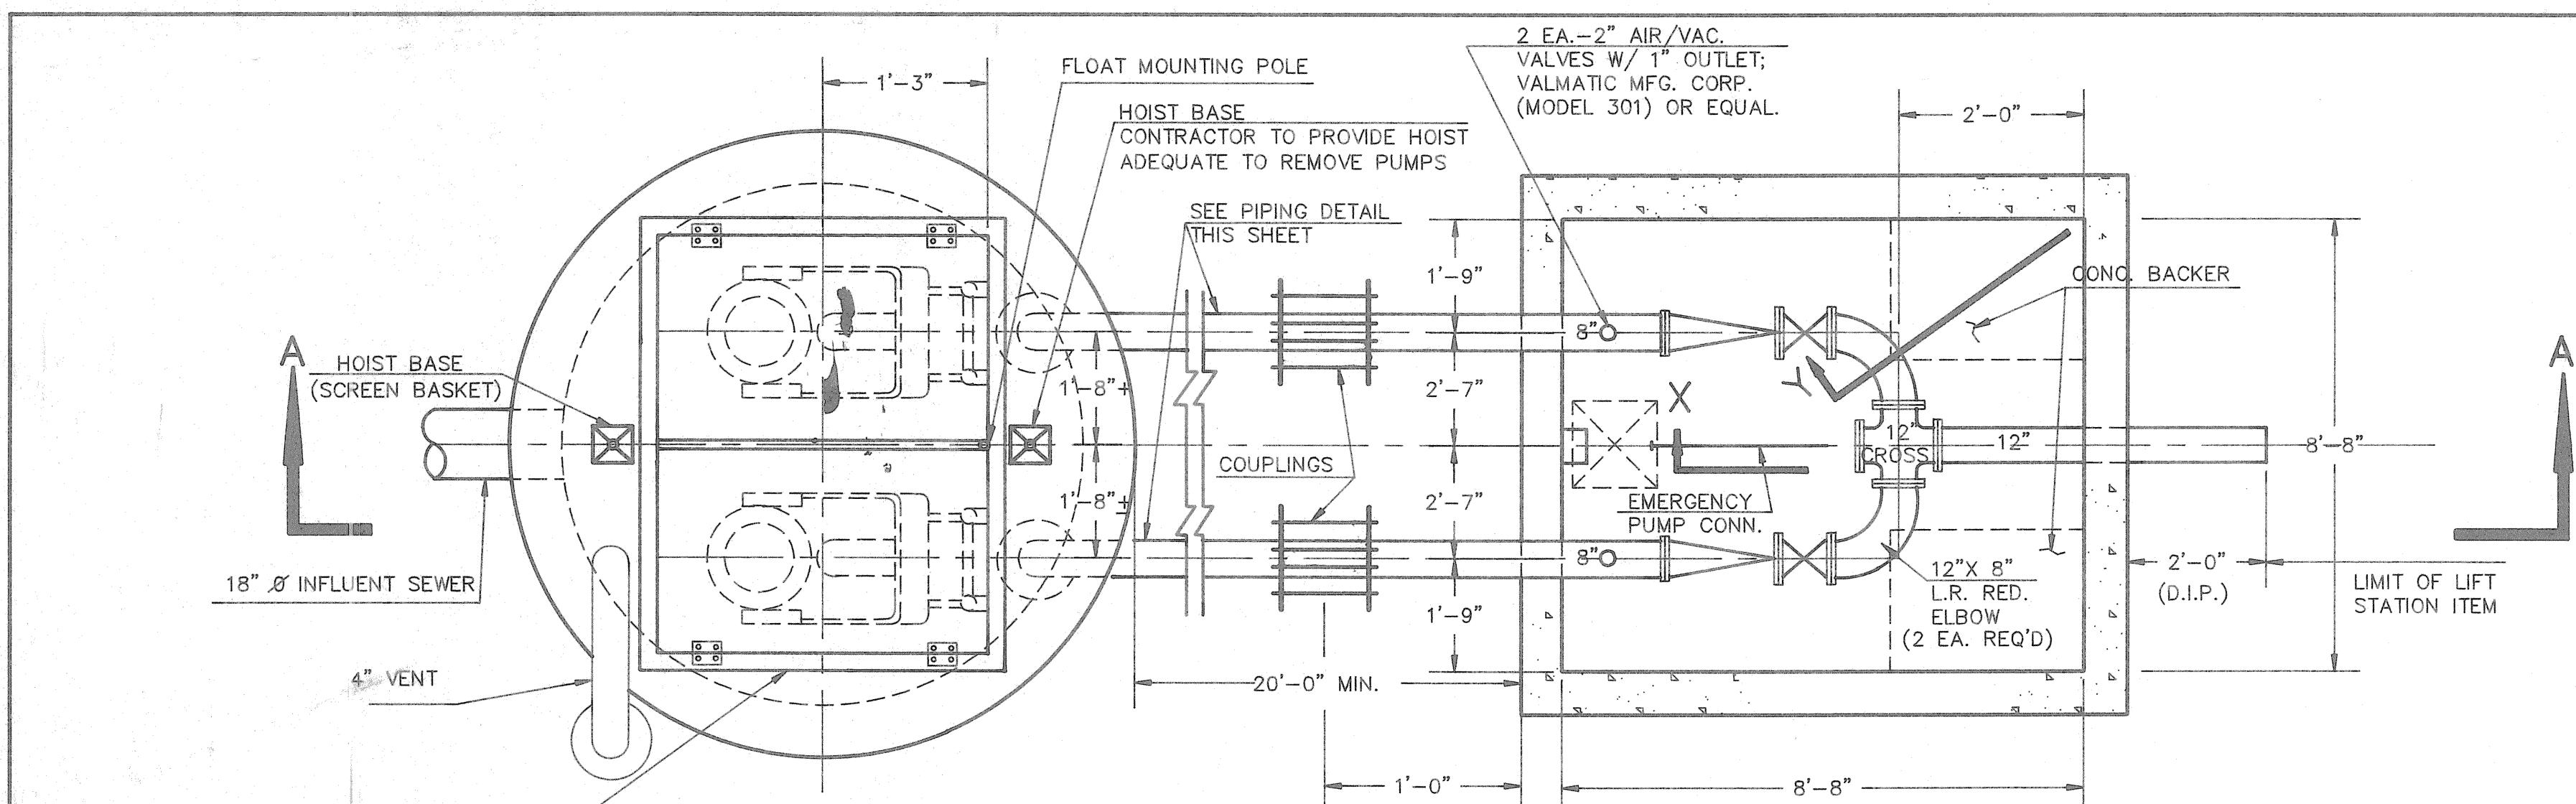

LIFT STATION


VALVE CHAMBER

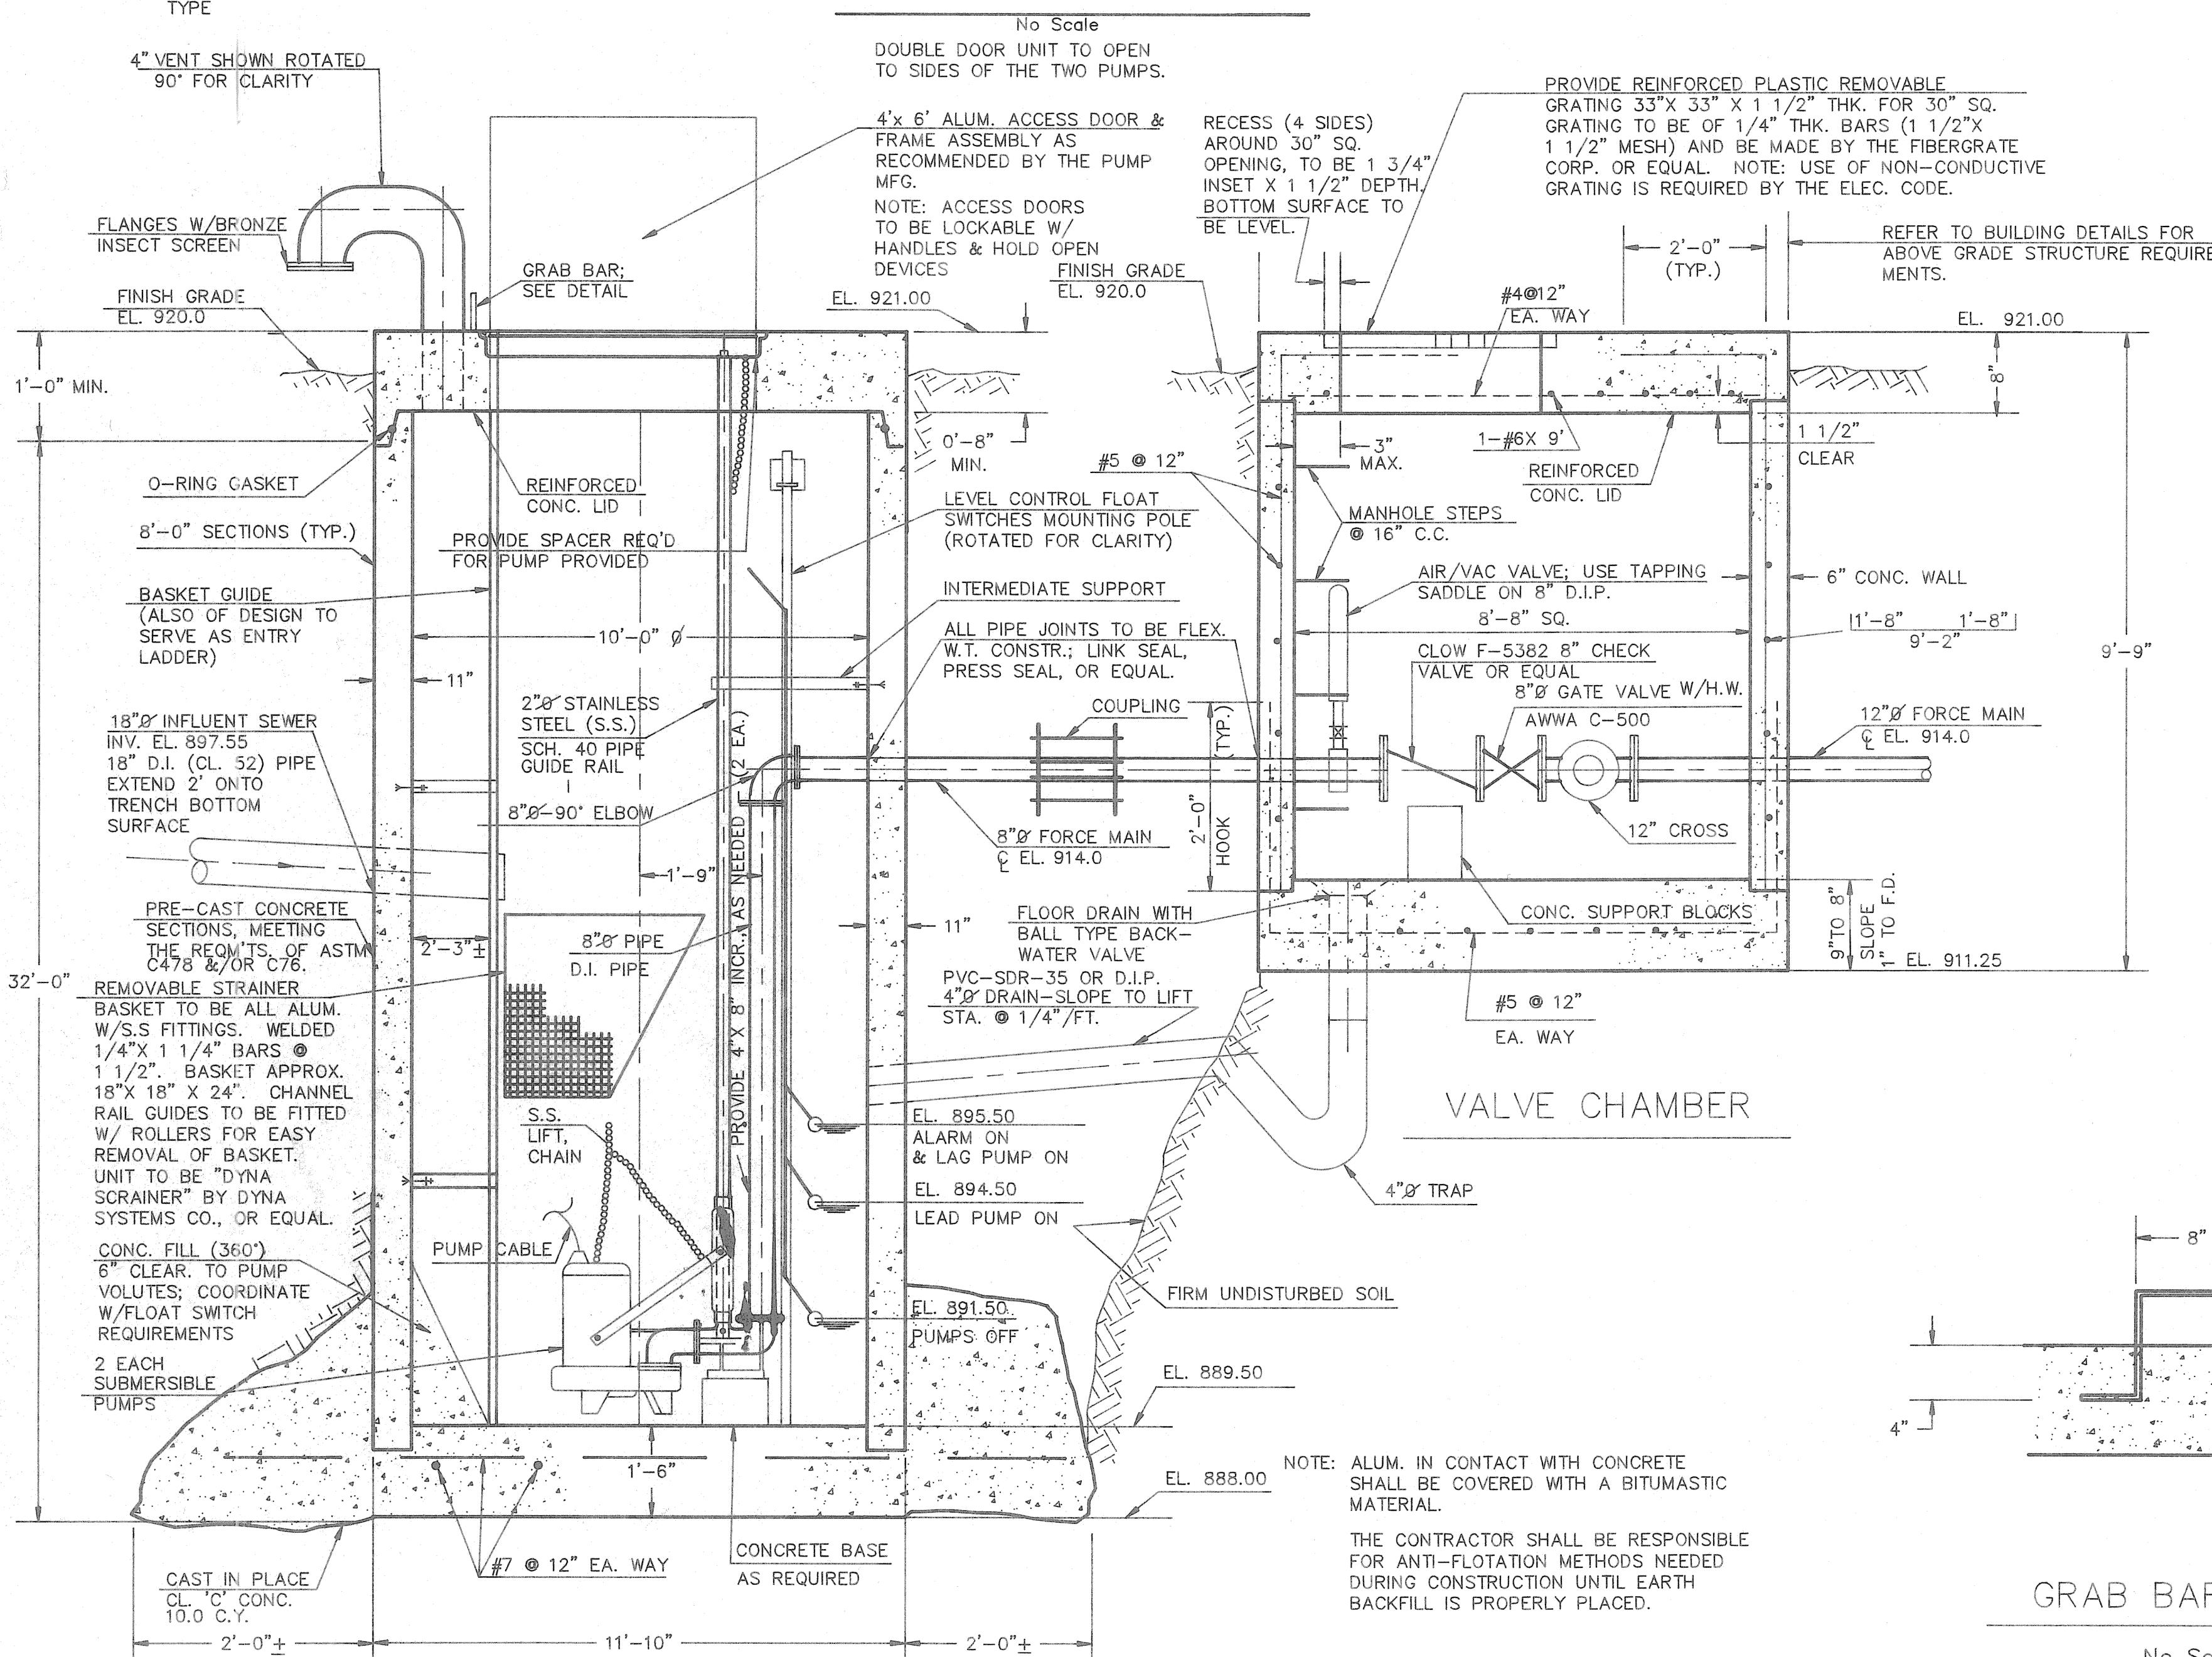

LIFT STATION


SECTION A-A

No Scale

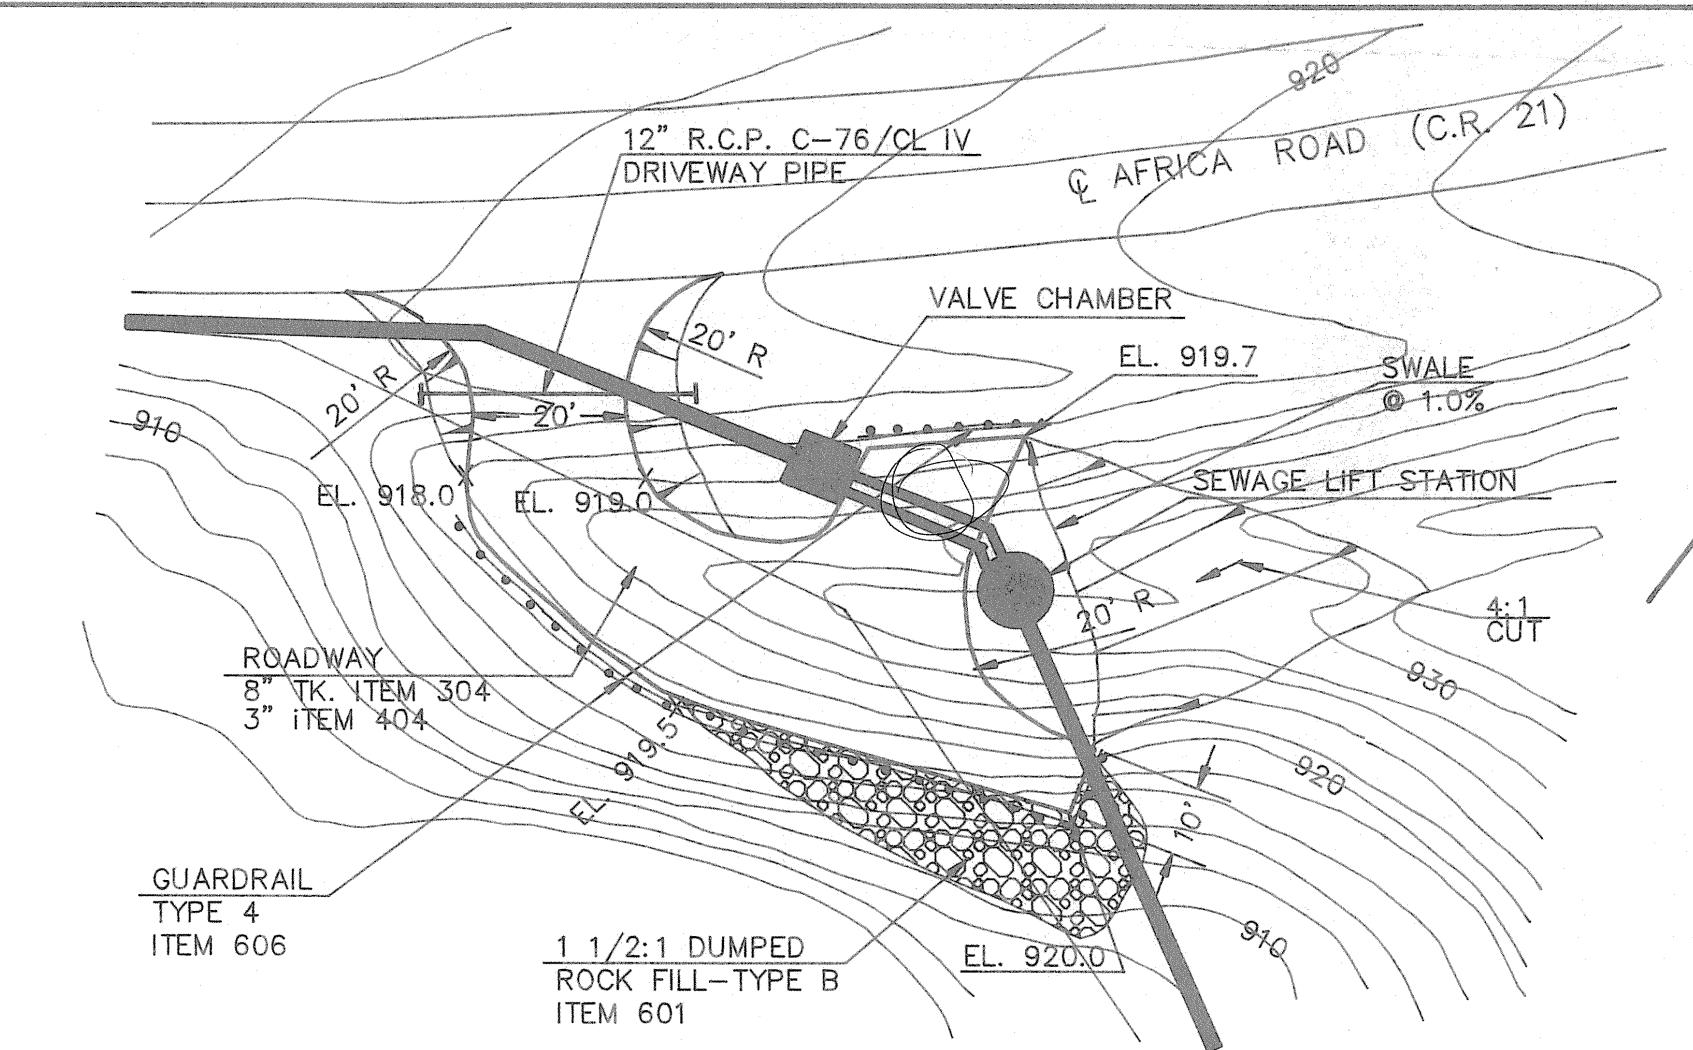


SITE PLAN

Scale: 1'-0" = 30'

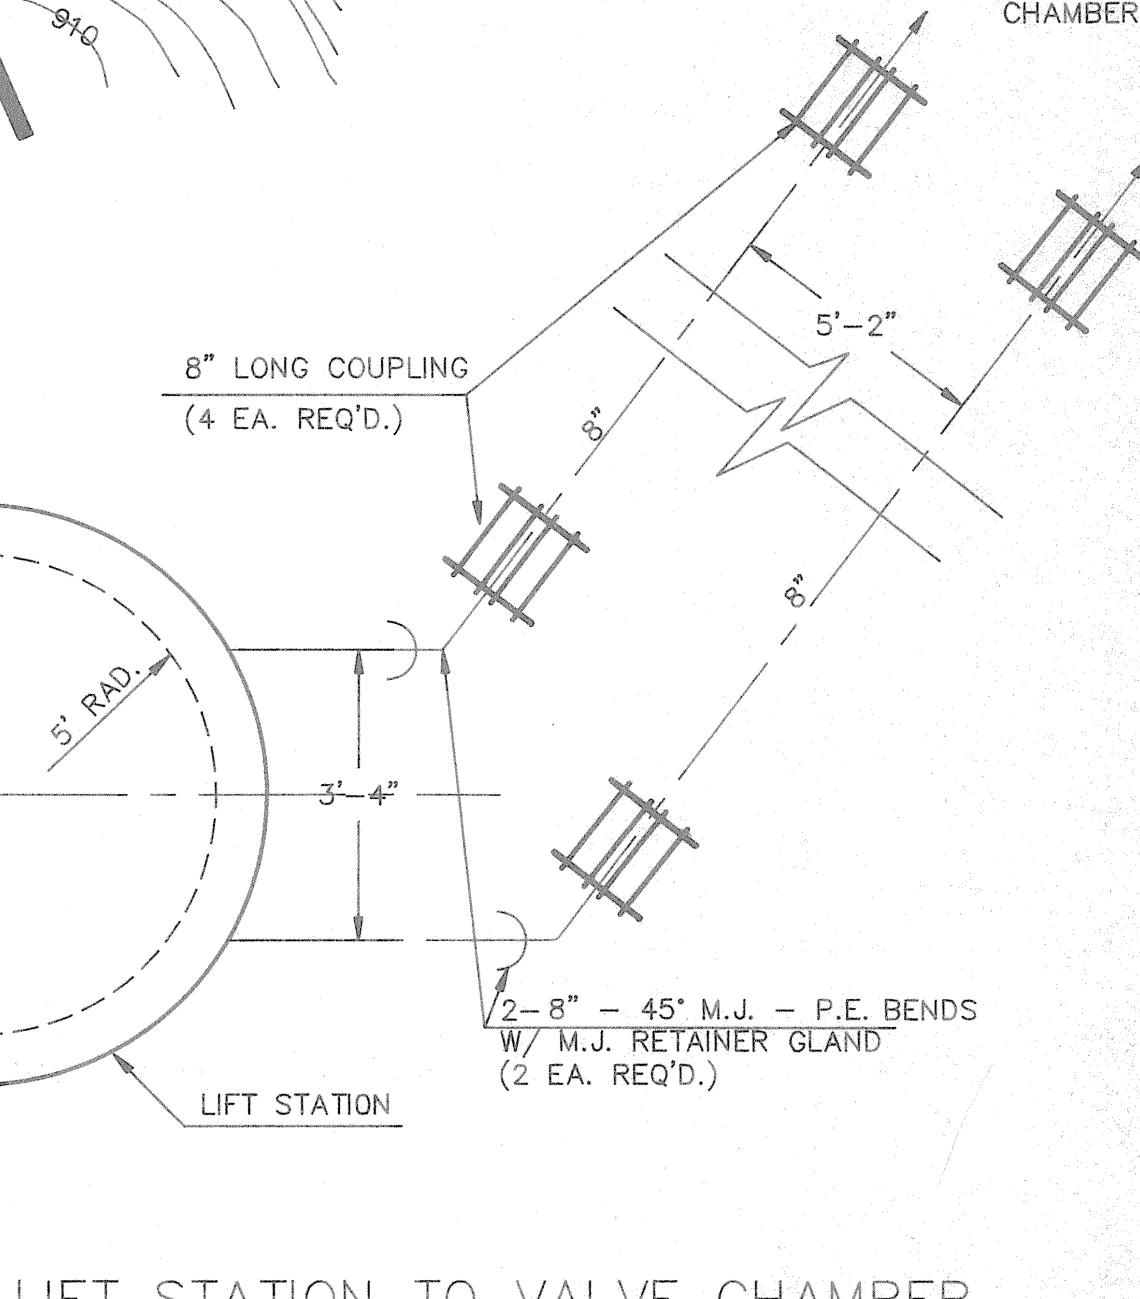

LIFT STATION TO VALVE CHAMBER
PIPING DETAILS

No Scale

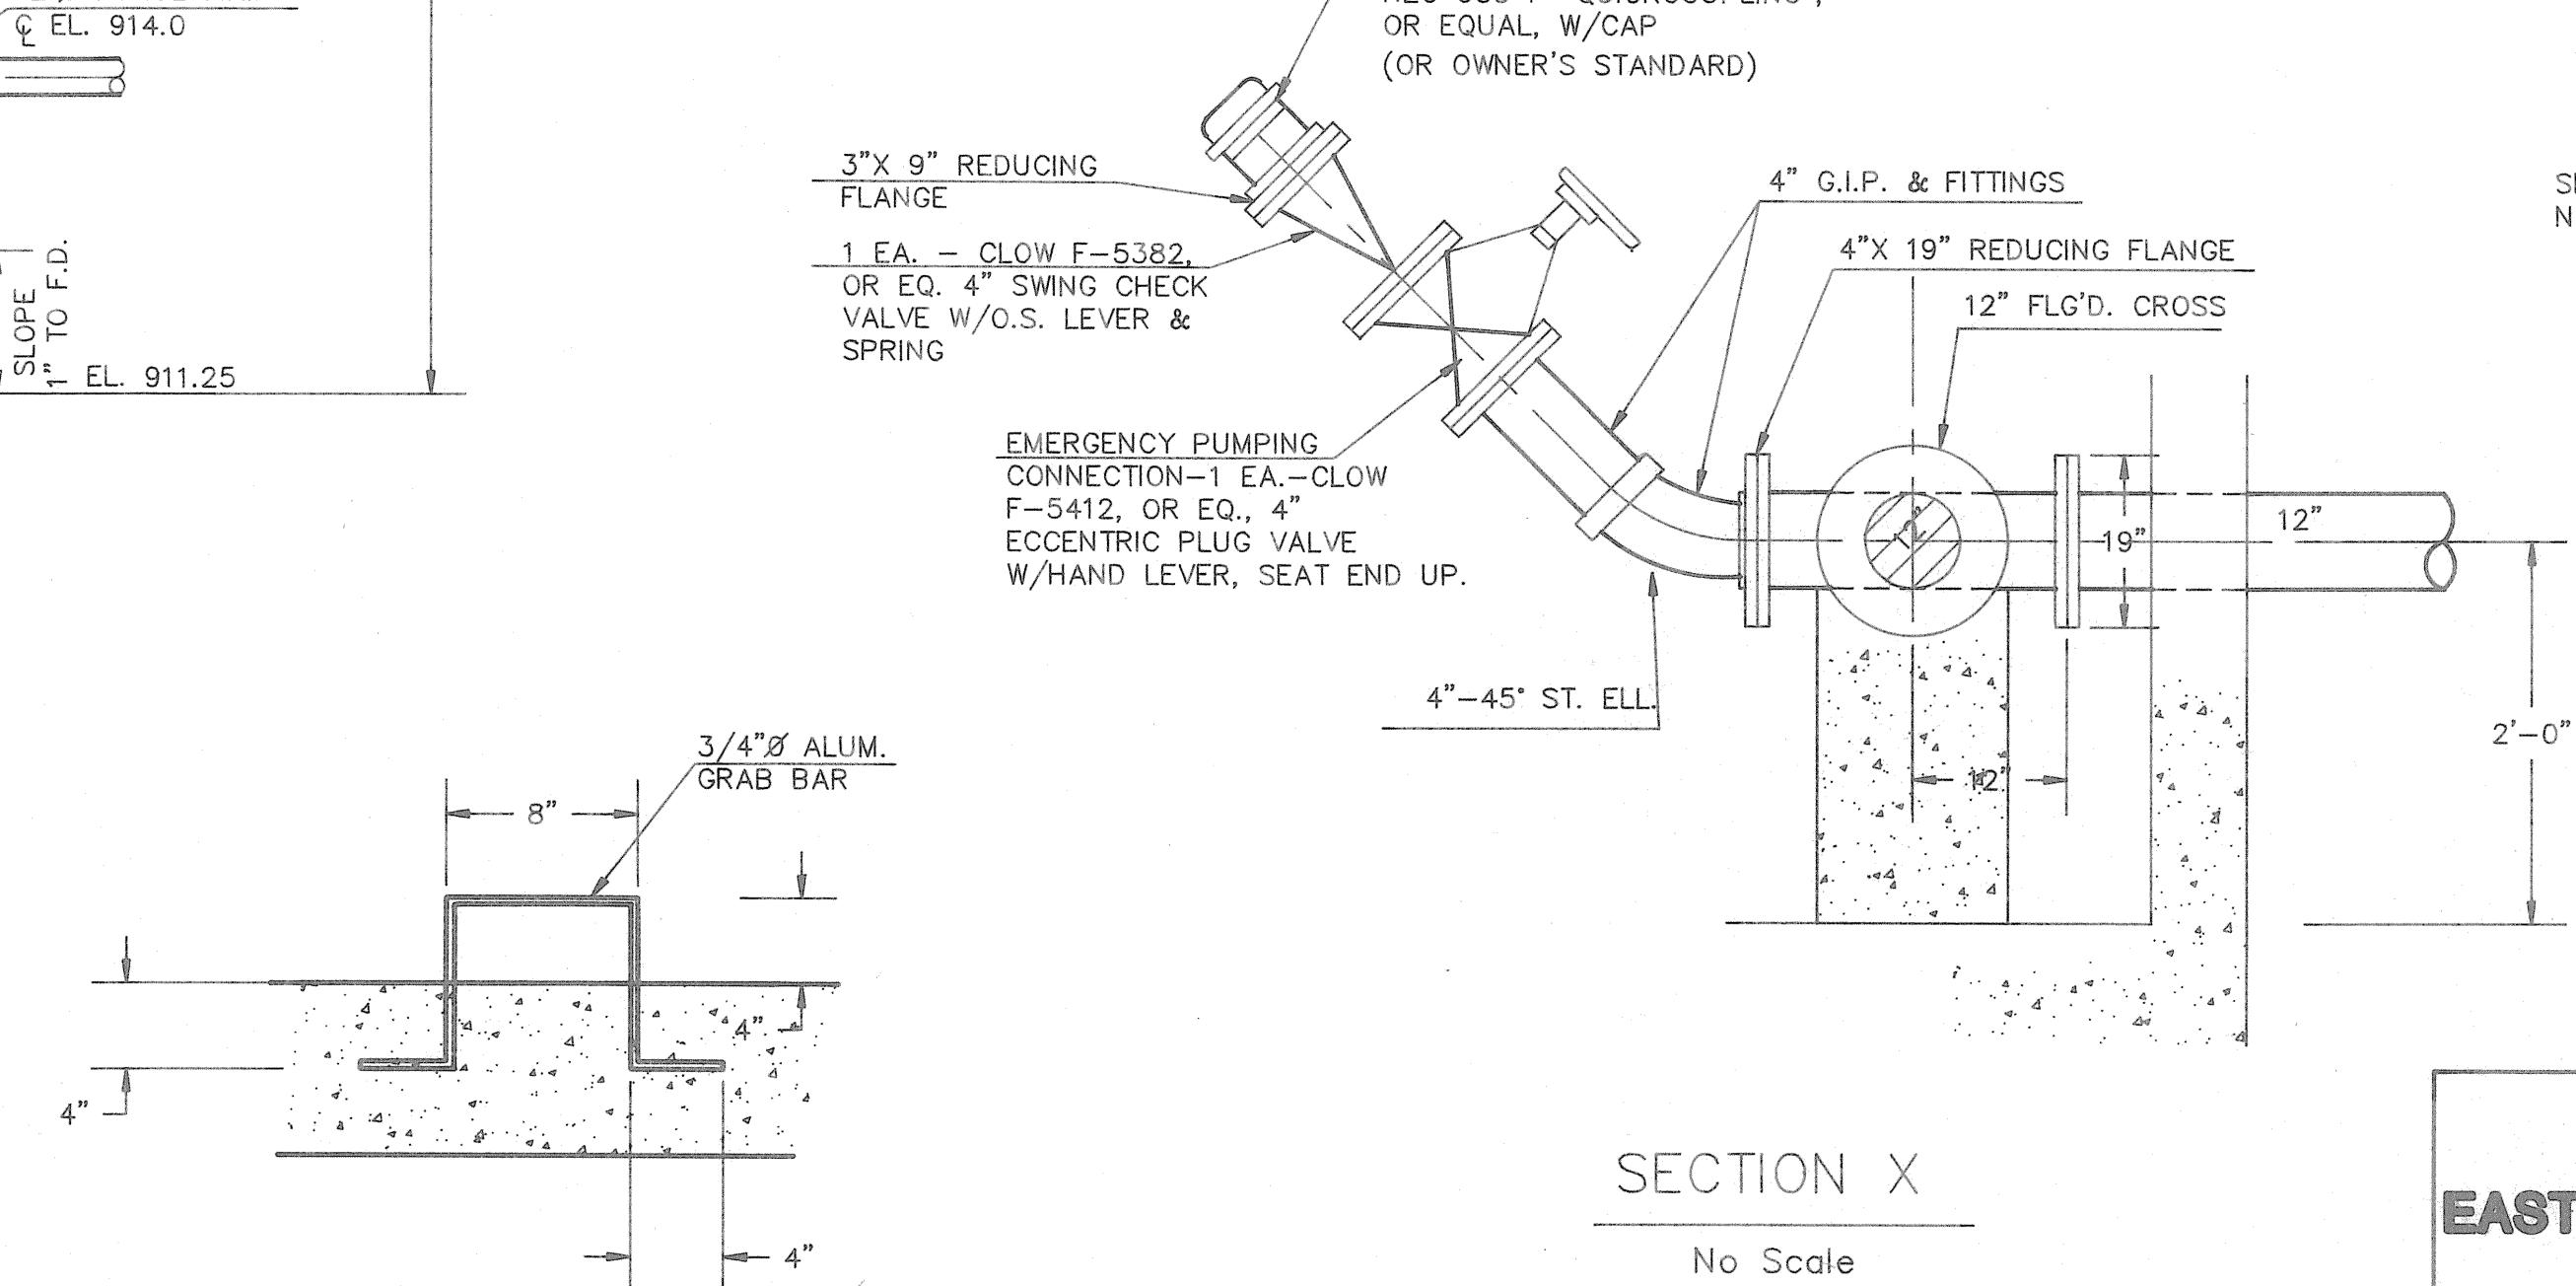

SECTION X

No Scale

Delaware County, Ohio

EAST ALUM CREEK INTERCEPTOR SANITARY SEWER AND PUMP STATION

Sanitary Sewer, Force Main and Pump Station Improvements

PUMP STATION DETAILS

SCALE: As Noted

EVANS, MECHWART, HAMBLETON and TILTON, INC.
Consulting Engineers and Surveyors

LIFT STATION GENERAL NOTES

The Contractor shall comply with material and construction requirements of the Delaware County Board of Health. The Contractor shall obtain any and all permits required by the Board of Health and pay cost for any and all fees.

The Contractor shall furnish all materials, labor, tools, transportation, incidentals and appurtenances to complete in every detail and leave in working order all items of work called for and/or shown on the accompanying drawings. Any material or work not specifically mentioned or shown on the drawings, but necessary to complete the work, shall be furnished.

The Contractor is required to visit the site and fully inform himself concerning all conditions affecting the scope of the work. Failure to visit the site shall not relieve him from any responsibility in the performance of this Contract.

The Contractor shall investigate and locate all existing utilities and notify all utility companies a minimum of 48 hours prior to construction.

The Contractor shall provide 4" to 6" sand or grit leveling base under each concrete structure and shall place granular fill as required, dependent on soil conditions.

Contractor shall grade area to drain surface water away from station.

All disturbed areas shall be seeded and mulched after final grading by Contractor.

Roof drains, foundation drains, and other clean water connections to the sanitary system are prohibited.

All General Notes shown on Drawing No. 2 are to be hereby considered for the construction work of the sewage lift station, where applicable.

ELECTRICAL NOTES

The Contractor shall provide all electrical components and devices to properly serve electrical requirements for the completed facility. All workmanship, materials and equipment shall conform to the Ohio Basic Building Code, the National Electrical Code, Local Building Code(s) and other regulations by authorities having jurisdictional rights for enforcement of construction and safety standards. The pumping station Contractor shall pay the costs or fees associated with any permits or agency inspection charges associated with this work.

Electric service shall be provided to within approximately ten (10) feet of the proposed sewage pumping station, terminating at the "customer's" pole. All electrical connection work shall be performed by the sewage pumping station Contractor. The cost for purchasing and installing the electric meter shall be at the Contractor's expense. Also, the Contractor shall make all the arrangements and pay all fees required for making the proper connections to the Columbus Southern Power Company's service wiring.

Provide emergency generator connection with double throw switches at Electric Control Panel. Connection and electrical devices shall be compatible for use with the Owner's portable generator. Contractor to coordinate with the Owner prior to purchasing these items. Also, provide emergency power outage connection.

Provide and install a lightning arrestor per Delaware County Standards.

Pump float switches to be mounted in the pump wet well in a manner to prevent twisting or fouling of cables. Intermediate support of cables will be required.

The Contractor shall furnish an automatic telephone dialer system, including maintenance free 4 hour battery back-up, and all other necessary appurtenances as required to meet the requirements of the Delaware County Sanitary Engineer. The unit shall be Model No. MSC-500 with FAX talk communications as manufactured by Microtel, Inc. capable of sensing as many as eight (8) alarms and reporting alarm condition(s) to the telephone number receiving locations now used for other Microtel units of the existing system. This equipment shall either be placed in a NEMA 4X S.S. box near the pump controls enclosure or it shall be included inside a pump controls enclosure of adequate size.

All auto dialer and telephone work is to be provided by the pump station Contractor. The Contractor shall make all arrangements, and pay all fees and costs necessary for obtaining an operable telephone service meeting all code requirements. Motor starters shall be of the solid state type and be "SMC" by Allen-Bradley.

LIFT STATION SPECIFICATIONS REFERENCE NUMBER 6

6.01 GENERAL

A. Scope of Work

Work under this section includes furnishing and installing the lift station, complete as shown on the Drawings and as specified herein.

6.02 WET WELL AND VALVE VAULT

A. The lift station and valve vault shall be constructed of pre-cast concrete sections meeting the requirements of ASTM C478.

B. All rubber ring joints shall comply with ASTM C443.

6.03 ACCESS LID AND FRAME ASSEMBLY

A. The wet well top shall be fitted with a double door access lid and frame assembly.

B. Each door is to have a handle, a latch to hold it in the open position, and a hasp for padlocking.

C. The frame shall be of 3" x 3" x 1/4" angle.

D. The frame assembly shall be placed in the concrete wet well when it is poured.

6.04 PIPING

A. The Contractor shall supply and install all piping and valving required in the concrete wet well and valve vault as shown on the Drawings. Flanged Joints - Ductile Iron shall be Class 52 (min.) conforming to AWWA C-110, C-150 & C-151 w/ rubber gaskets per C-111.

B. PUMPS - (Explosion proof motors & electrical items are required per Class 1, Div. 1, Group D requirements.)

A. Furnish and install two submersible pumps as manufactured by Flygt Corp. (CP 3127 / 462), or equal to Gorman-Rupp Company.

B. Pump impellers to be non-clog design capable of passing 3" diameter solids.

C. Each pump shall have a capacity of 350 GPM at a total dynamic head of 41 feet. Motors shall be 7.5 HP, 1750 RPM (max.), designed for operation on 230/460 volt, three phase, 60 hertz power. Pump shut off head shall be 57" (min.). Motor shall be non-overloading over full range of curve. Pump eff. at 350 GPM shall exceed 52%.

D. The volute casing, impeller, and motor enclosure shall be cast iron. The motor shaft shall be stainless steel with double mechanical seal assembly with leak sensor.

6.05 PUMPS

A. The installation and removal system for each pump shall consist of a stationary cast iron discharge base elbow with 125 lb. discharge flange connection and two guide rail connections. This elbow shall be attached to a support base that is connected to the wet well bottom. The guide pipes shall be secured at the top with a guide rail cap attached to the access frame.

B. A slide assembly with yoke shall attach to each pump and slide freely between the guide rails.

C. The design shall be arranged so that a minimum force shall be exerted between the stationary base elbow and the pump discharge to provide a positive seal without bolting or fastening. The lever action shall provide for easy breakaway when raising the pump.

6.07 PORTABLE HOIST

A. The Contractor shall provide one (1) portable, hand-winch hoist of adequate design to set into place or remove any submersible pump furnished.

B. Appropriate sleeve for mounting the hoist in the proper location shall be provided as shown on the Drawings. An additional sleeve shall be provided and mounted in an appropriate location at the strainer basket.

6.08 PUMP CONTROLS

A. Level Controls

1. Three mercury float switches shall be mounted inside the wet well.

2. The floats shall be suspended at the proper depths to control the Off Level, On Level, Emergency Level (both pumps on) and High Water Alarm Level.

B. Control Panel









1. A duplex pump controller in a NEMA 4X, stainless steel enclosure shall be mounted at the wet well. It shall contain a circuit breaker, magnetic starter, hand-off-auto selector switch, time elapse meter, and seal leak indicating light for each pump. It shall alternate the pumps on successive cycles and turn on the second pump if the first fails or the inflow exceeds one pump. Float switches shall be equipped with intrinsically safe isolator relays appropriate for Class 1, Division 1, Group D location. Each pump's power cable shall be supported from the wet well by stainless steel, basket weave, cable support grips (Kellum grips).

2. A 115 VAC duplex convenience outlet shall be provided on the panel with ground fault interruption protection.

3. A horn and red flashing High Water Alarm light shall be mounted on the electric service pole or on the controller enclosure as called for or approved.

4. Pump and level control cables shall pass through the top of the wet well and into the bottom of the control panel in sealed cable grips, employing use of strain relief devices.

9"x 12" LOUVER W/
INSECT SCREEN AND
SHUTTER, 4 REQ'D.;
2 FOR EA. SIDE AS
SHOWN.

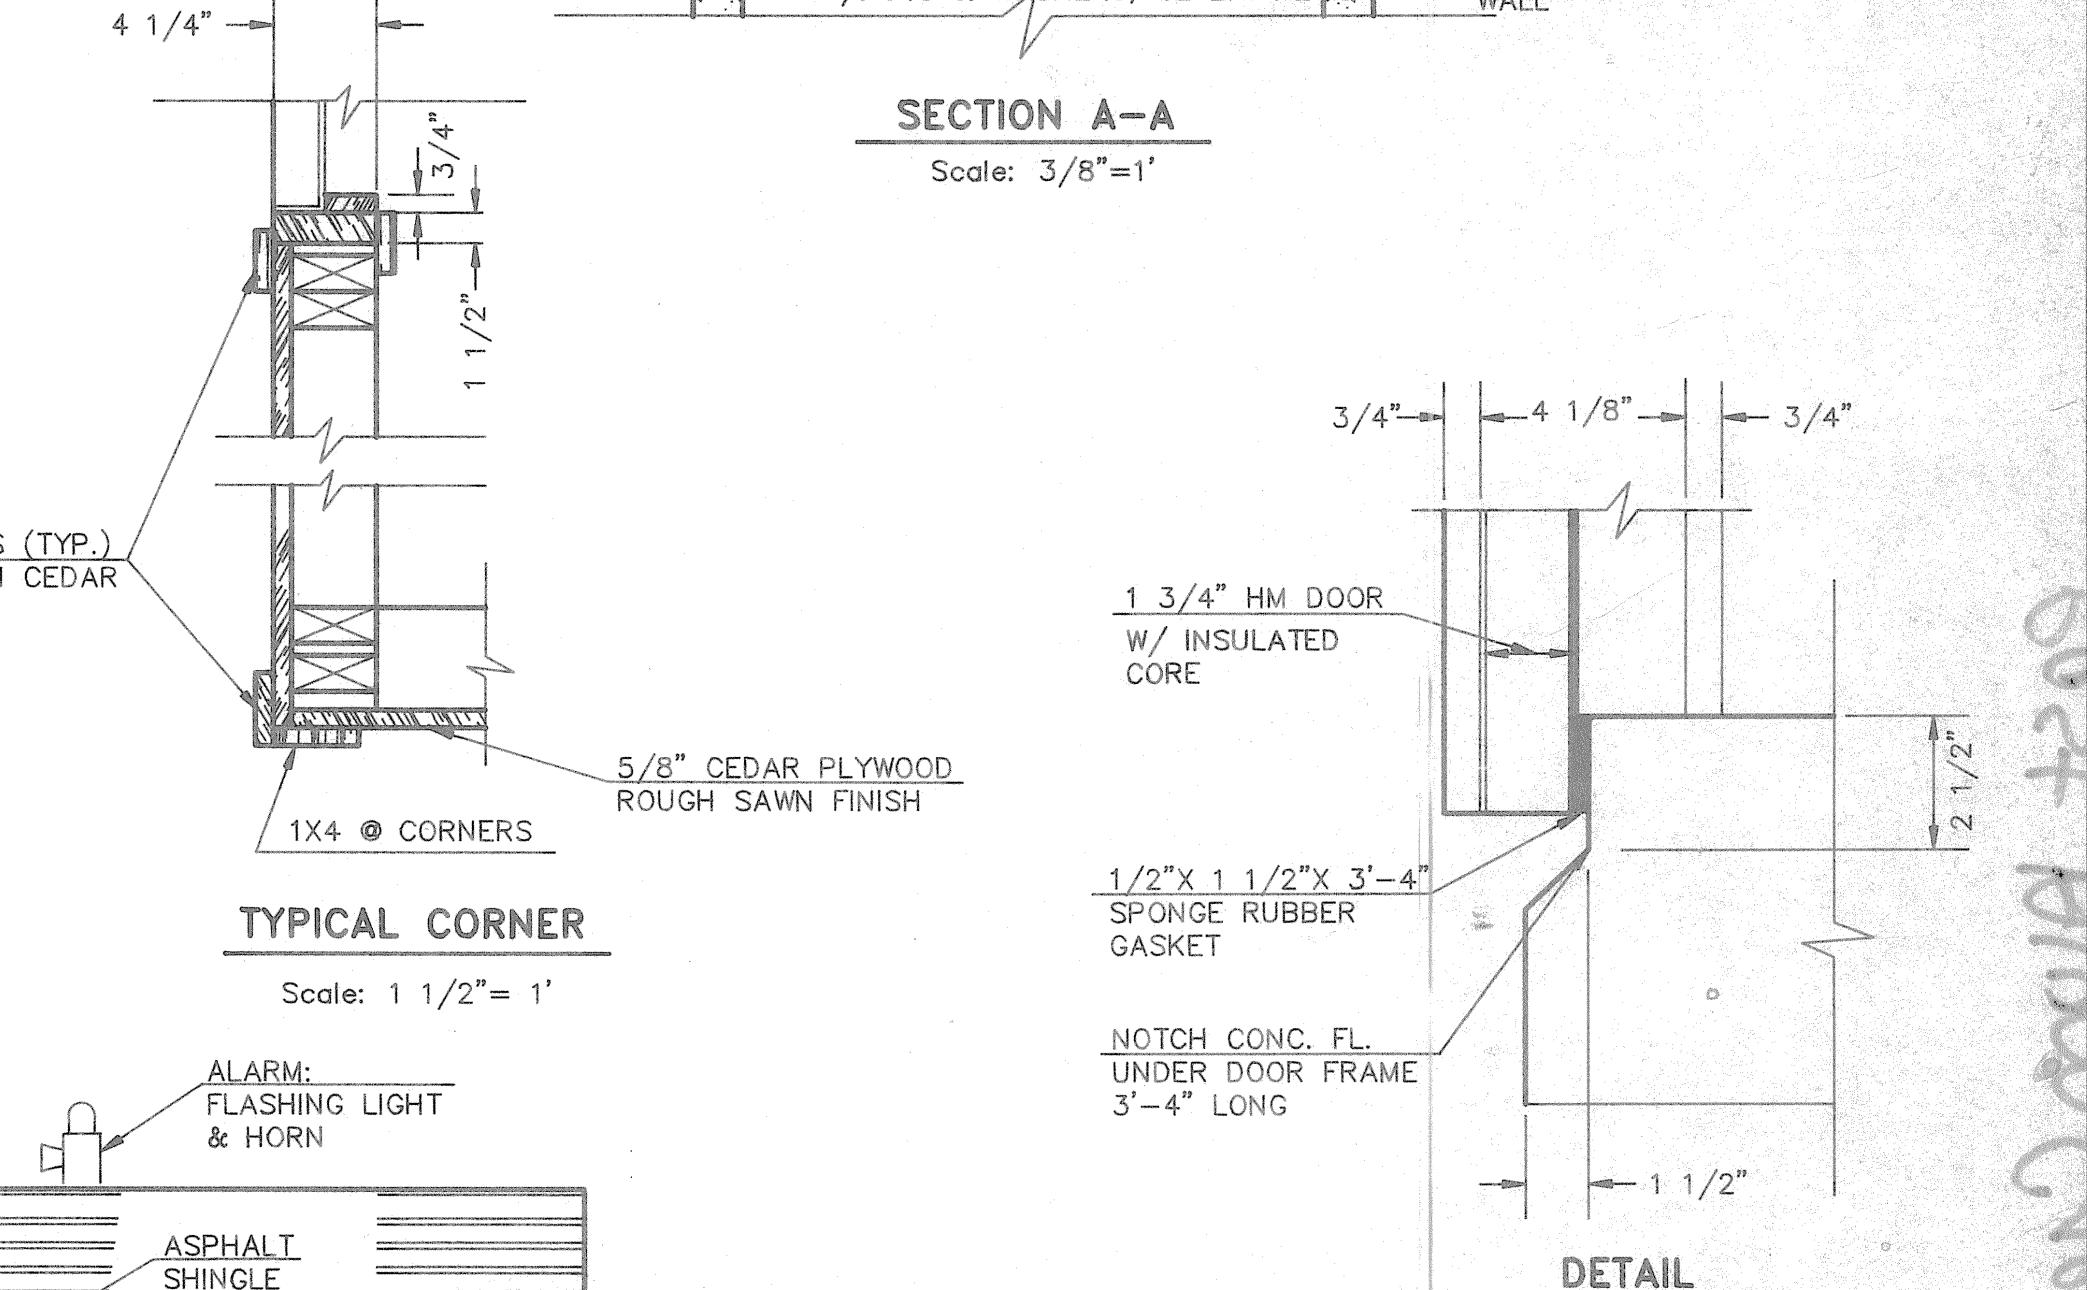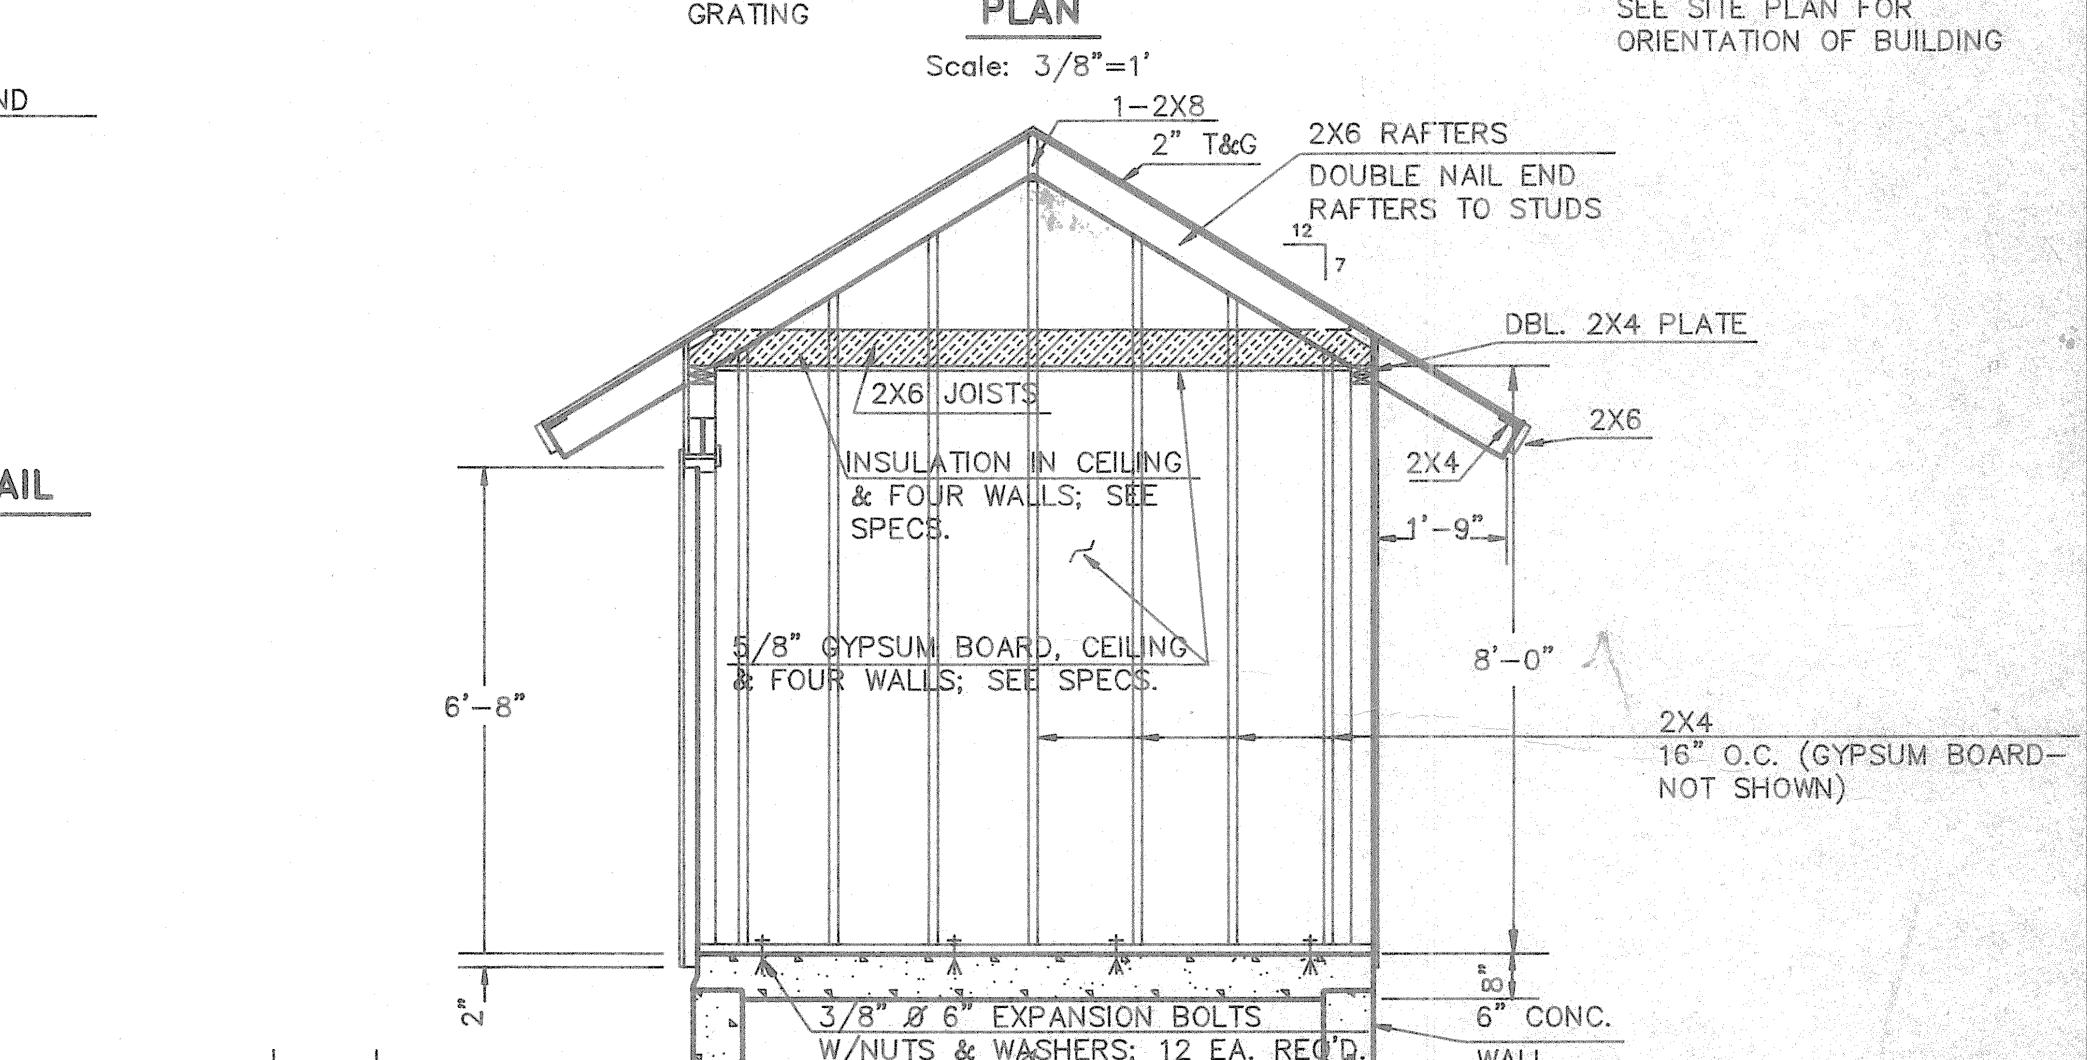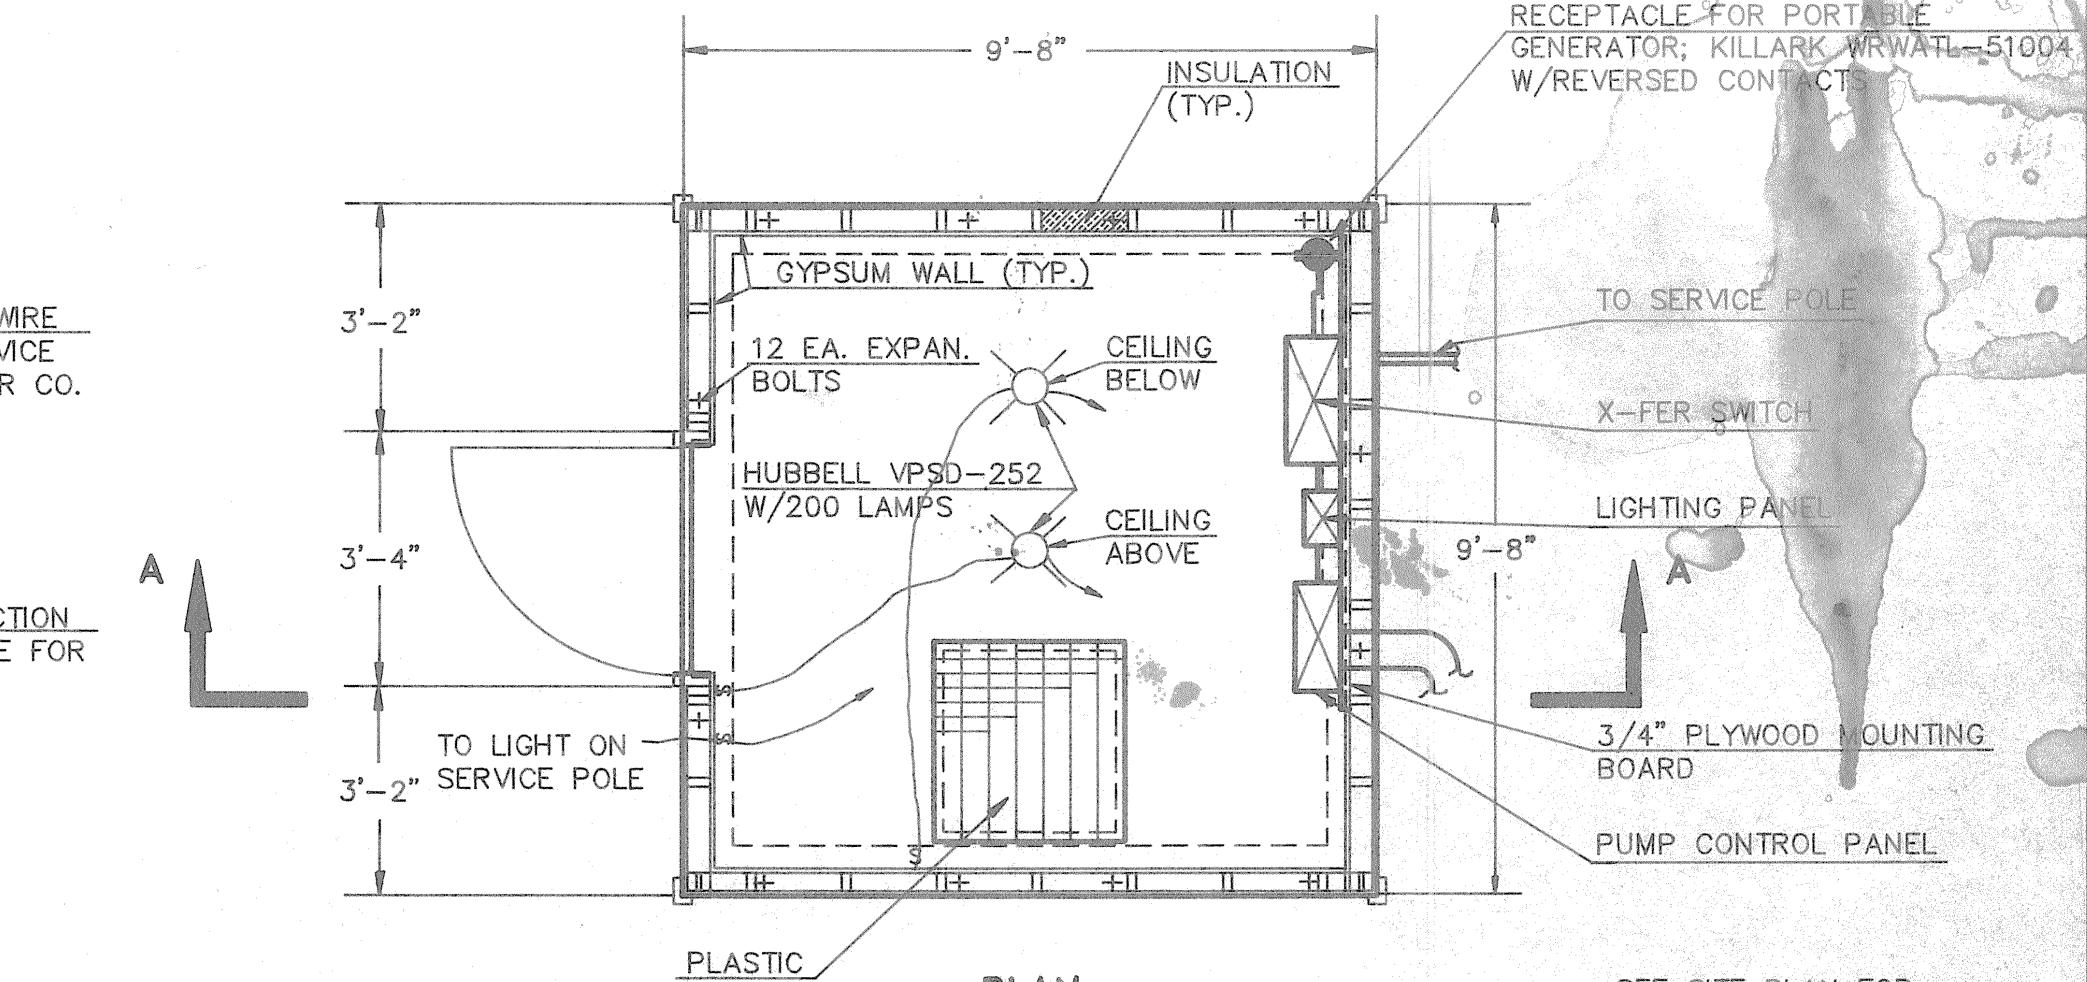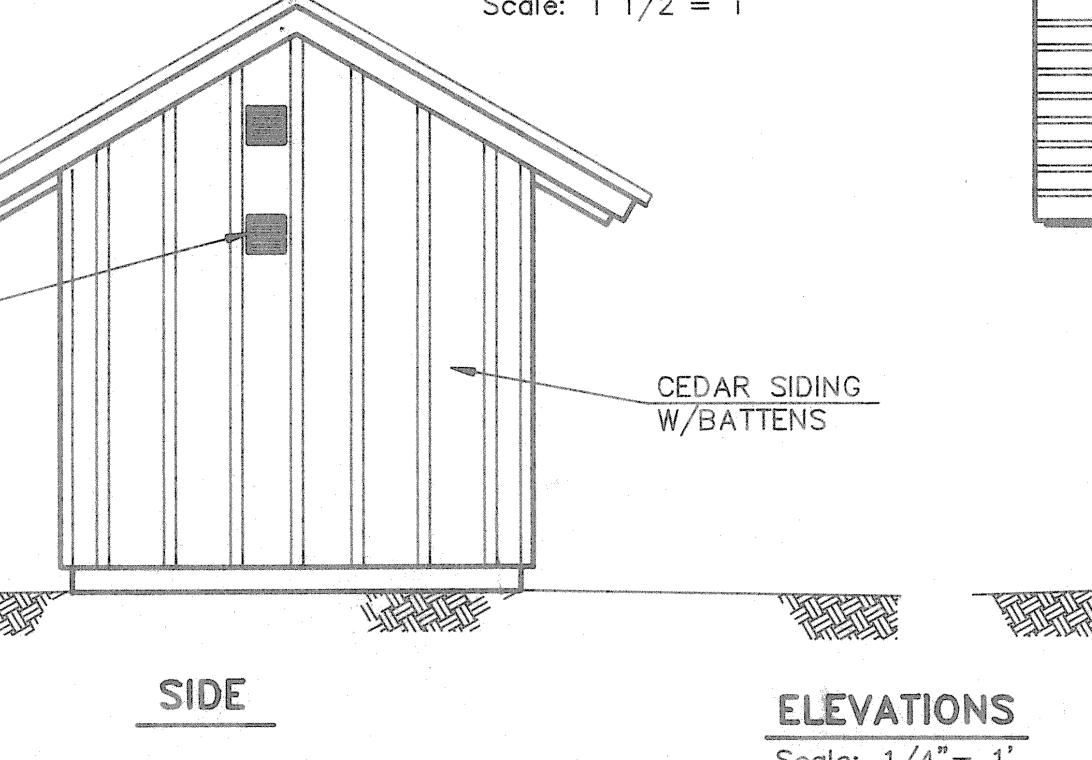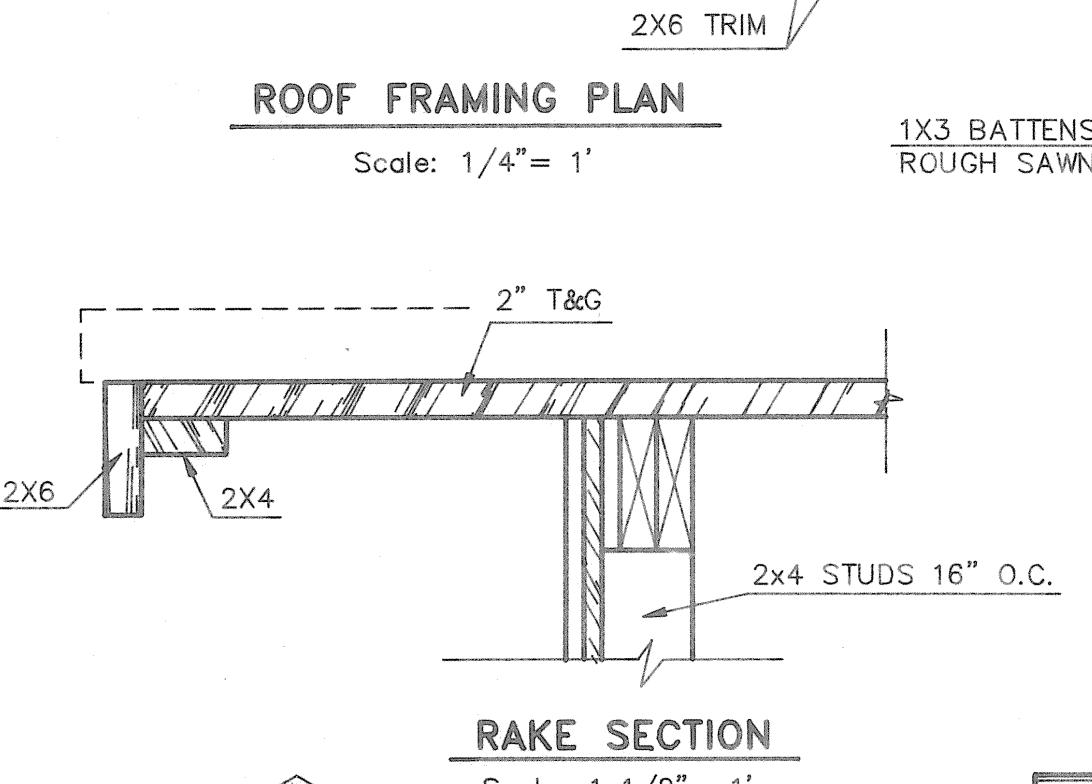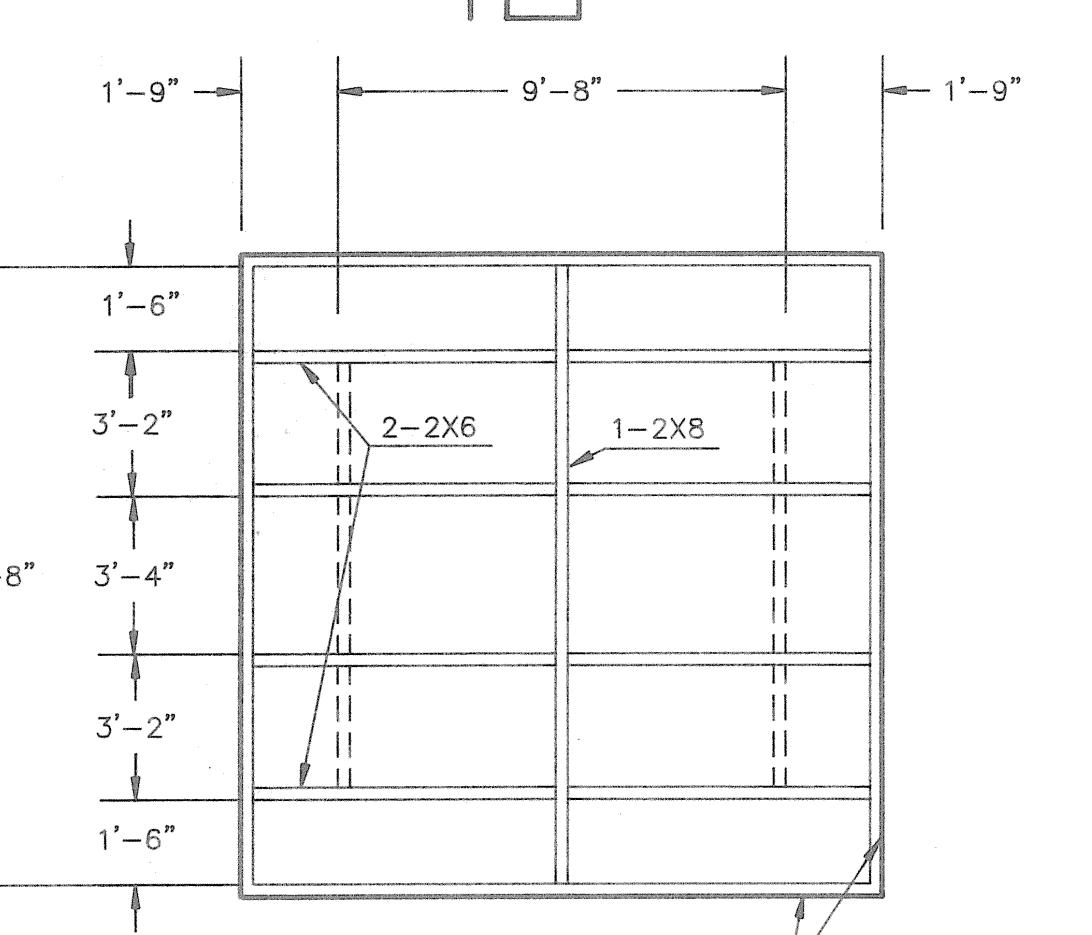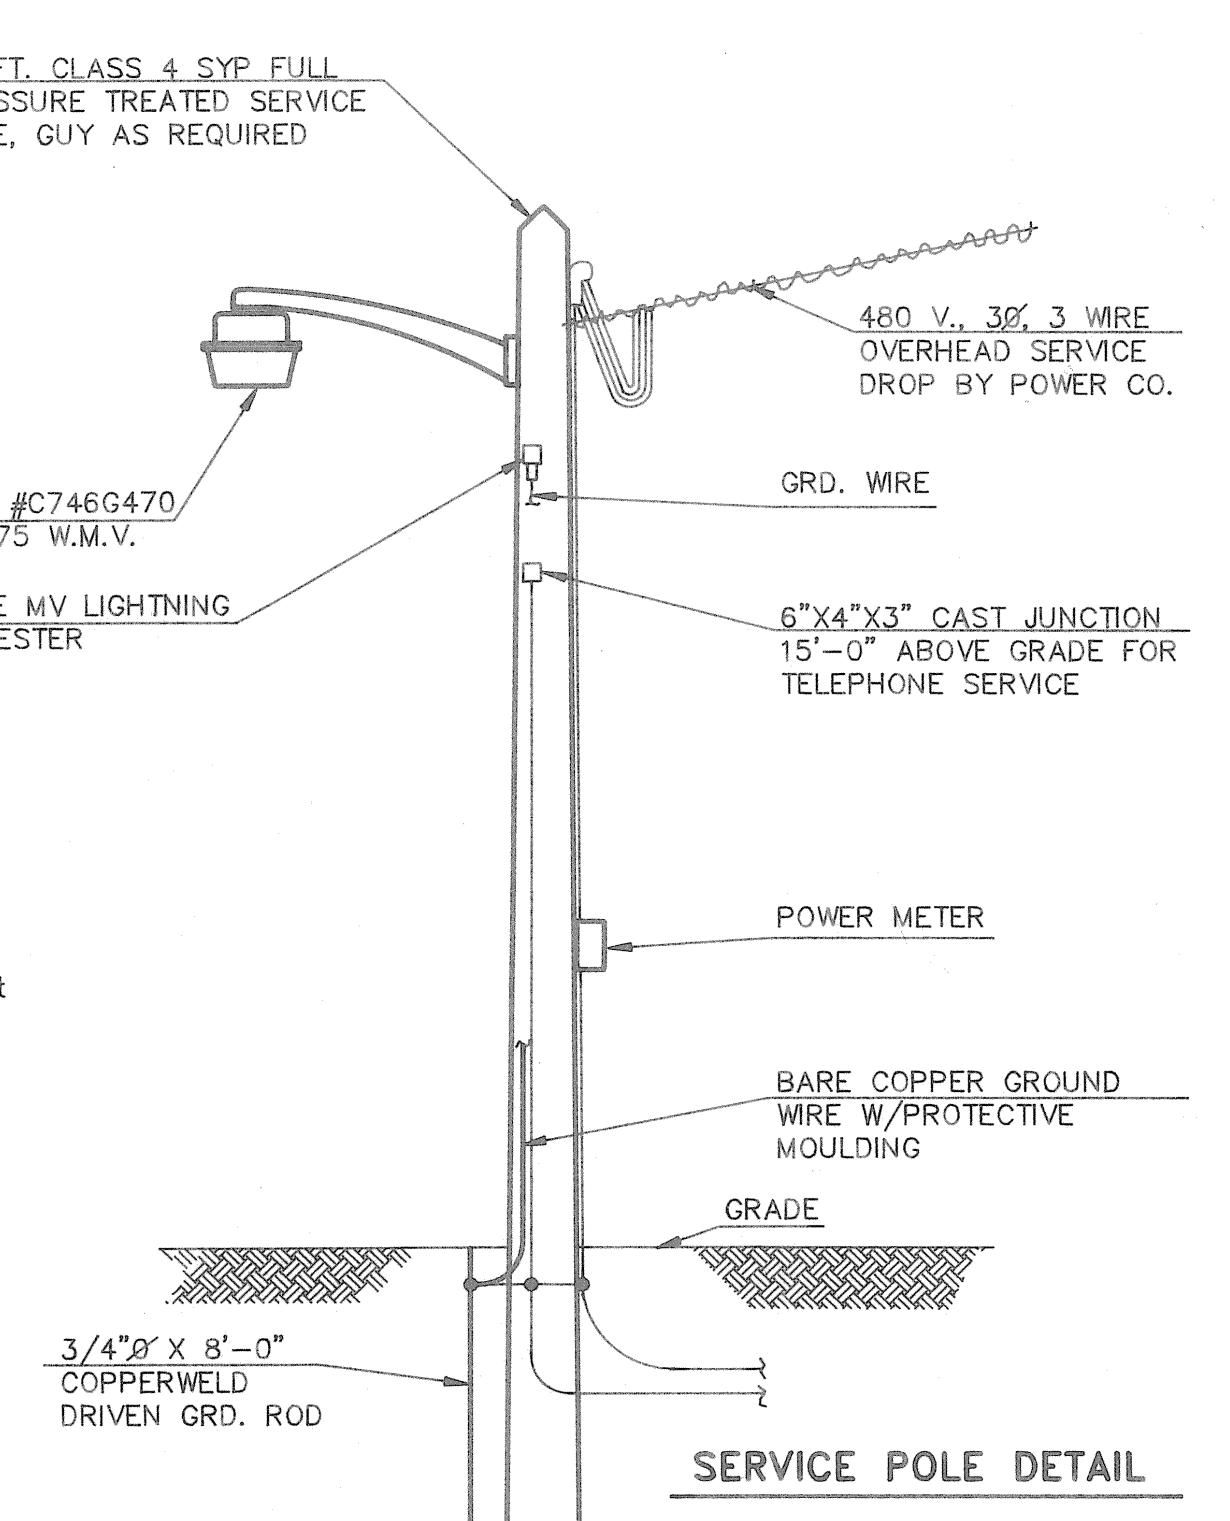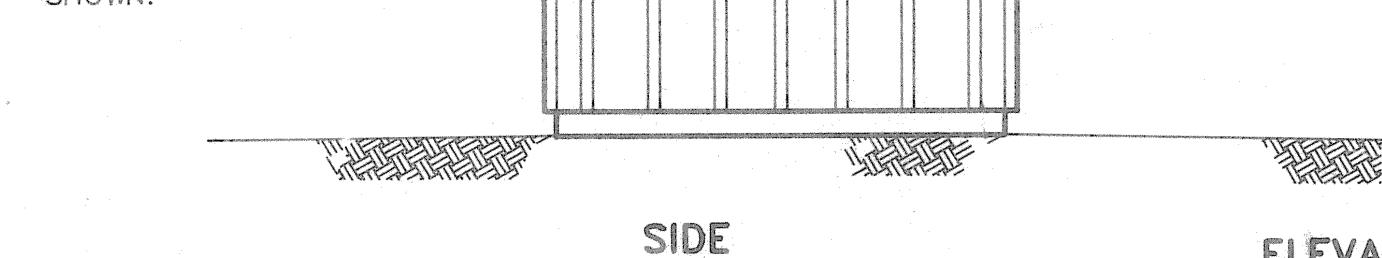

Delaware County, Ohio

EAST ALUM CREEK INTERCEPTOR SANITARY SEWER AND PUMP STATION

Sanitary Sewer, Force Main and Pump Station Improvements
Pump Station, Electrical Notes & Valve Chamber Superstructure Details

SCALE: As Noted
EVANS, MECHWART, HAMBLER Consulting Engineers
d TILTON, INC.
S-2916