



RAKE SECTION
SCALE: 1/2" = 1'

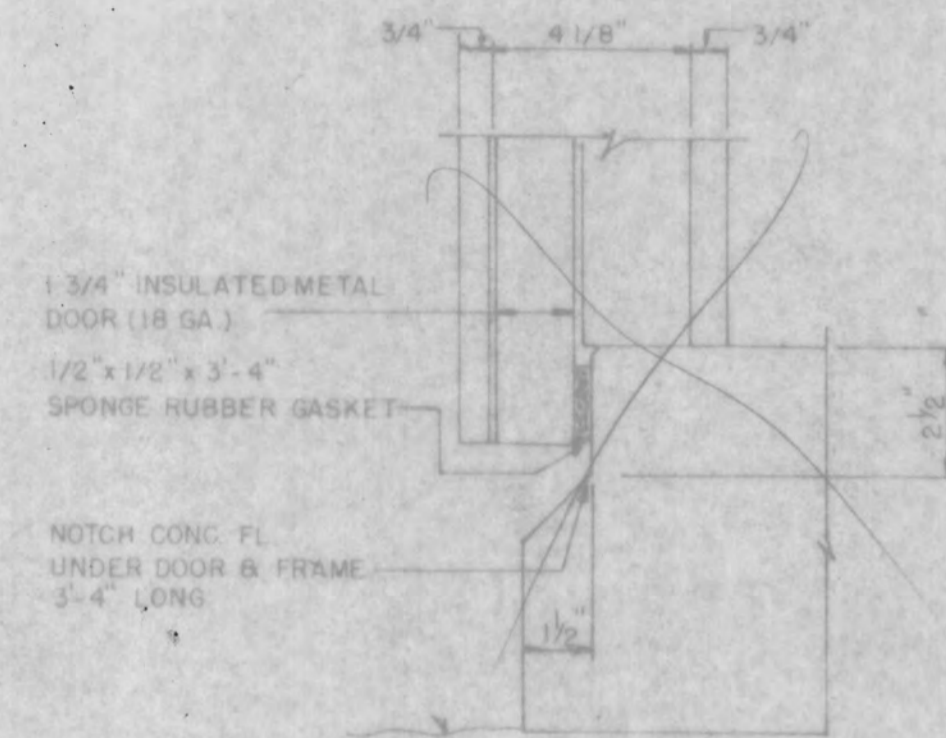


DOOR THRESHOLD DETAIL
SCALE: 3/4" = 1'

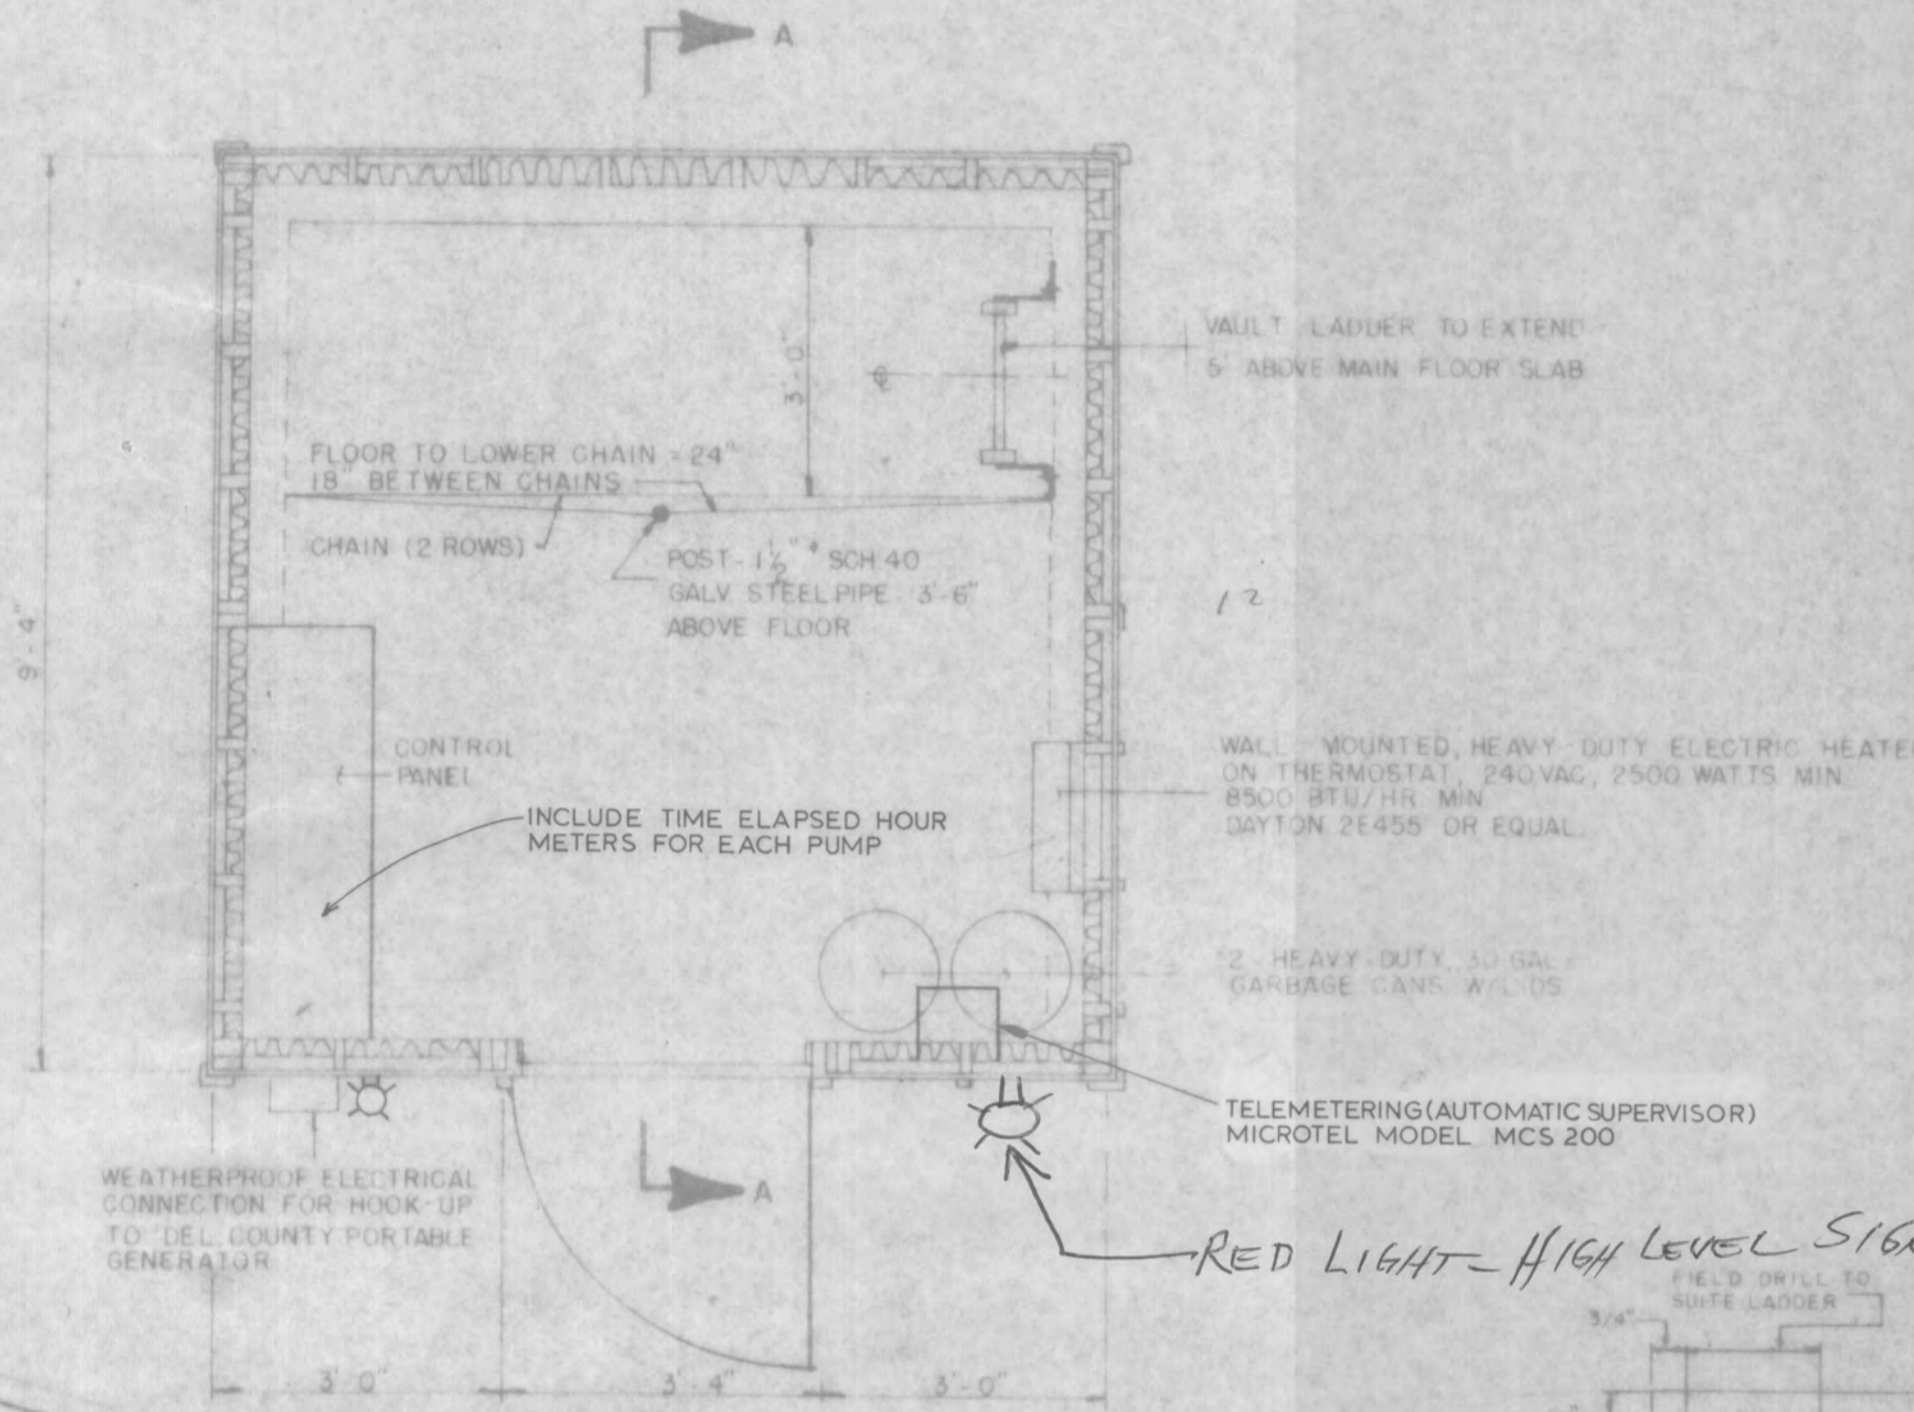


PLAN
SCALE: 1/2" = 1'


CHANGES MADE ON PLANS
IN RED BECOME PART OF
THE PLANS AS APPROVED

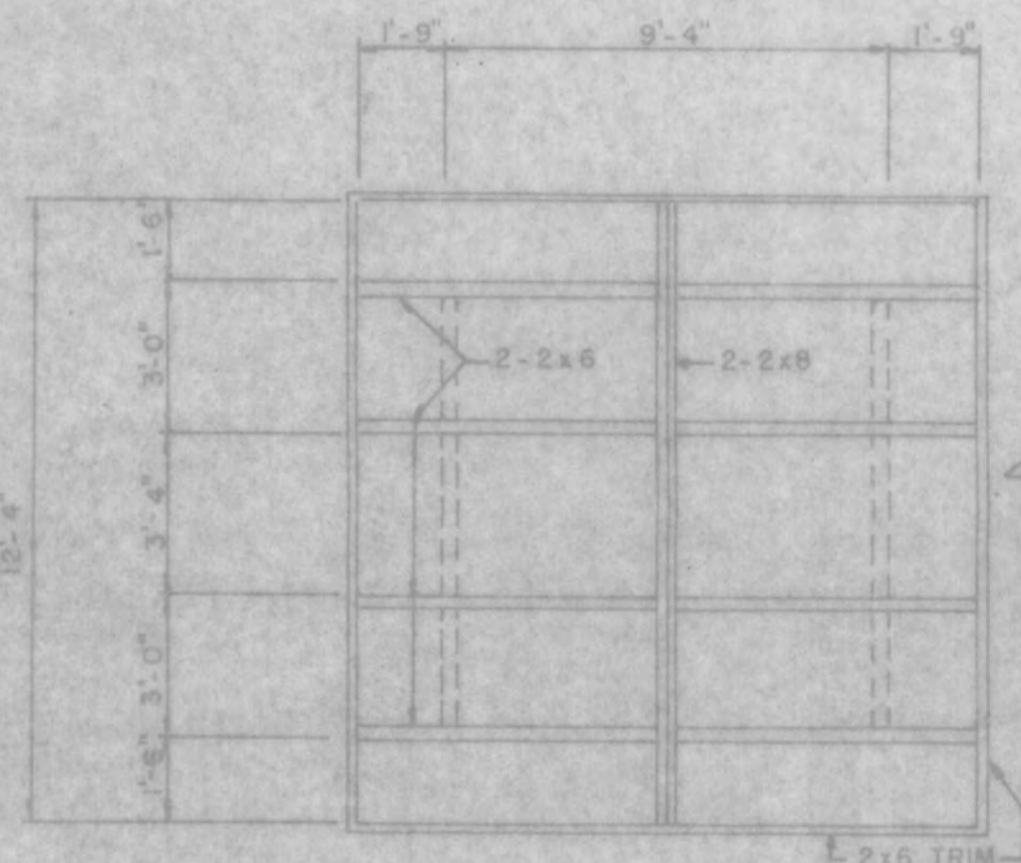


ROOF FRAMING PLAN
SCALE: 1/4" = 1'

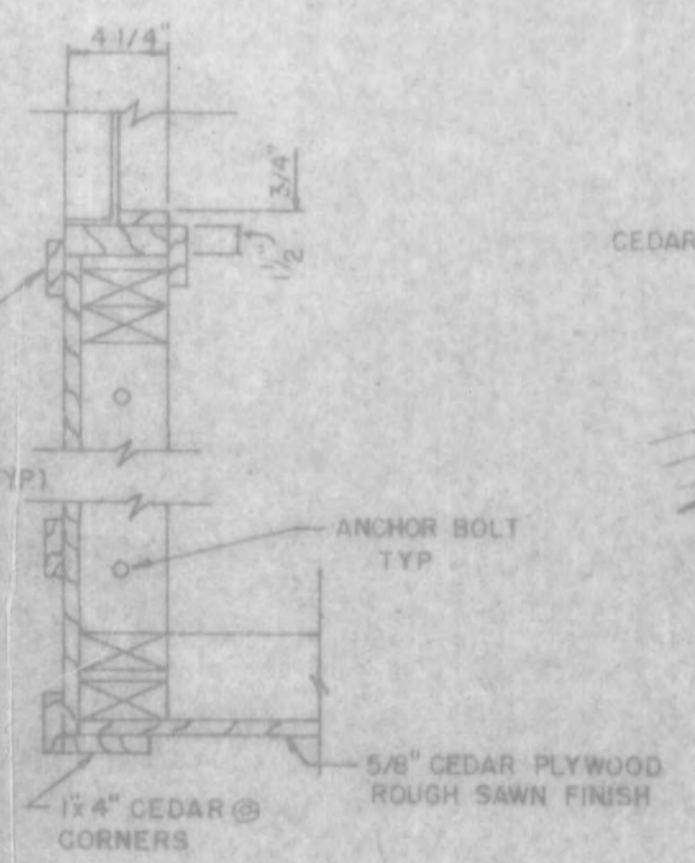


TYPICAL CORNER
SCALE: 1/2" = 1'

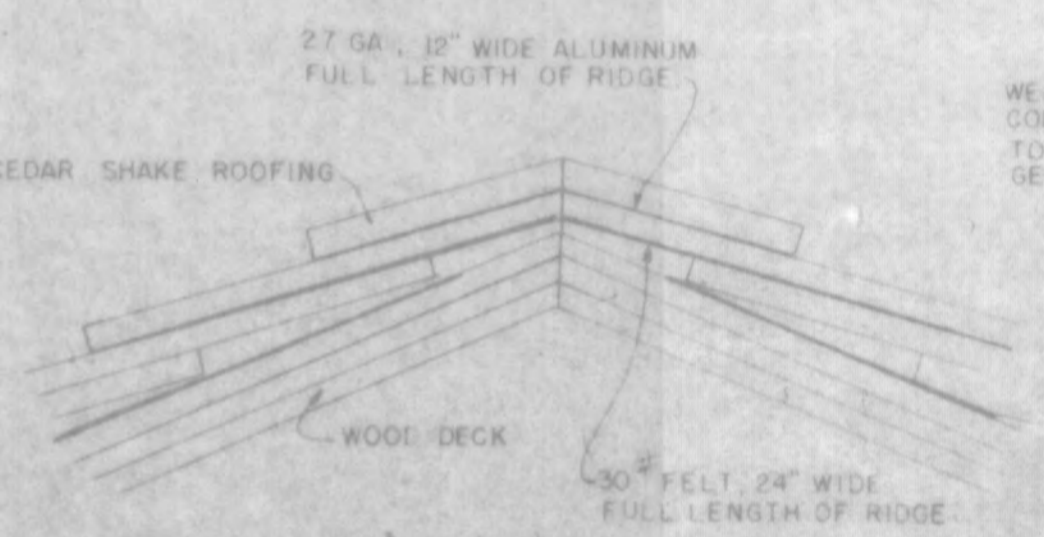


RIDGE DETAIL

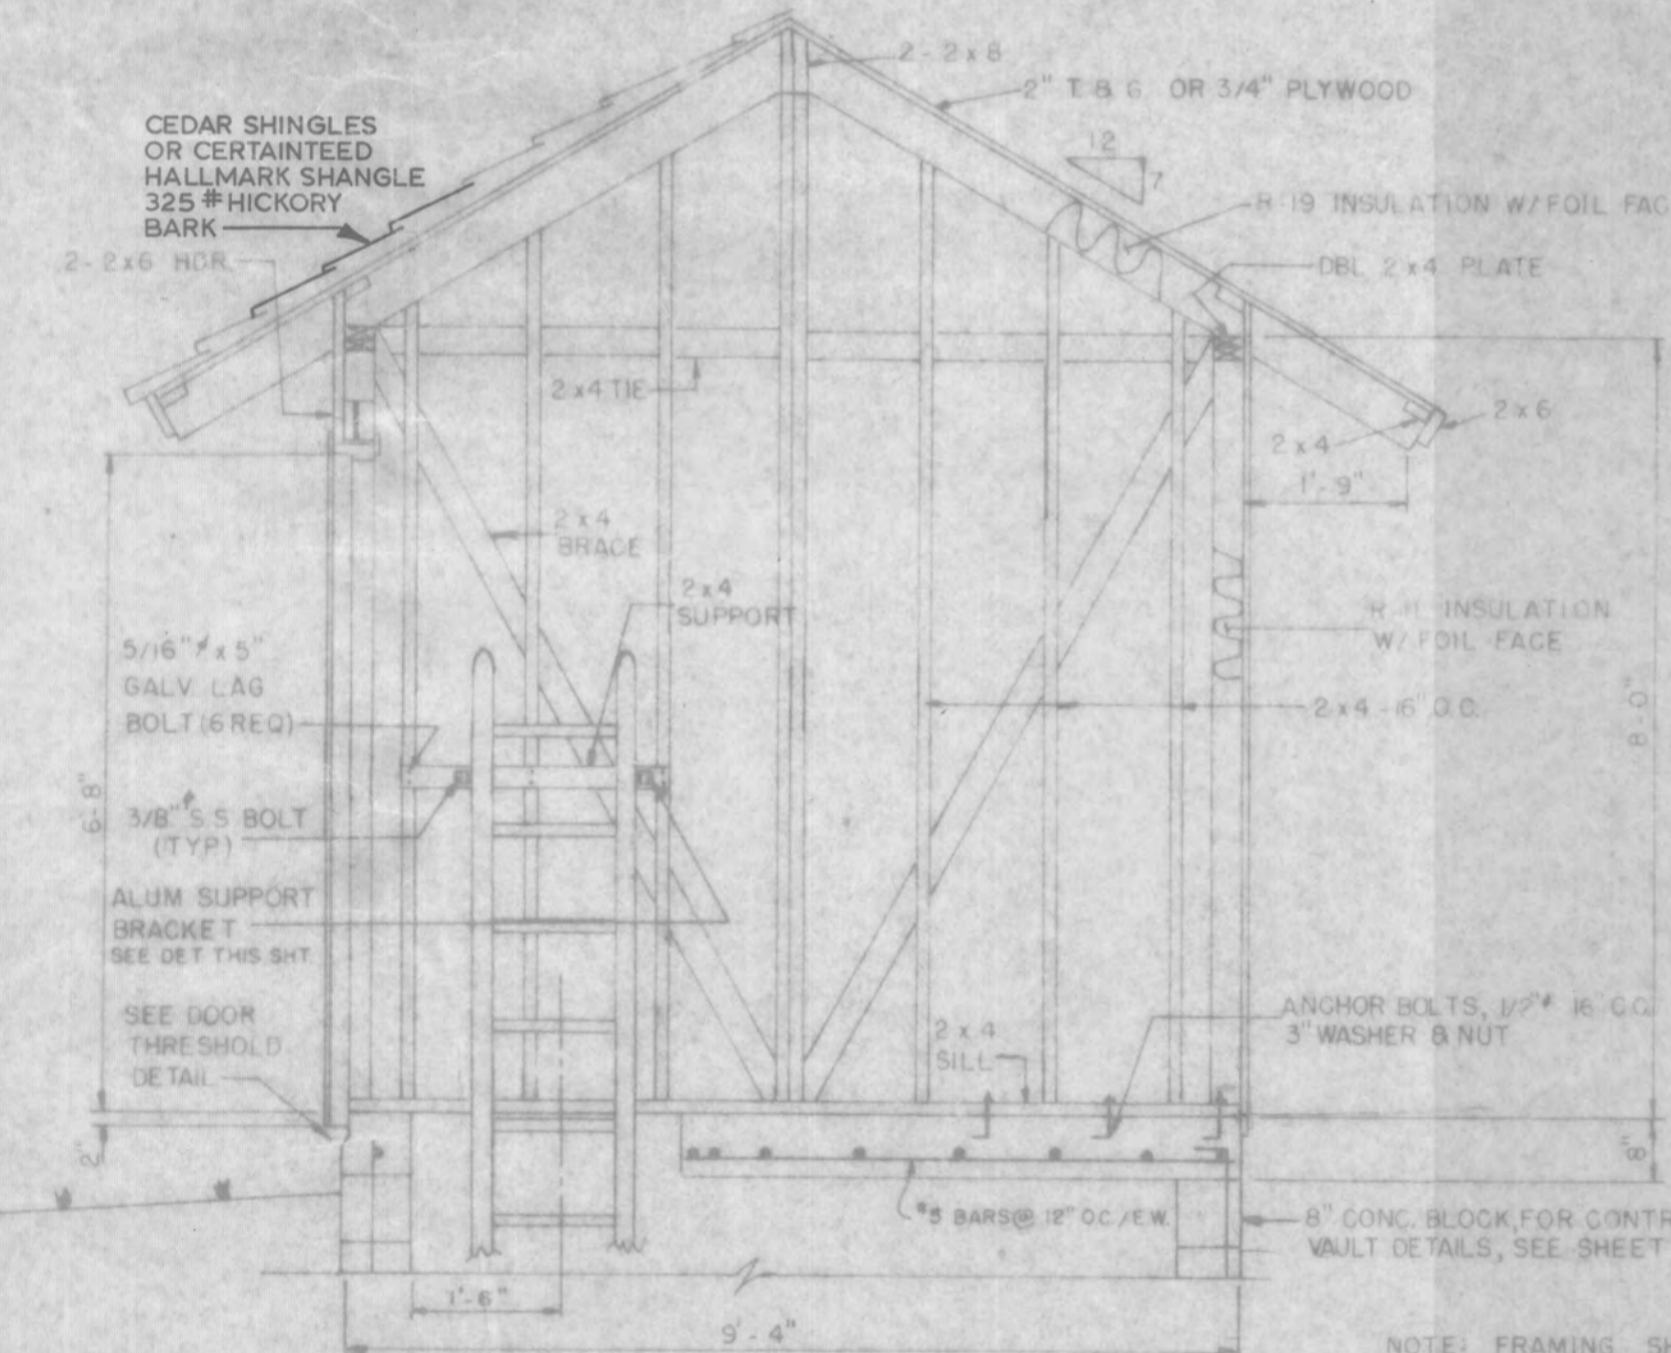


SECTION "A-A"
SCALE: 1/2" = 1'

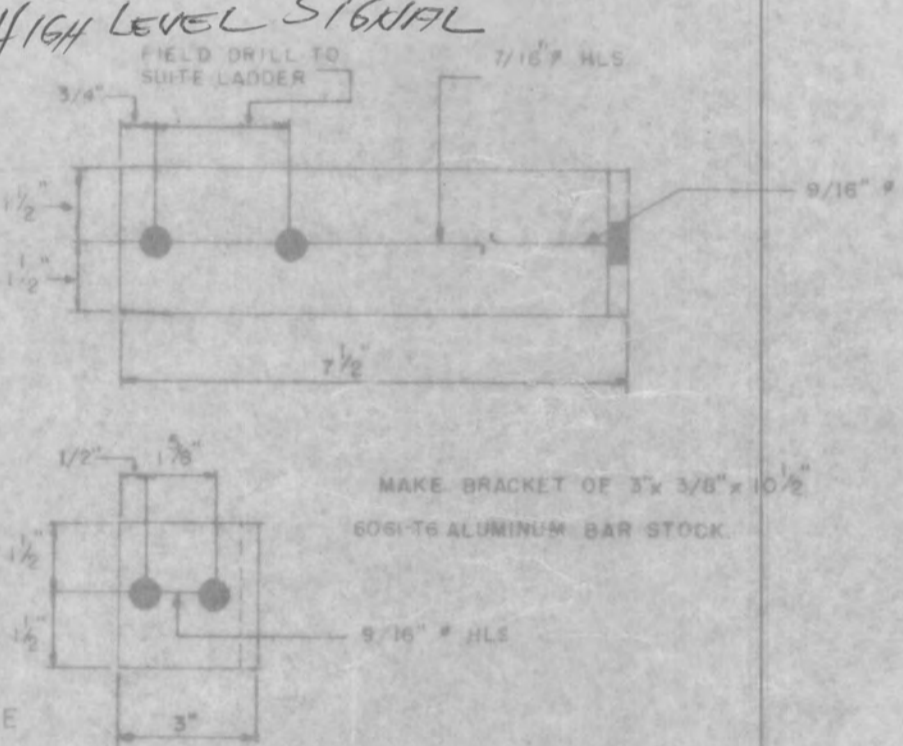

ALUM. SUPPORT BRACKET DETAIL
MAKE THREE AS SHOWN, THREE REVERSE
SIX TOTAL

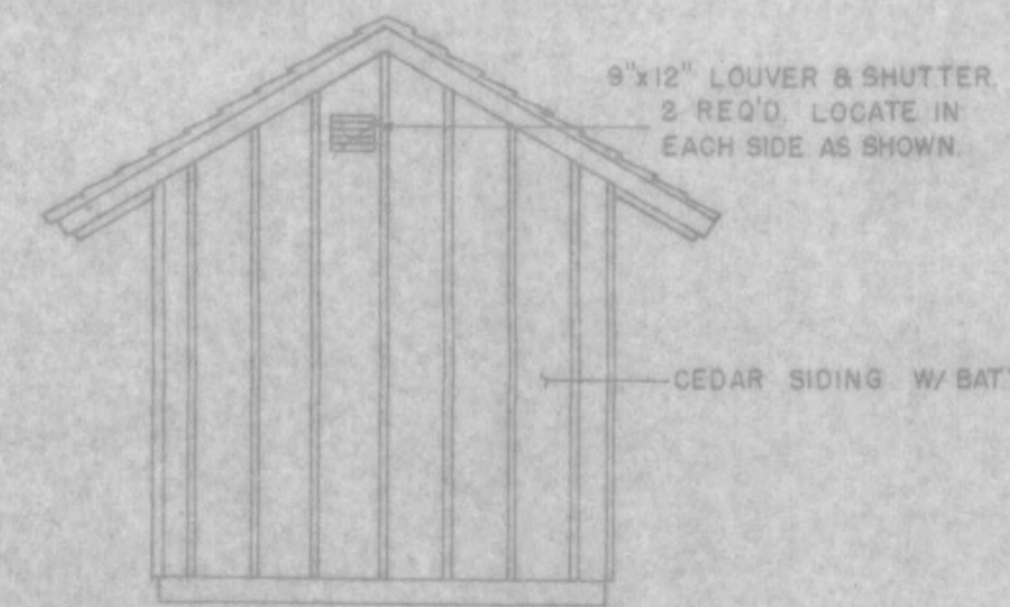


SIDE

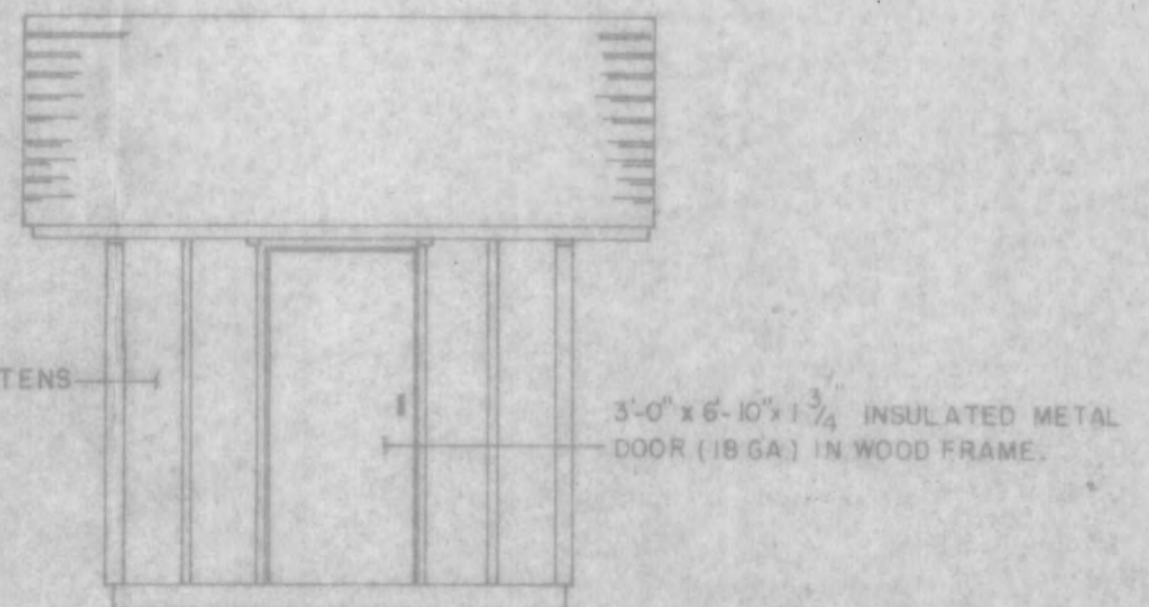

FRONT


ELEVATIONS
SCALE: 1/4" = 1'

NOTE: BUILDING EXTERIOR TO BE STAINED WITH
"OLYMPIC" NATURAL STAIN, CEDAR NATURAL TONE
APPLIED AT RATE OF 1 GAL PER 100 SQ. FT.
12 COATS AT RATE OF 1/2 GAL PER 50 SQ. FT.

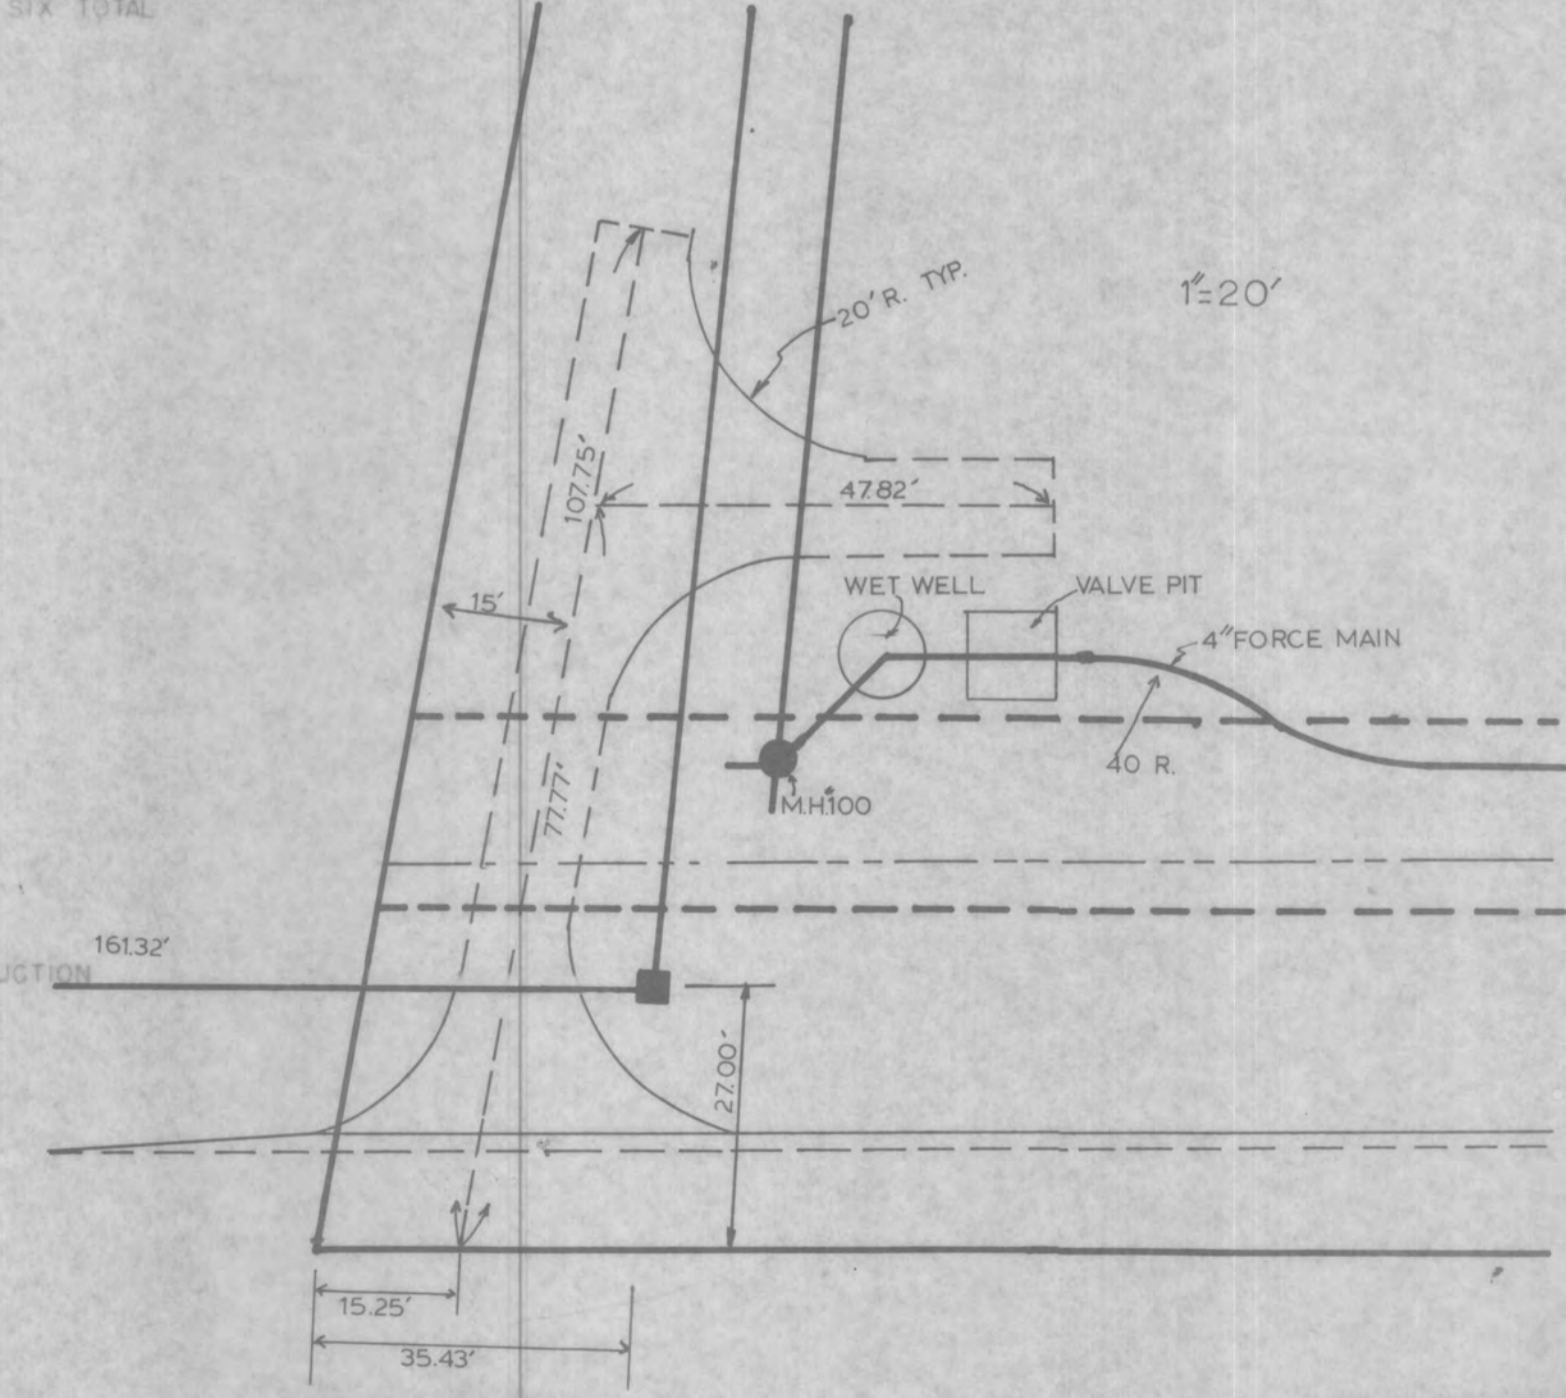

QUAIL MEADOWS LIFT STATION PLAN

HSA

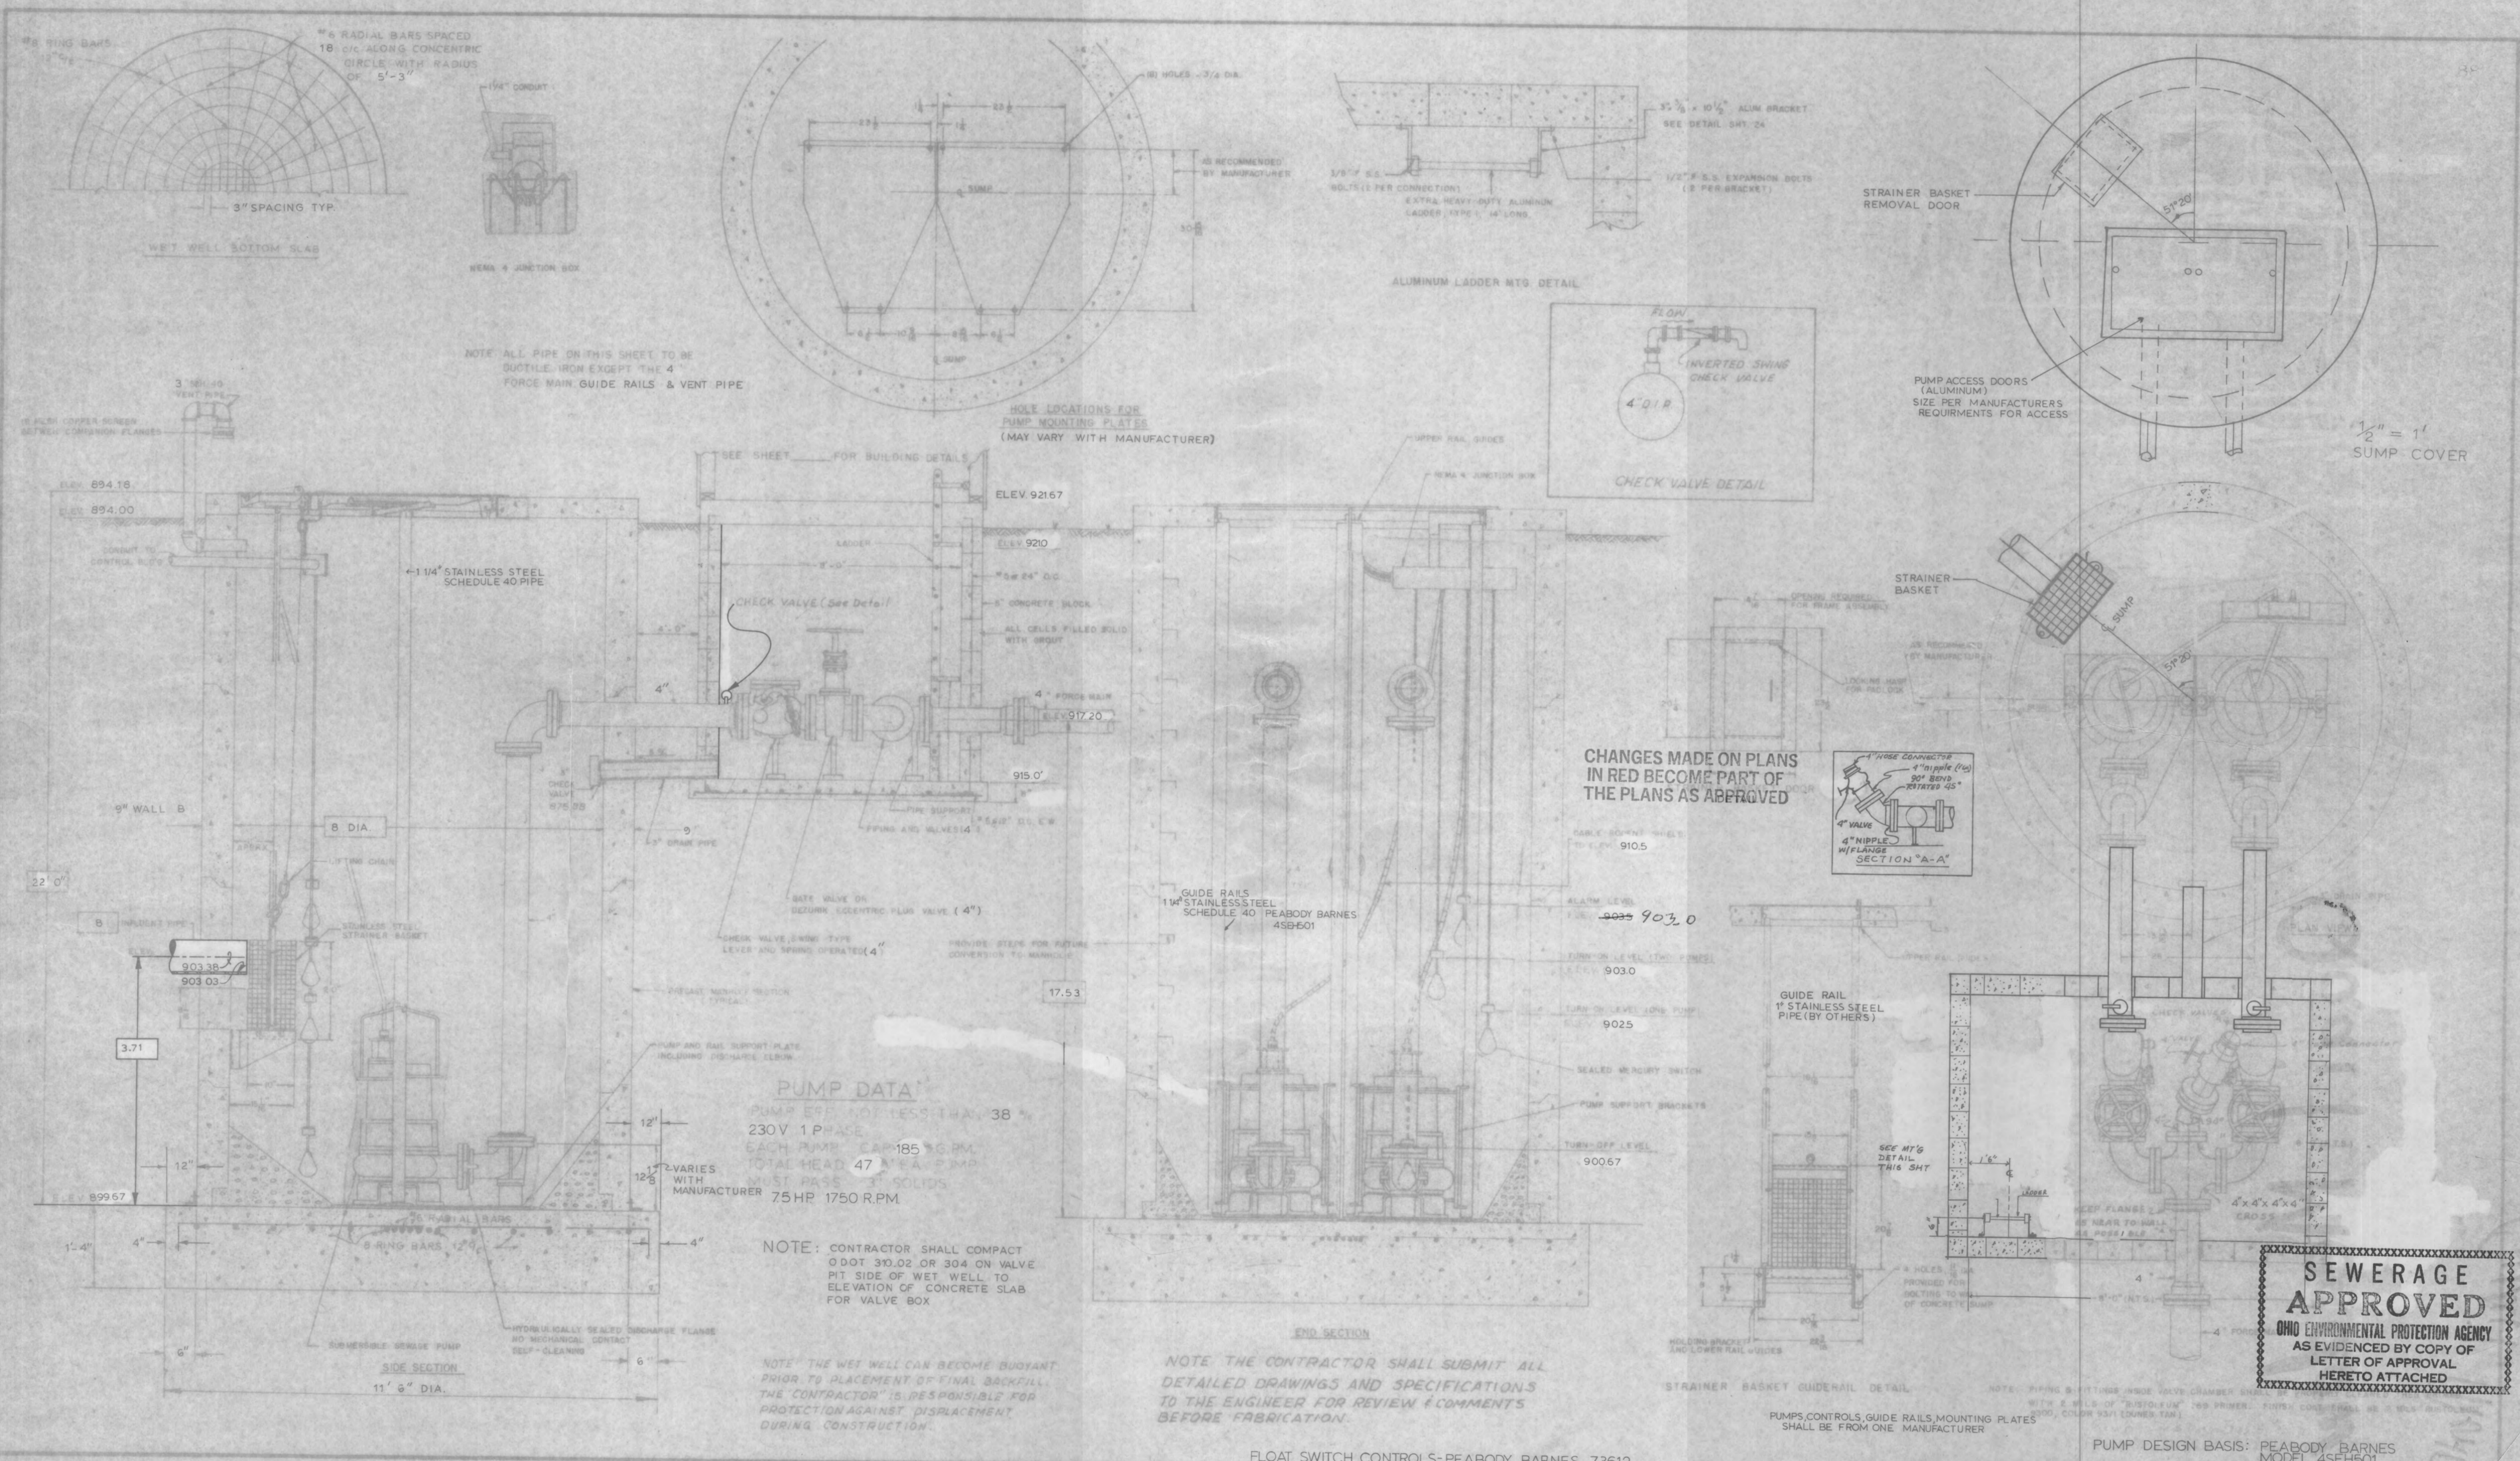

NOTE: ALL PIPE ON THIS SHEET TO BE GUILTY IRON EXCEPT THE 4" FORCE MAIN GUIDE RAILS & VENT PIPE

PUMP DATA

PUMP EFF. NOT LESS THAN 38

230V 1 P. PHASE

EACH PUMP CAP. 185 G.P.M.

TOTAL HEAD 47' @ 1.5 P.M.P.

MUST PASS 3" SOLIDS

75 HP 1750 R.P.M.

CHANGES MADE ON PLANS IN RED BECOME PART OF THE PLANS AS APPROVED

SEWERAGE APPROVED
OHIO ENVIRONMENTAL PROTECTION AGENCY
AS EVIDENCED BY COPY OF LETTER OF APPROVAL HERETO ATTACHED

FLOAT SWITCH CONTROLS-PEABODY BARNES 73612