


UPPER LEVEL ELECTRICAL DEMOLITION PLAN

SCALE: 3/8" = 1' - 0"

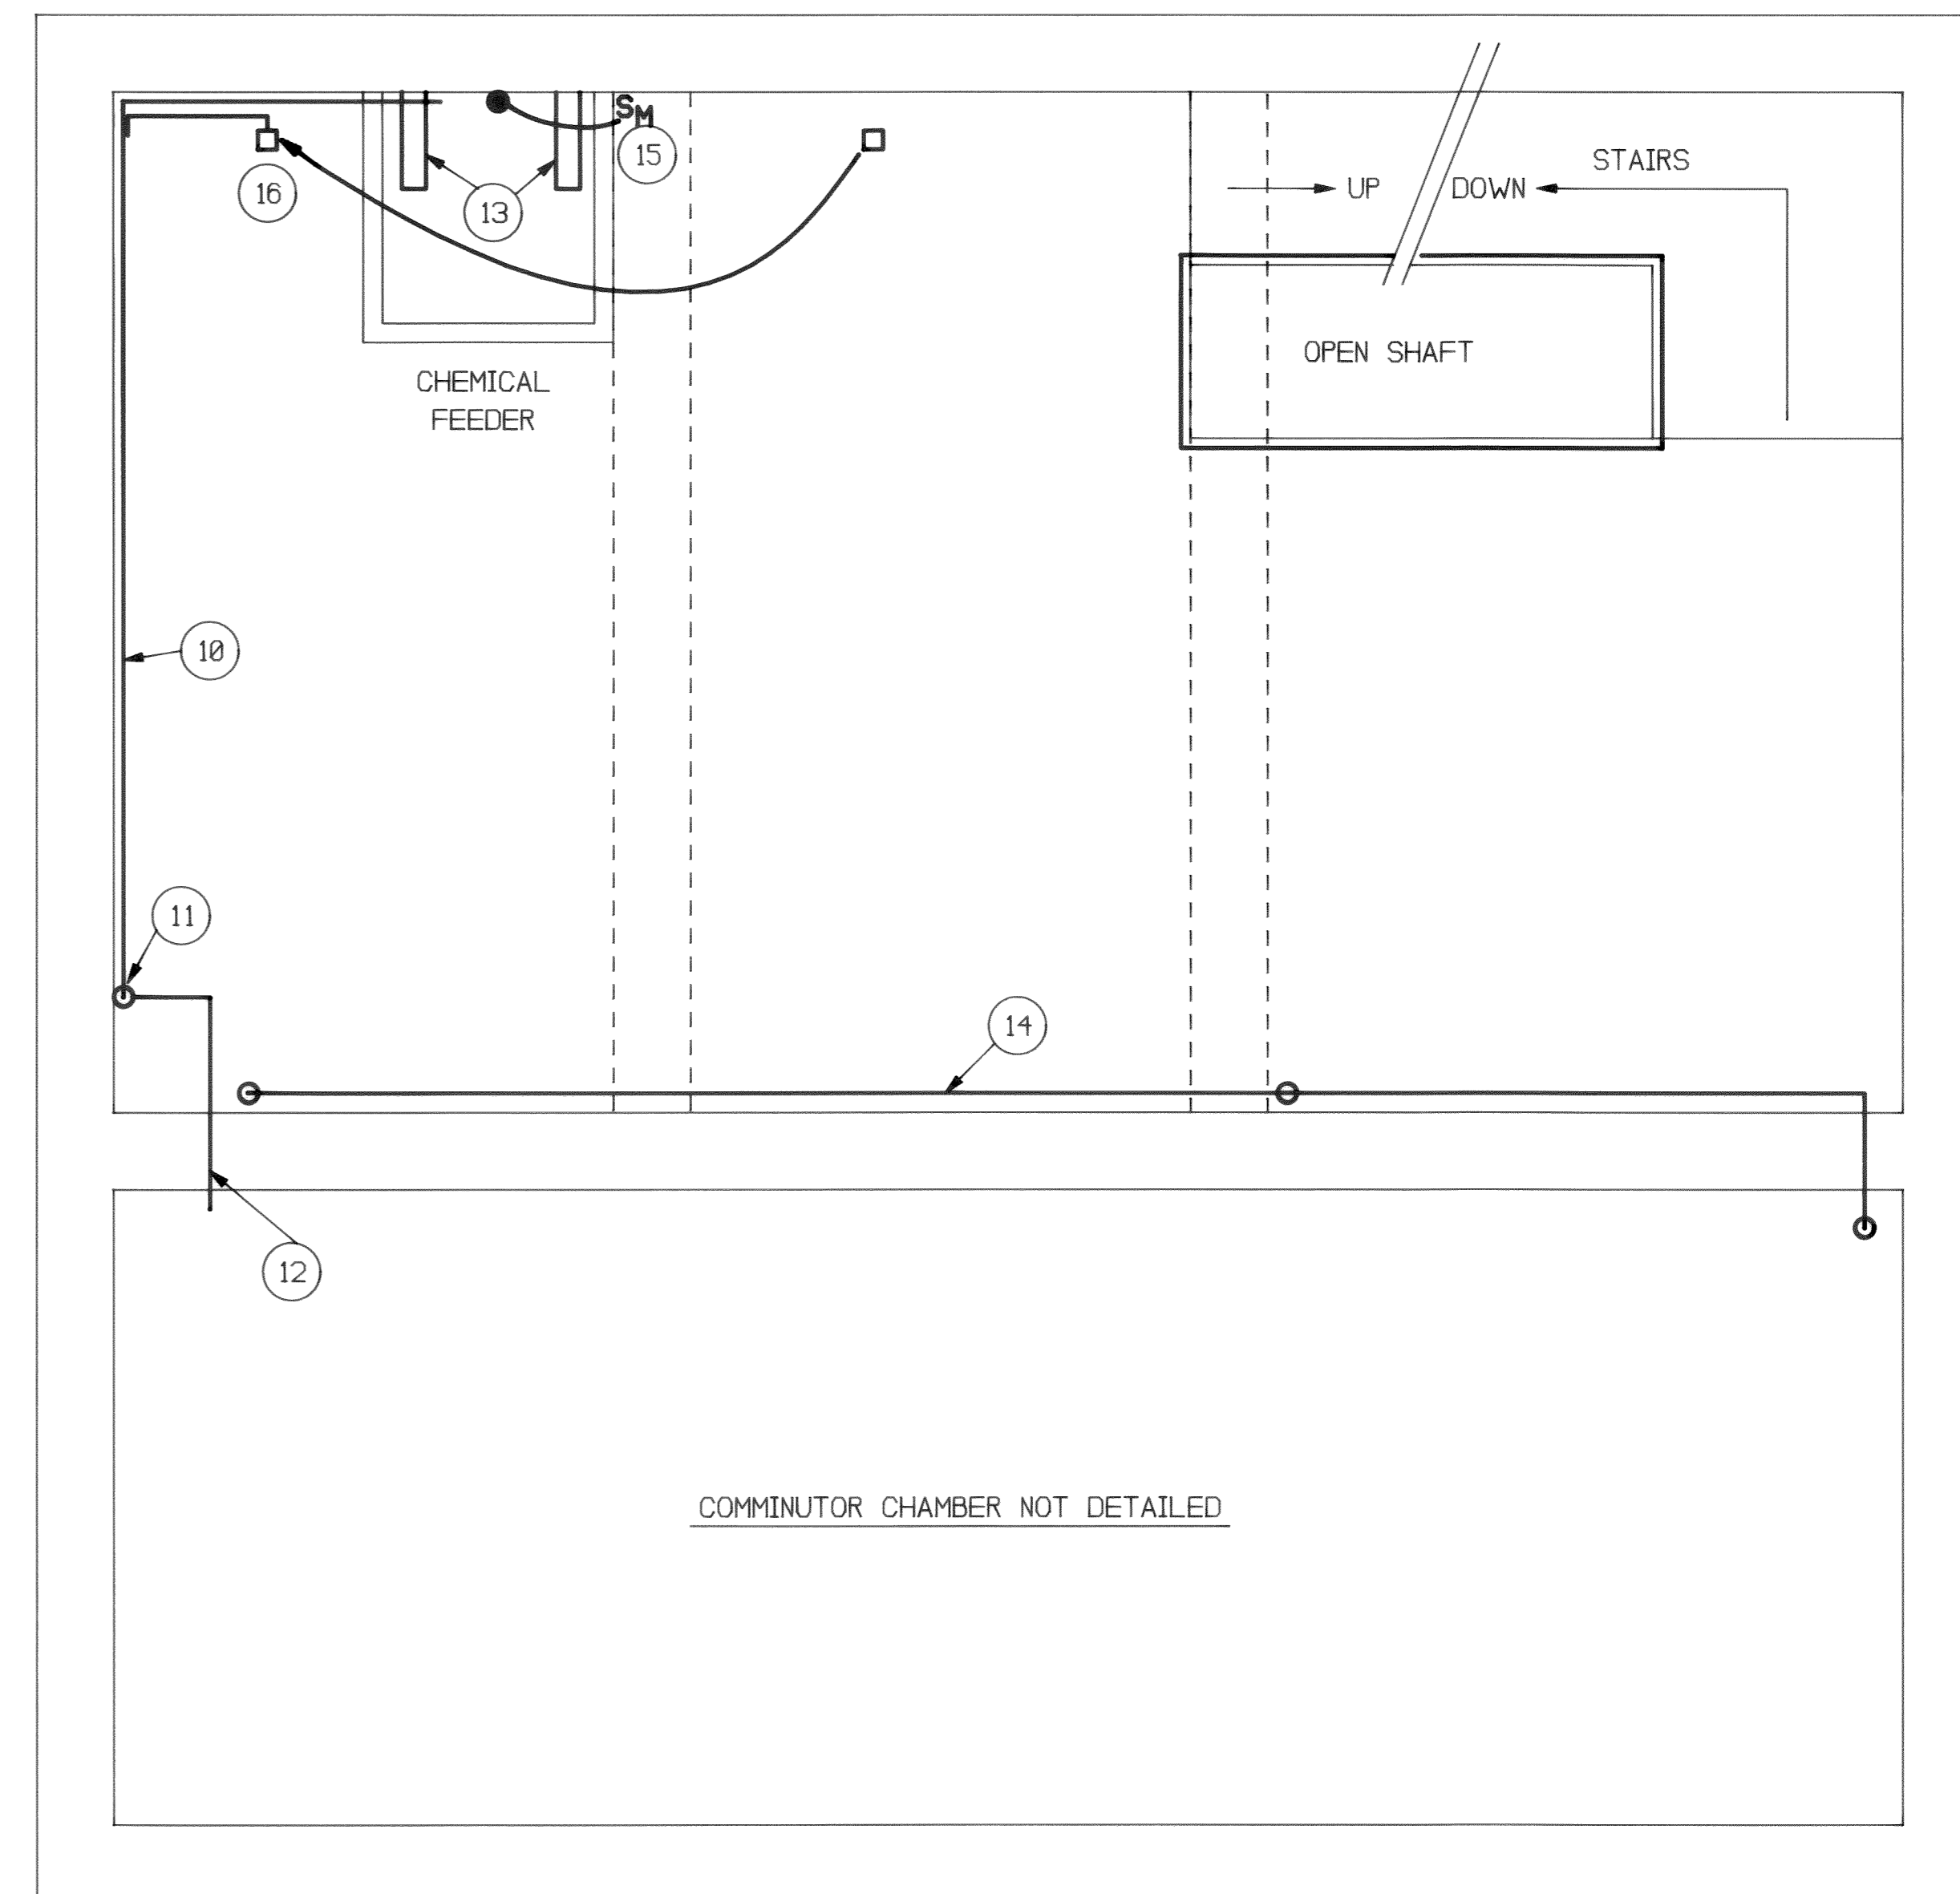

INTERMEDIATE LEVEL ELECTRICAL DEMOLITION PLAN

SCALE: 3/8" = 1' - 0"

GENERAL & DETAILED DEMOLITION NOTES

- ALL OBSOLETED WIRE SHALL BE REMOVED BACK TO THE PANELBOARD OR MOTOR CONTROL CENTER FROM WHICH IT WAS POWERED. CONDUIT WHICH IS ATTACHED TO OR IMBEDDED IN CONCRETE SHALL BE CAPPED. FLEX AND CONDUIT FROM WALLS TO OBSOLETED EQUIPMENT SHALL BE REMOVED.
- ALL ENCLOSURES SHALL BE CLOSED IN AN APPROVED MANNER. PROVIDE CLOSURE PLUGS, PIPE CAPS, PIPE PLUGS AS APPROPRIATE. PROVIDE BLANK COVER PLATES ON UNUSED OUTLET BOXES.
- CLOSE ALL HOLES AND PENETRATIONS IN CONCRETE AND BLOCK WITH NON-SHRINK GROUT. RESTORE SURFACE TO THE CONDITION OF NEARBY SURFACE TREATMENT, INCLUDING PAINT RESTORATION.
- EXISTING AUTOMATIC TRANSFER SWITCH PORTION OF SWITCHGEAR TO REMAIN IN USE. REMOVE HORIZONTAL BUS AT TOP OF SECTION TO PROVIDE SPACE FOR PROPOSED FEEDER CONDUCTORS TO PROPOSED MCC. CUSTOM FABRICATE PULL BOX FOR ATS. REROUTE CONTROL CABLES TO GENERATOR START CONTROLS AS REQUIRED.
- EXISTING MOTOR CONTROL CENTER (EXCEPT AUTOMATIC TRANSFER SWITCH SECTION) TO BE REMOVED. OWNER WILL DESIGNATE THOSE PORTIONS OF THE OBSOLETE MCC TO BE RETAINED BY OWNER. REMAINDER OF MCC TO BE REMOVED BY CONTRACTOR AS CONTRACTOR DEBRIS.
- EXISTING PUMP 4 CONTROLLER TO BE CONVERTED INTO LEVEL CONTROL PANEL ONLY. OWNER CLAIMS A-B SMC CONTROLLER LOCATED IN PANEL. OBSOLETED ALLEN BRADLEY SMC CONTROLLER IS OF VERY HIGH VALUE. IT SHALL BE PROTECTED FROM DAMAGE AND TURNED OVER TO OWNER IN OPERATING CONDITION.
- THESE ITEMS OF EQUIPMENT, ALONG WITH SUPPORTING WIRE AND CONDUIT ARE TO BE RELOCATED FROM THE POSITION TO BE OCCUPIED BY PROPOSED MOTOR CONTROL CENTER.
- POSITION OF PROPOSED MOTOR CONTROL CENTER.
- REMOVE EXISTING T CONDULET AND OUTLET BOX WHICH WOULD OTHERWISE BE BEHIND MCC. EXTEND CONDUIT SO THAT REPOSITIONED OUTLET BOX IS TO THE RIGHT OF MCC BELOW HANDRAIL. PULL NEW CABLE SO THAT THERE IS NO SPLICE IN AN INACCESSIBLE OUTLET. NEW BOX TO BE APPLETON FDS.
- REMOVE CHEMICAL FEED LINE (YELLOW PIPE), VALVES, FITTINGS, ANCHORS. GROUT ANCHOR HOLES AND ALL WALL AND FLOOR PENETRATIONS WITH NON SHRINK GROUT. GROUTINGS SHALL BE WATER AND AIR TIGHT.
- LINE DOWN TO EFFLUENT LINE. REMOVE CHEMICAL LINE FROM EFFLUENT PIPE AND PLUG. EXERCISE CAUTION TO PREVENT DRAINING OF FORCE MAIN BACK INTO DRY WELL.
- CHEMICAL FEED LINE INTO WET WELL. REMOVE AND GROUT HOLE CLOSED.
- REMOVE WALL BRACKETS AND ANCHORS. GROUT OPENINGS.
- REMOVE OLD BUBBLER LINE (GREEN) WITH ALL VALVES, FITTINGS, ANCHORS, DROP TUBES. GROUT ALL HOLES (ANCHOR, FLOOR, WALLS) WITH NON-SKRINK GROUT. PENETRATIONS TO BE WATER AND GAS TIGHT. REMOVE TWO DROP TUBES IN WET WELL.
- REMOVE MANUAL MOTOR SWITCH AND FLEX. INSTALL FD BOX AND CAP WIRES.
- RELOCATE EXISTING UNIT HEATER THERMOSTAT TO THIS POSITION SOUTH OF WATER DROP.
- REMOVE EXISTING COMMUNOTOR CONNECTION, CABLE AND EXPOSED CONDUIT TO DISCONNECT SWITCH. CUT UNUSED EXPOSED CONDUIT FLUSH WITH SLAB AND GROUT SHUT. PRESERVE HOME RUN CONDUIT TO EXISTING MCC FOR REUSE.
- CLEAN AND PAINT WALL BEHIND REMOVED MCC TO MATCH EXISTING WALL TREATMENT. CLEAN CONCRETE CURB AND PAINT TO MATCH WALL TREATMENT.
- ALL BOX, CONDULET, AND SIMILAR RACEWAY ACCESS COVERS SHALL BE ACCESSIBLE AND SHALL NOT REQUIRE THE MOVING OF EQUIPMENT, PIPING, CONDUIT OR OTHER BUILDING FEATURES TO GAIN ACCESS. ENTEND CONDUITS AND PULL NEW WIRE WHERE REQUIRED TO ACCOMPLISH THIS REQUIREMENT. REMOVE BOXES AND CONDULETS MADE INACCESSIBLE BY NEW CONSTRUCTION.

SPECIAL NOTICE


CONTRACTOR SHALL TAKE WHATEVER ACTION IS NECESSARY TO INSURE THAT AT LEAST TWO PUMPS ARE AVAILABLE FOR OPERATION AT ALL TIMES DURING THE CONSTRUCTION PROJECT. WITHOUT LIMIT THIS INCLUDES: PROVIDING TEMPORARY POWER, TEMPORARY PUMP CONTROL PANEL, TEMPORARY EMERGENCY POWER GENERATOR CONNECTIONS TO EXISTING OR PROPOSED MCC, NIGHT OPERATOR FOR MANUAL CONTROL OF PUMPS OR MANUAL TRANSFER OF LOADS TO ALTERNATE POWER SOURCES, AND ALL REQUIRED LABOR, MATERIAL AND EQUIPMENT. OWNER SHALL REVIEW ALL SEQUENCE OF CONSTRUCTION AND APPROVE OR DISAPPROVE OF ANY ACTIONS WHICH IN HIS SOLE OPINION JEOPARDIZES THE SOUND OPERATION OF THE PUMPING STATION. CONTRACTOR SHALL INCLUDE IN HIS BID PRICE THE COST OF ALL OF THESE REQUIREMENTS.

DELAWARE COUNTY, OHIO


ALUM CREEK PUMPING STATION



ELECTRICAL REVISIONS - 1994

HOFFMAN ENGINEERING CO.
CONSULTING ELECTRICAL & INSTRUMENTATION ENGINEERS
WESTERVILLE, OHIO
TEL: (614) 898-6272, FAX: (614) 794-2030

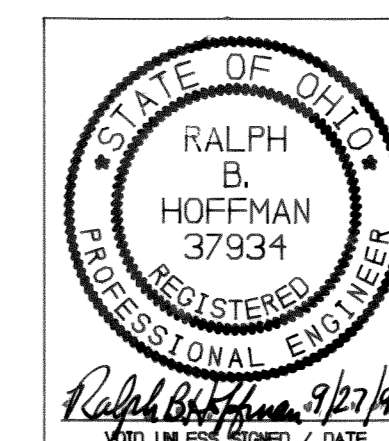

09/15/94
9409BE1
E1

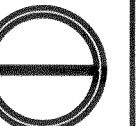

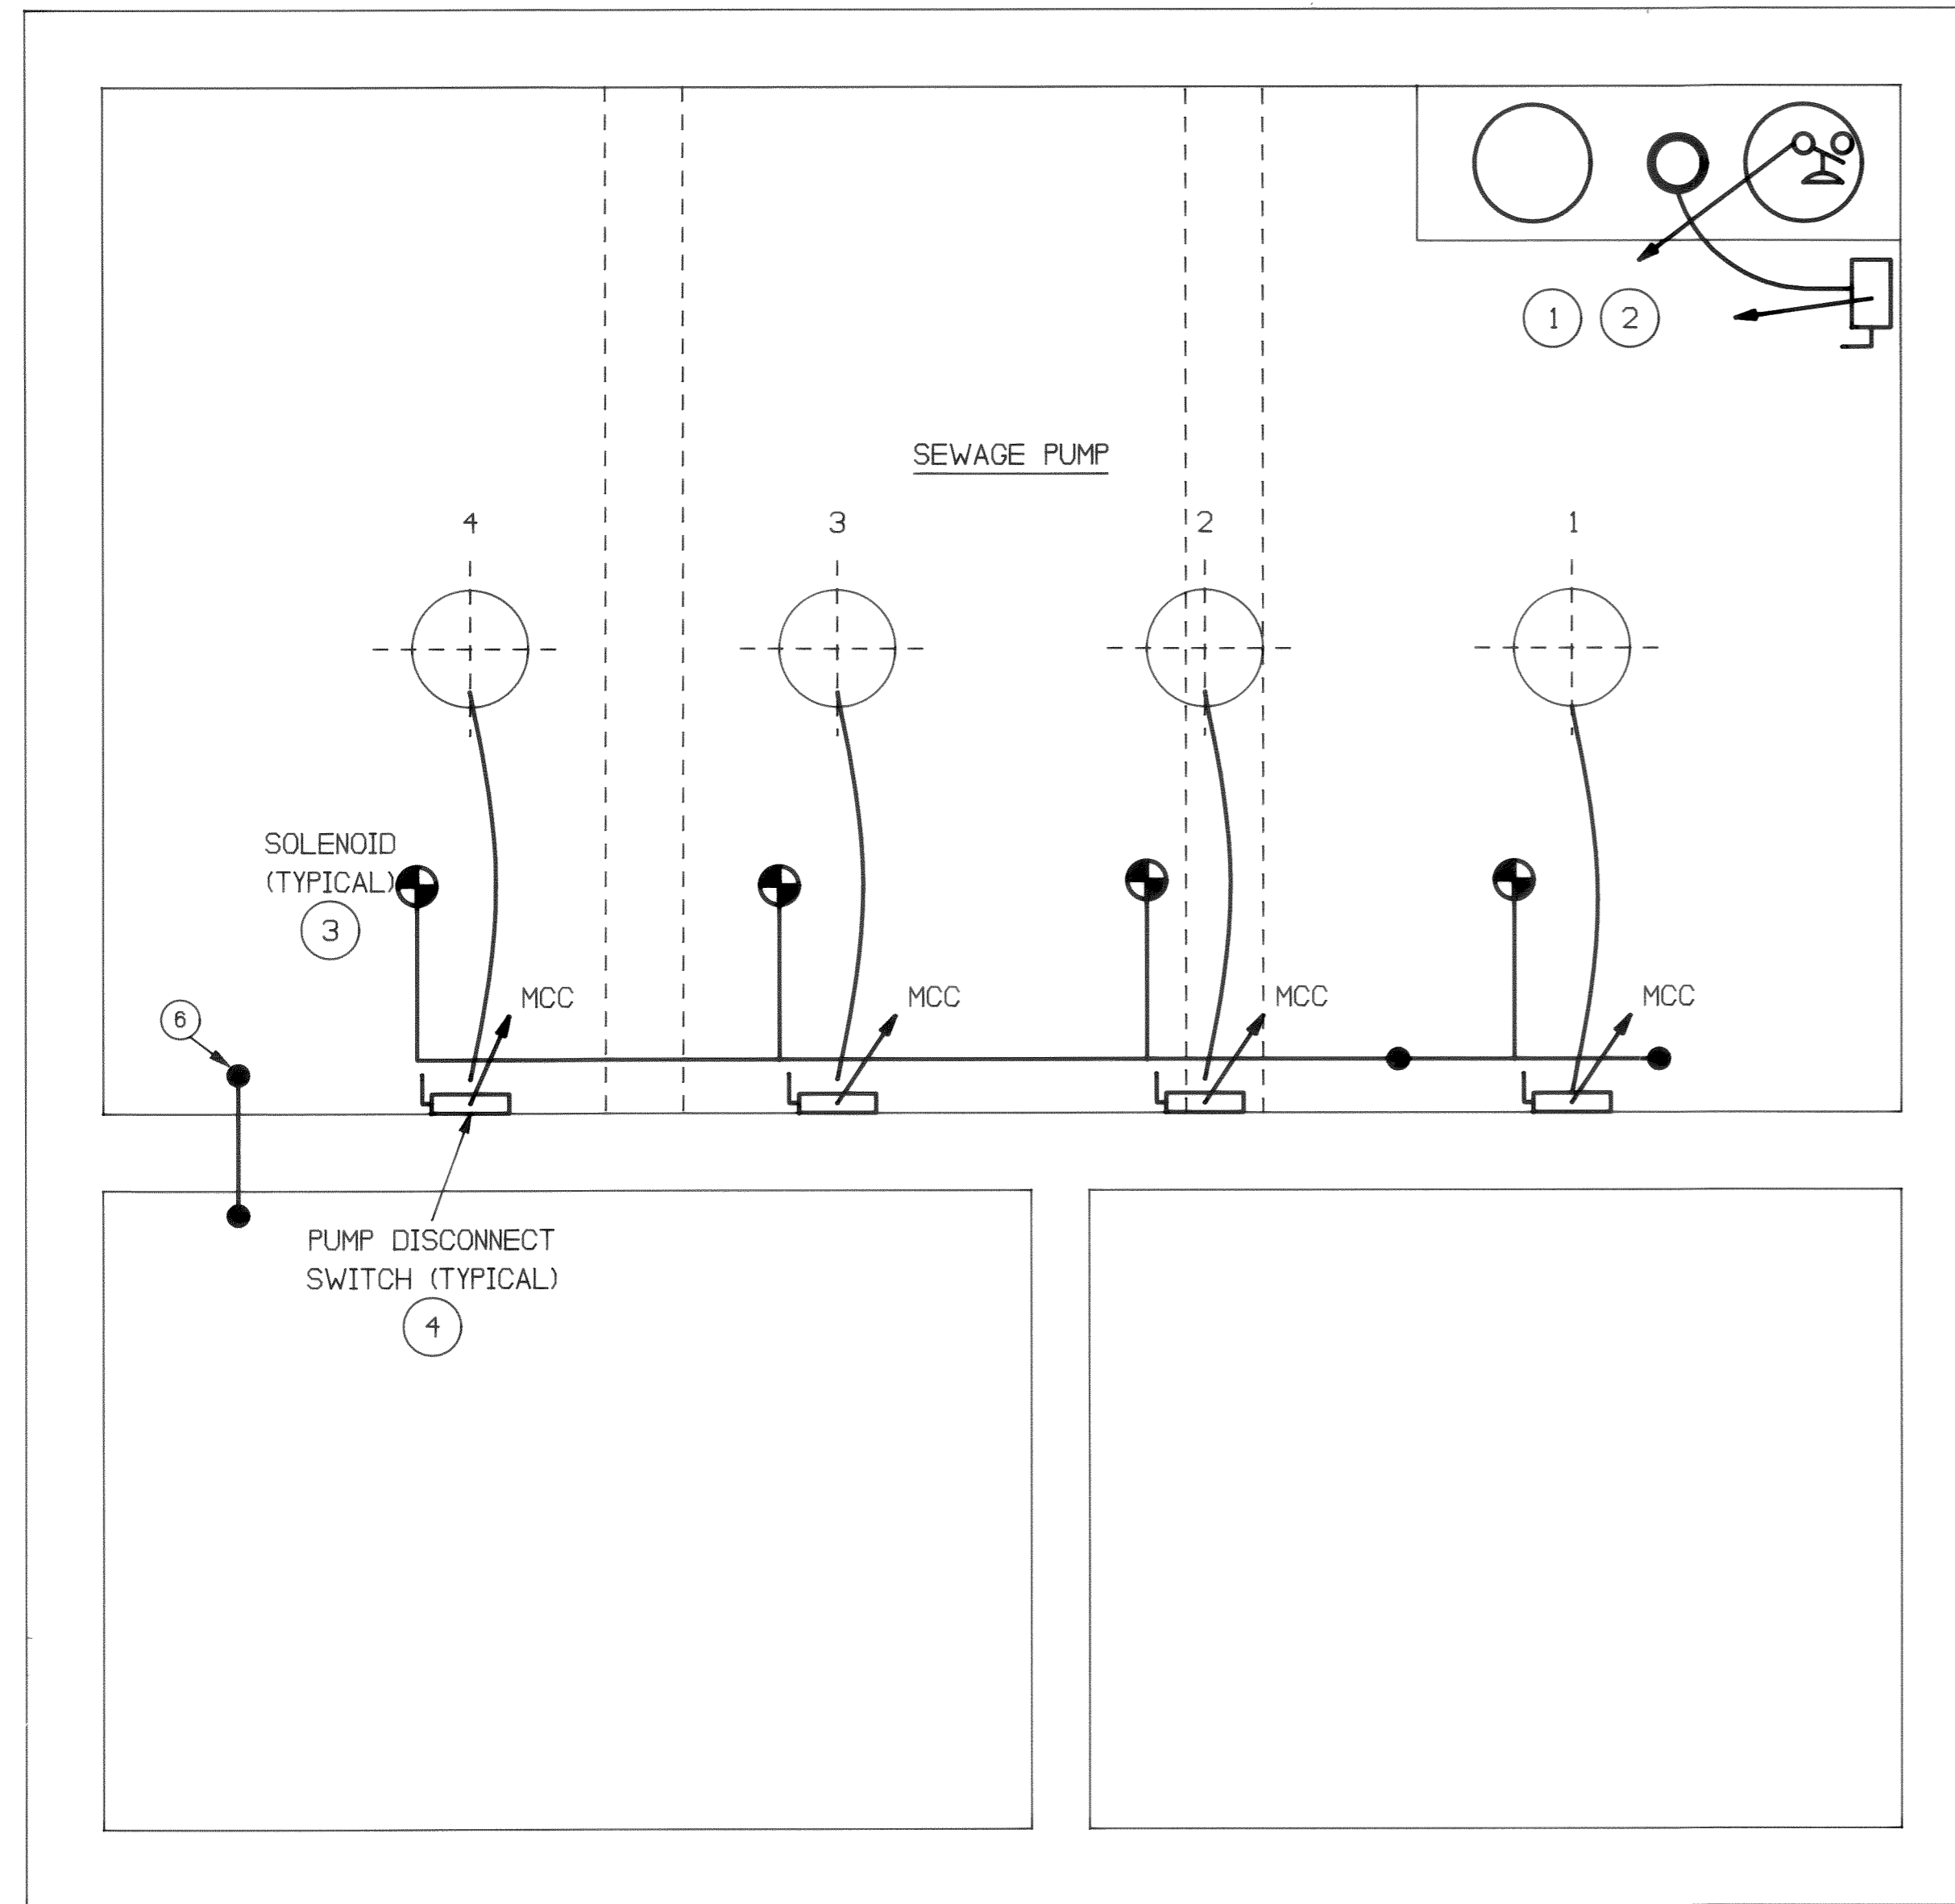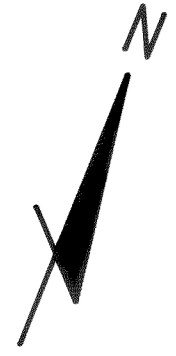


LOWER LEVEL ELECTRICAL DEMOLITION PLAN

SCALE: 3/8" = 1' - 0"

NOTES



1. DEMOLITION: REMOVE WATER SEAL PUMP ELECTRIC FINAL CONNECTION BACK TO DISCONNECT SWITCH. REMOVE PRESSURE SW. FINAL CONNECTIONS. REMOVE WIRE FOR SEAL PUMP MOTOR AND P.S. BACK TO MCC. CAP CONDUIT ENDS AND CLOSE UNUSED OPENINGS IN ENCLOSURES.
2. DEMOLITION: REMOVE WATER SEAL PRESSURE TANK, ISOLATION TANK, PUMP, SUPPLY AND PUMP PIPING, PUMP SOLENOIDS, FITTINGS, ANCHORS.
3. DEMOLITION: REMOVE PUMP SOLENOID FINAL CONNECTIONS. REMOVE SOLENOID WIRES BACK TO MCC. CAP CONDUITS AT T'S ON WALL. REMOVE CONDUIT TO PUMP STANDS. CLOSE OPENINGS IN ENCLOSURES AND BOXES.
4. DEMOLITION: REMOVE PUMP MOTOR DISCONNECT SWITCHES (QTY. 4). REMOVE CONDUITS & CABLES BACK TO MCC.
5. CLOSE ALL HOLES AND PENETRATIONS WITH NON-SHRINK GROUT. RESTORE SURFACE TO THE CONDITION OF LIKE NEARBY SURFACE TREATMENT, INCLUDING PAINT RESTORATION.
6. SEE SHEET E1 FOR WORK REMOVING BUBBLER TUBE INTO WET WELL.
7. PROVIDE WEATHERPROOF SIGNS ON GRIDER DISCONNECTS READING: (1) GRINDER #1 DISCONNECT AND (2) GRINDER #2 DISCONNECT.
8. FUSED DISCONNECT SWITCH, 480 VAC, 30 AMP, 3P, NEMA HD. FUSE WITH BUS FRS-R-7. 3-#12 PWR, 1-#12 GRD, 2-#14 OT SW IN 3/4" C TO GRINDERS.
9. 4" SQ. X APPROX. 48" LONG NEMA 1 WIREWAY WITHOUT CONCENTRIC KNOCKOUTS.
10. ALTERNATE ROUTE IF EXISTING STUB UPS ARE WITHIN PULL BOX.

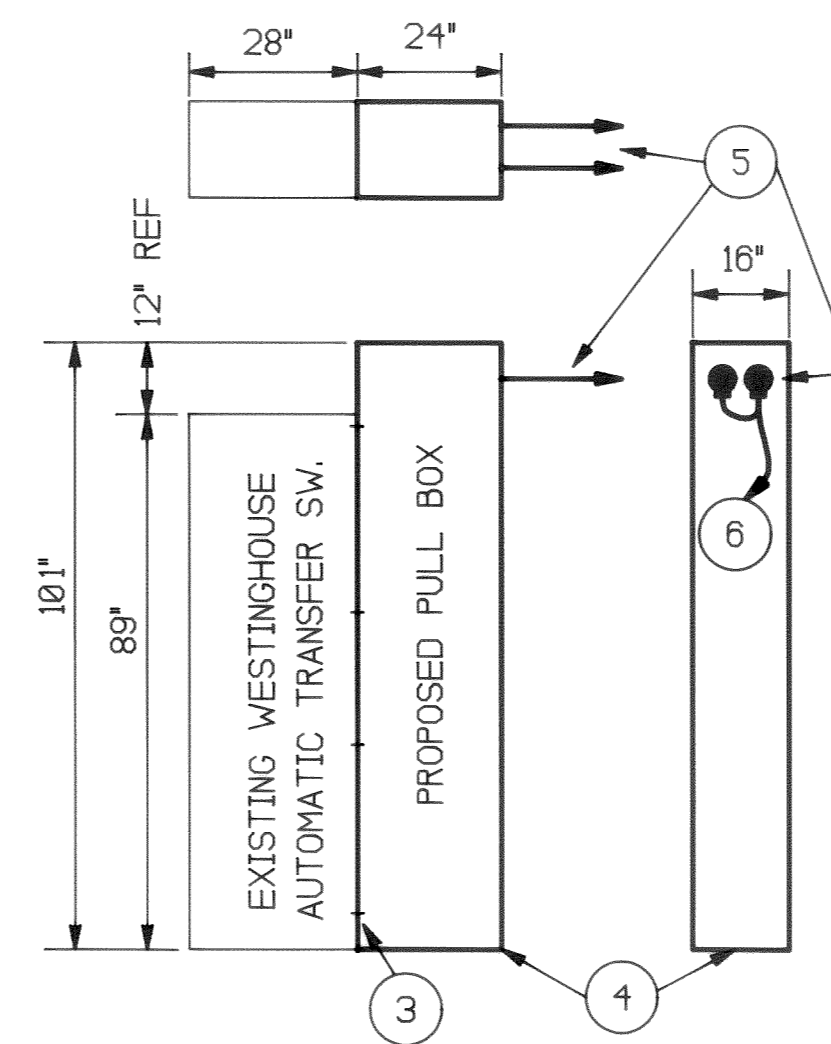

1. PULL BOX SHALL BE GALVANIZED STEEL, NOMINALLY 101" HIGH, 24" WIDE, 16" DEEP.
2. PULL BOX SHALL CONFORM TO NEC ARTICLE 378. FRONT COVER SHALL BE REMOVABLE.
3. ATTACH TO EXISTING WESTINGHOUSE AUTOMATIC TRASFER SWITCH. ATTACHMENT SHALL HAVE THE SAME EQUIVALENT CONDUCTANCE OF A #1/0 CU CABLE.
4. PULL BOX SHALL BE FREE STANDING.
5. 2, 3-1/2" O EACH WITH 3-500 MCH CU THW & 1-#1/0 CU THW THEREIN TO PROPOSED MCC.
6. MYERS SCREW TITE GROUNDING BUSHINGS. BOND WITH #1/0 CU CABLE TO ATS GROUND BUS IN ATS.
7. SUBMIT SHOP DRAWING OF PULL BOX AND MATERIAL FOR ENGINEER'S REVIEW.


PROPOSED ATS PULL BOX DETAIL 1

NOT TO SCALE

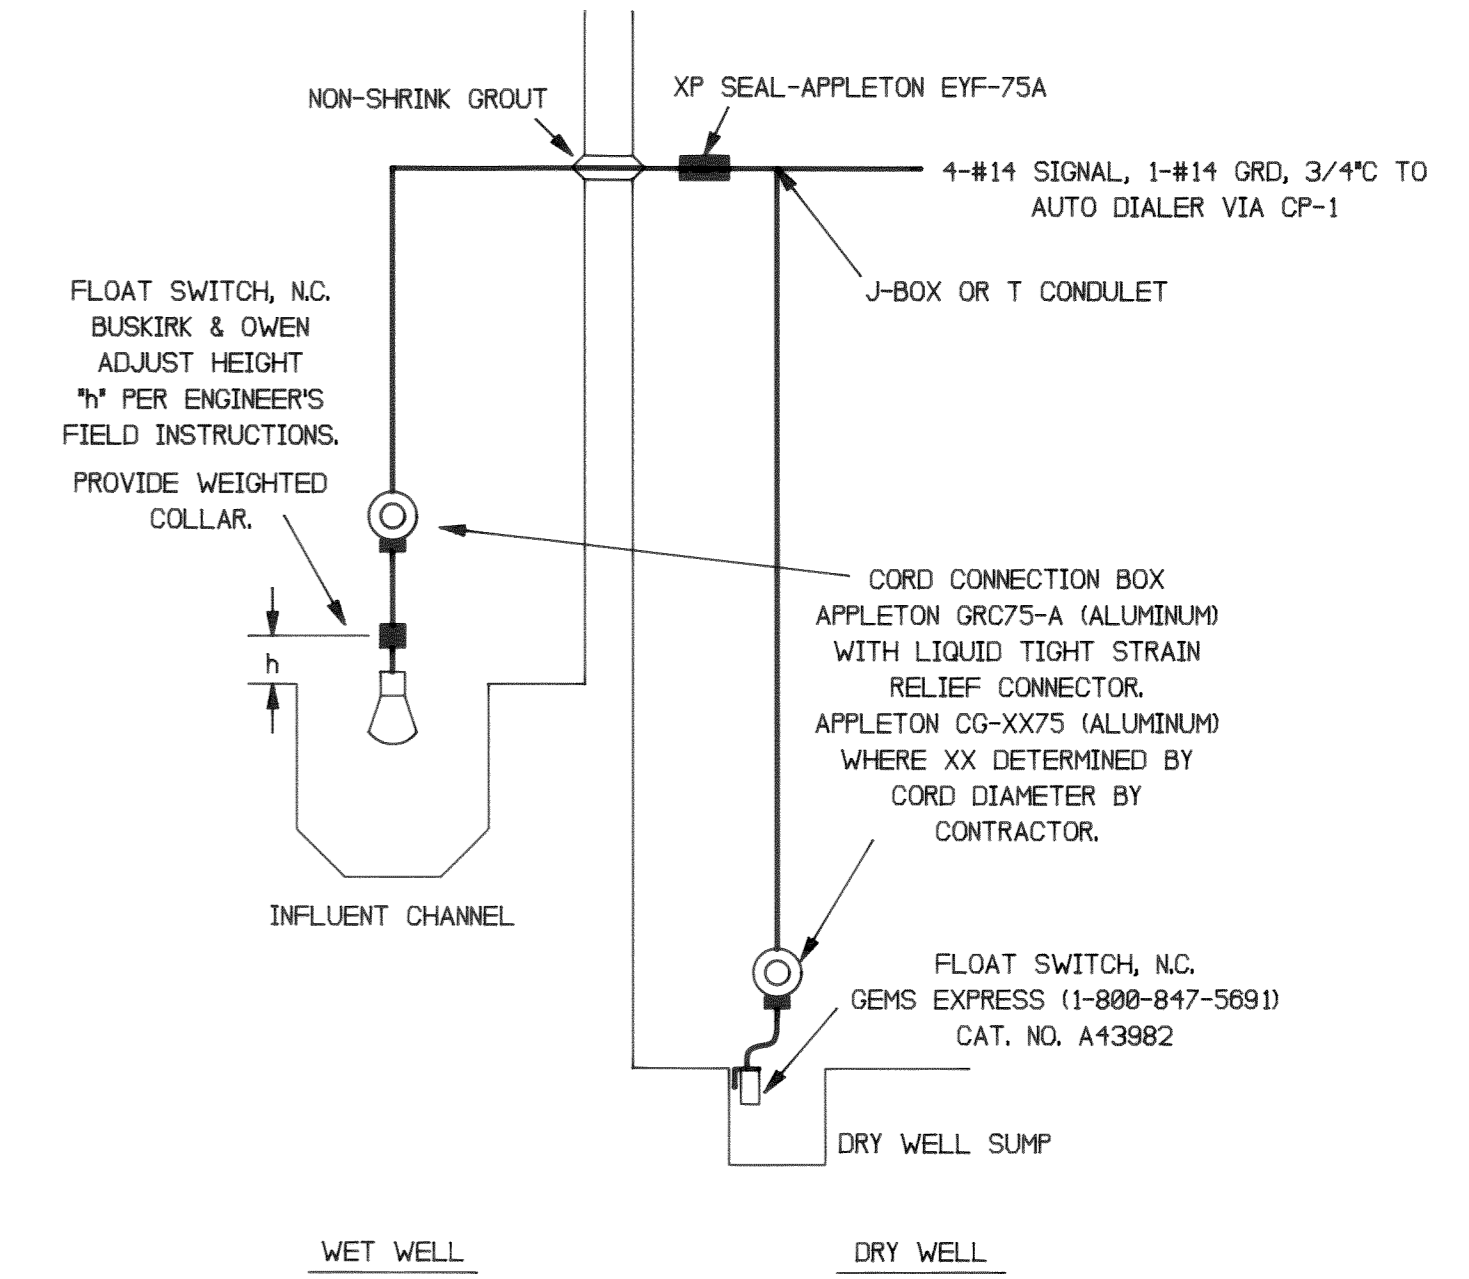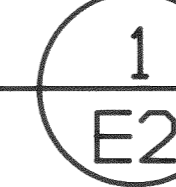



ALARM FLOAT SWITCH DETAIL 2

NOT TO SCALE

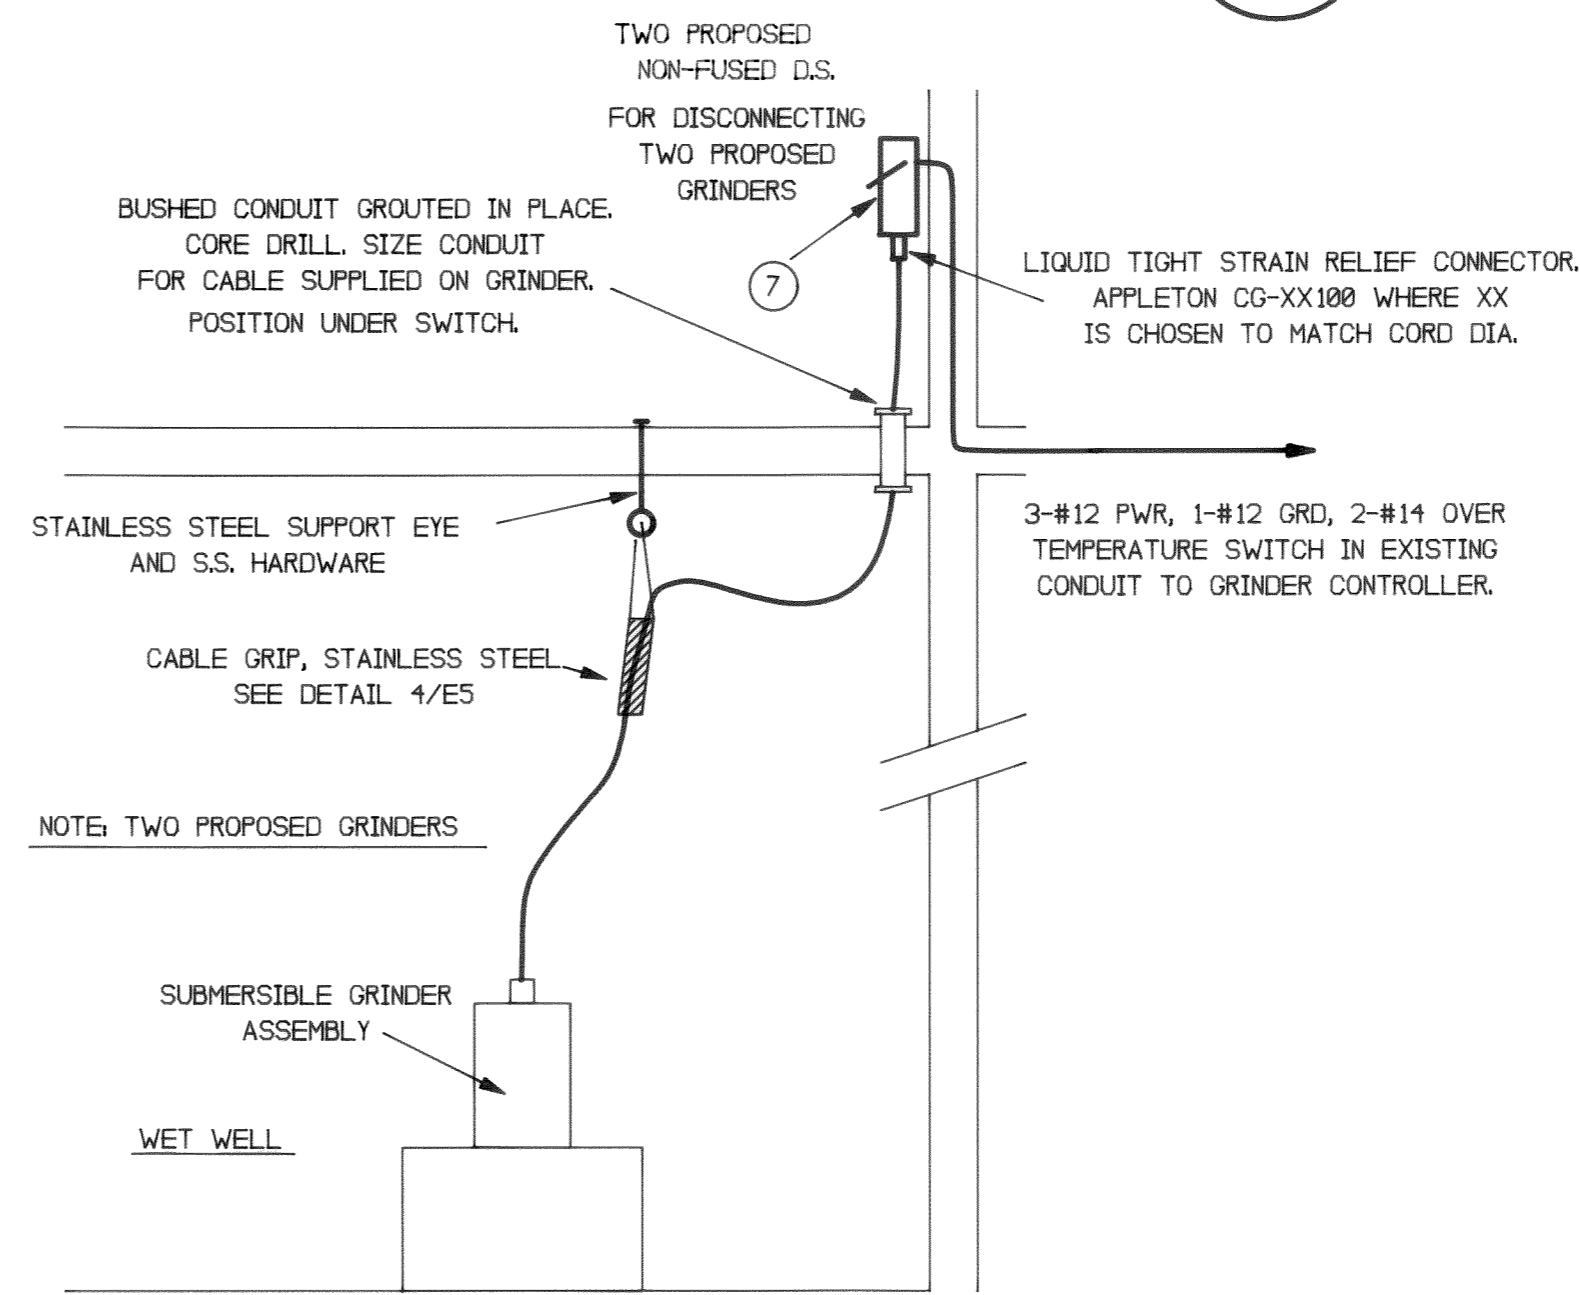

GRINDER CABLE SUPPORT DETAIL 3


NOT TO SCALE

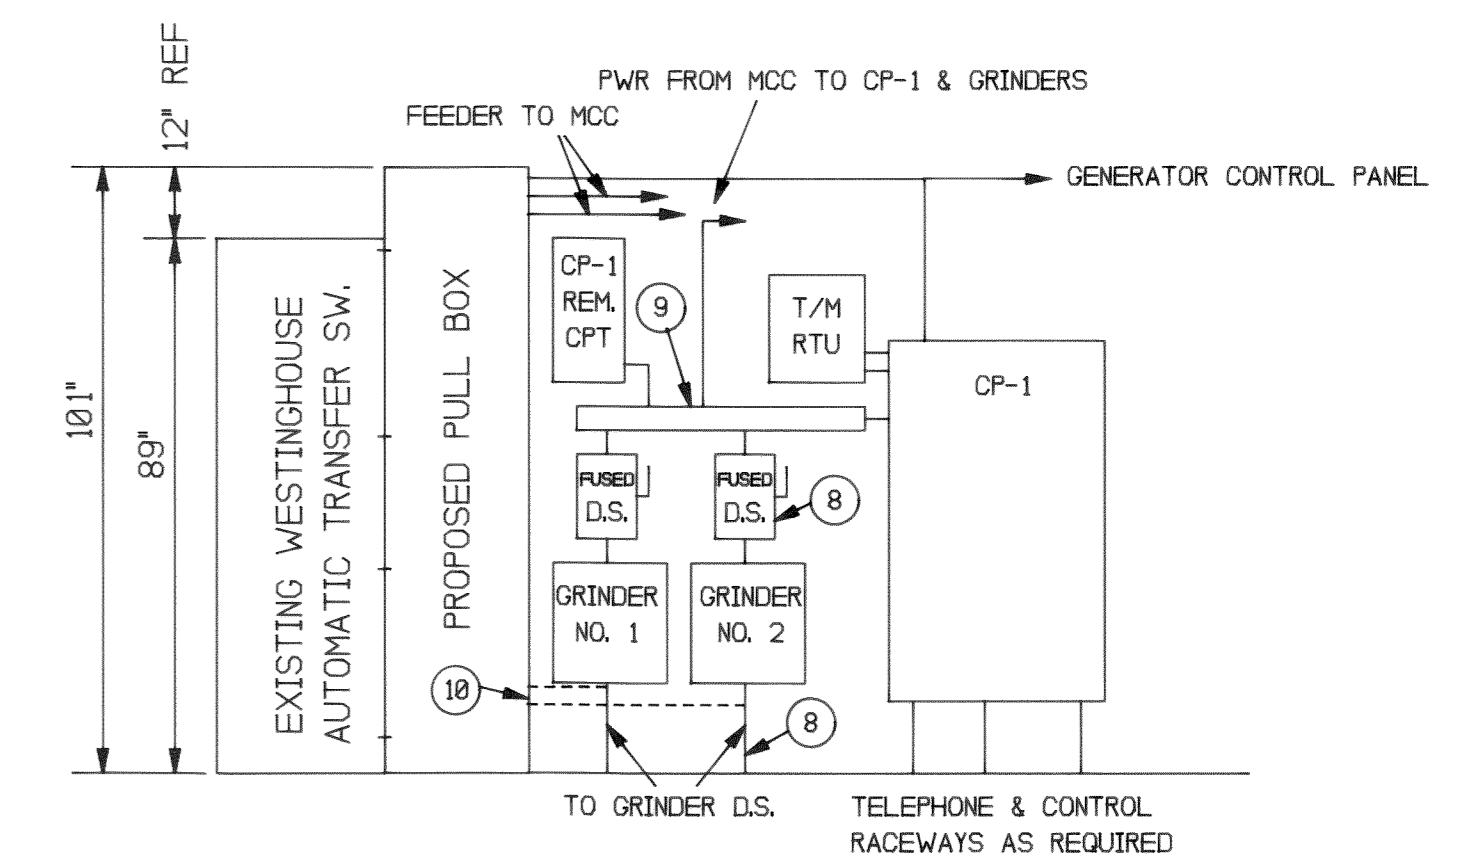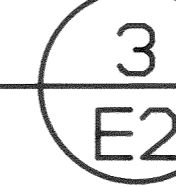

ELEVATION DETAIL - CP1, ATS, 4


SCALE: 3/8" = 1'-0"

SOME EQUIPMENT NOT TO SCALE

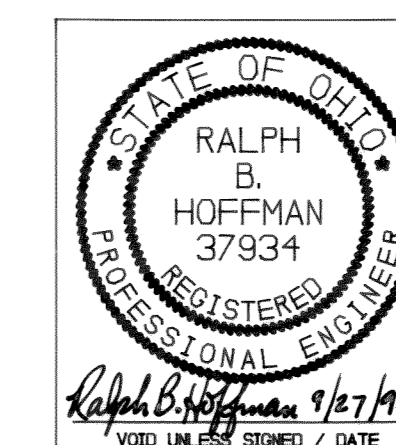


89/15/94
94098E2
E2

DELAWARE COUNTY, OHIO
ALUM CREEK PUMPING STATION
ELECTRICAL REVISIONS - 1994
HOFFMAN ENGINEERING CO.
CONSULTING ELECTRICAL & INSTRUMENTATION ENGINEERS
WESTERVILLE, OHIO
TEL: (614) 890-6272, FAX (614) 794-2030

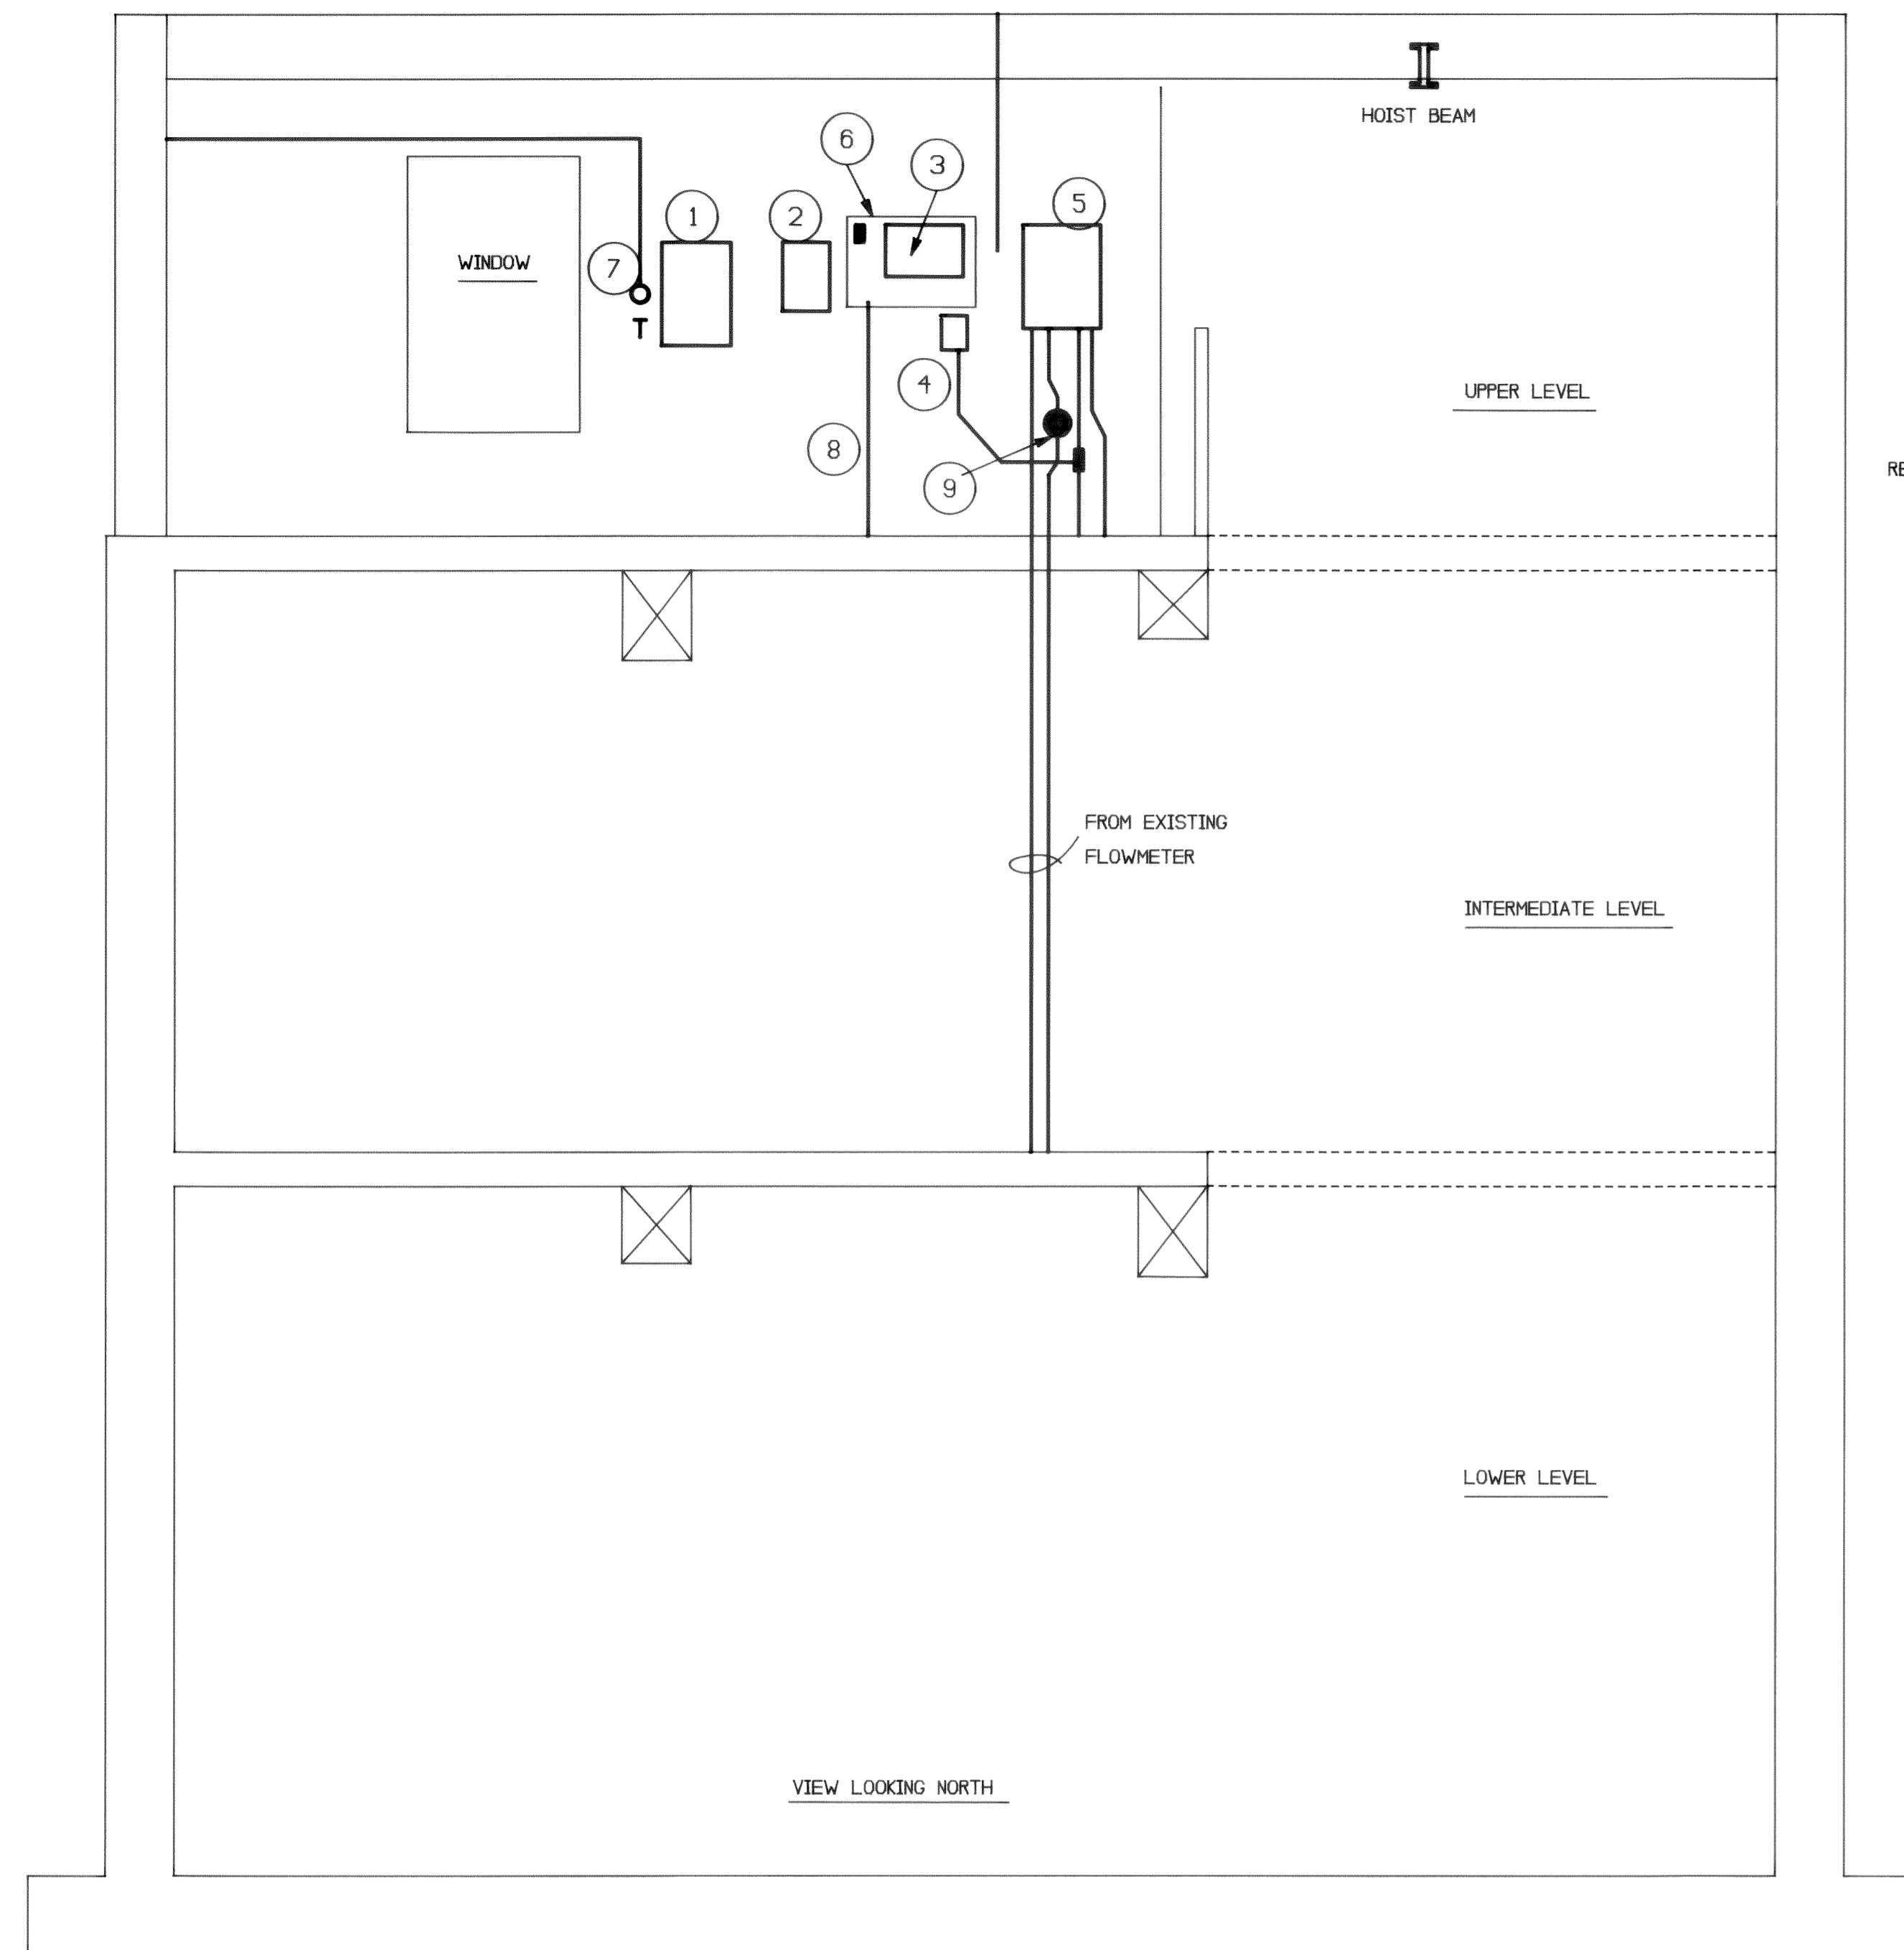

DEMOLITION AND RELOCATION (EXISTING LOCATIONS) DETAIL 1
 SCALE: 3/8" = 1' - 0"
 EQUIPMENT AND CONDUIT LOCATIONS AND SIZE NOT TO SCALE
 E3

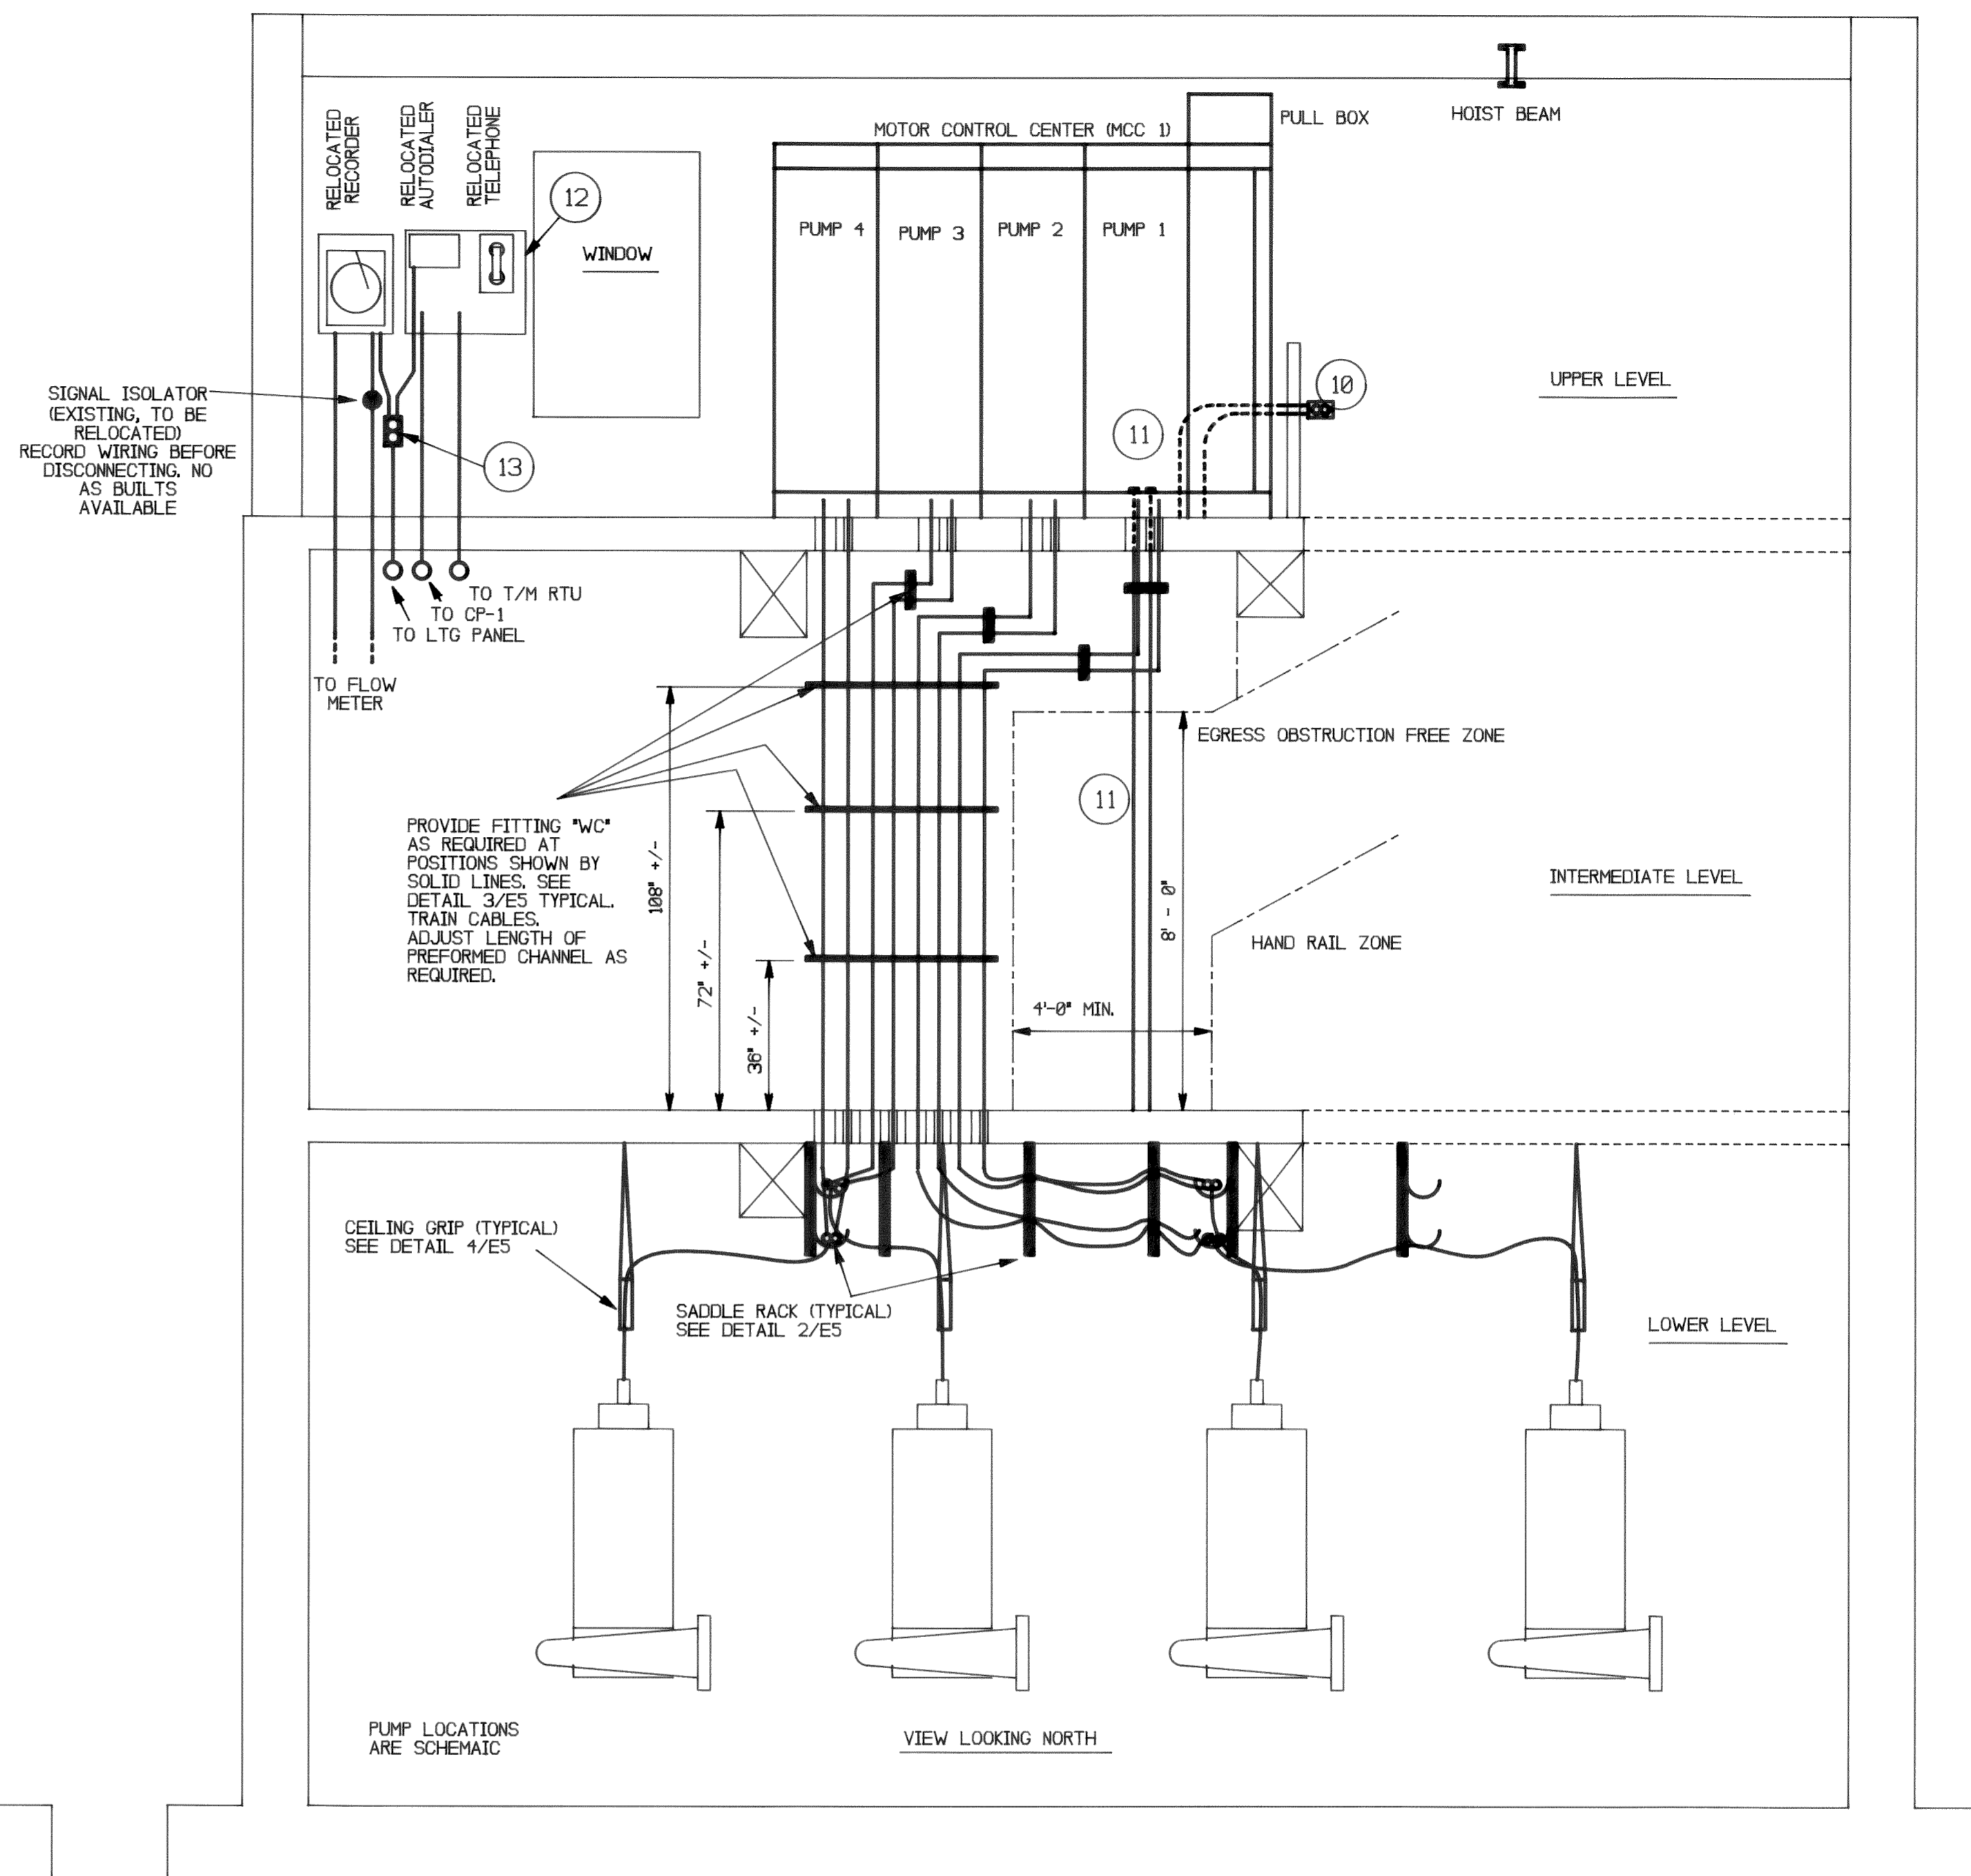


PROPOSED CONSTRUCTION & RELOCATIONS DETAIL 2
 SCALE: 3/8" = 1' - 0"
 EQUIPMENT AND CONDUIT LOCATIONS AND SIZE NOT TO SCALE
 E3

NOTES

1. DEDICATION PLAQUE TO BE RELOCATED TO DOOR AREA, SEE UPPER LEVEL ELECTRICAL PLAN.
2. TELEPHONE. RELOCATE WHERE SHOWN ON UPPER LEVEL ELECTRICAL PLAN.
3. AUTOMATIC TELEPHONE DIALER. RELOCATE TO WHERE SHOWN ON UPPER LEVEL ELECTRICAL PLAN.
4. CONVENIENCE OUTLET. RELOCATE AS SHOWN IN DETAIL 2/E3.
5. RECORDER. RELOCATE TO WHERE SHOWN ON UPPER LEVEL ELECTRICAL PLAN.
6. TELEPHONE TERMINAL BOARD. RELOCATE TO WHERE SHOWN ON UPPER LEVEL ELECTRICAL PLAN.
7. THERMOSTAT. RELOCATE TO WHERE SHOWN ON UPPER LEVEL ELECTRICAL PLAN.
8. TELEPHONE CONDUIT. REMOVE CABLE BACK TO INTERMEDIATE LEVEL TELEPHONE BOARD. CAP EMPTY CONDUIT.
9. RELOCATE FLOW METER/RECORDER SIGNAL ISOLATOR TO WHERE SHOWN ON UPPER LEVEL ELECTRICAL PLAN AND DETAIL 2/E3.
10. RELOCATED CONVENIENCE OUTLET. REMOVE OLD WIRES TO NEXT CONDUIT ACCESS POINTS AND INSTALL NEW CABLES. REMOVE OLD C-CONDULET. INSTALL ERICKSON COUPLINGS AS REQUIRED. PROVIDE APPLETON FDS TYPE BOX.
11. REMOVE CABLES AND CAP EMPTY OBSOLETE FLOWMETER CONDUITS.
12. PROVIDE NEW TELEPHONE BACK BOARD, 3/4" PLYWOOD, PAINTED WHITE ALL SIDES. MAKE AS LARGE AS SPACE PERMITS BETWEEN RECORDER AND WINDOW.
13. APPLETON FDCC BOX.

SPECIAL PERMISSION REQUESTED

1. IT IS THE INTENTION OF THE PROJECT, IN PART, TO MAKE THE STATION RESISTANT TO ACCIDENTAL FLOODING. THE PROPOSED PUMPS ARE SUBMERSIBLE. SUBMERSIBLE PUMP CABLES ARE ROUTED WITHOUT SPLICE TO THE GRADE LEVEL MCC. SPECIAL PERMISSION IS REQUESTED WITH REGARD TO CODE SECTION 480-7 SO THAT THERE IS NO QUESTION OF PROPRIETY OF INSTALLATION DURING CONSTRUCTION.
2. MAKING THE STATION FLOOD RESISTANT IS DESIRED TO MINIMIZE THE RISK OF ENVIRONMENTAL DAMAGE CAUSED BY UNTREATED SEWAGE FLOWING INTO ALUM CREEK OR BACKING UP IN BUILDINGS.

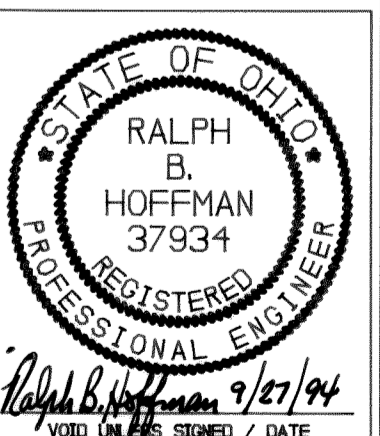


DELAWARE COUNTY, OHIO
 ALUM CREEK PUMPING STATION

ELECTRICAL REVISIONS - 1994

HOFFMAN ENGINEERING CO.
 CONSULTING ELECTRICAL & INSTRUMENTATION ENGINEERS
 WESTERVILLE, OHIO
 TEL: (614) 898-6272, FAX: (614) 794-2838


09/15/94
 94080E3
 E3



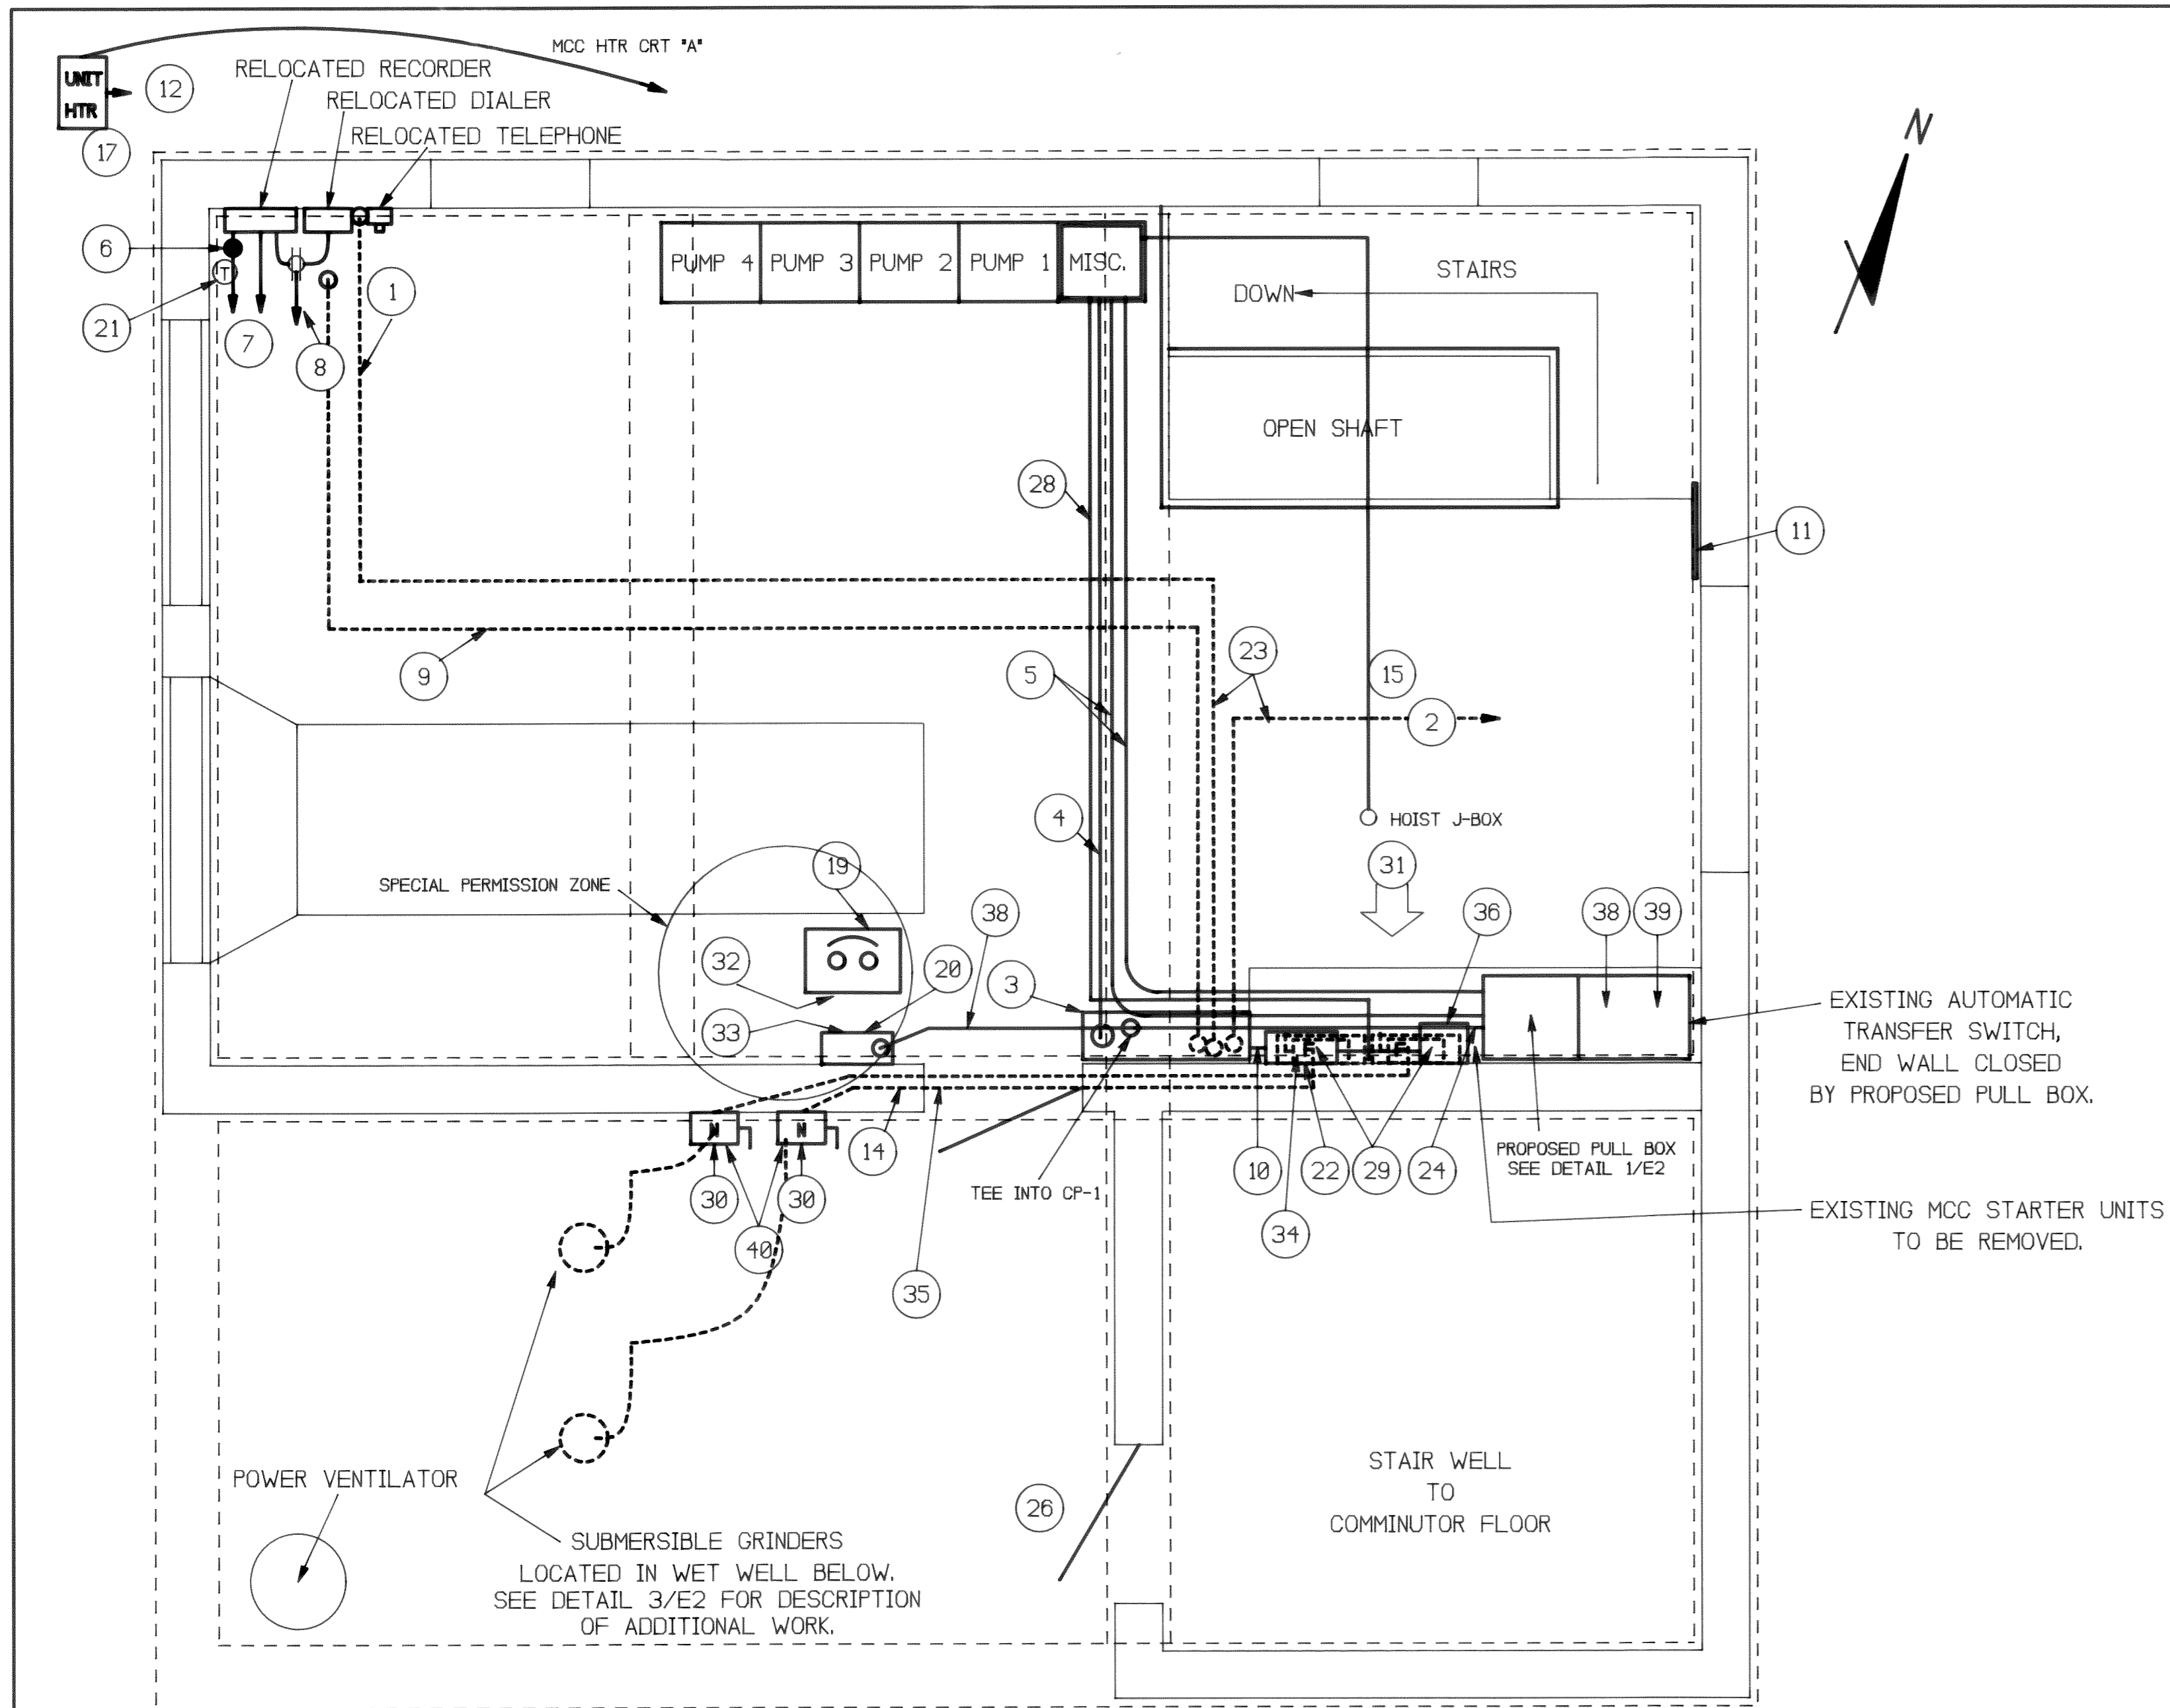

UPPER LEVEL ELECTRICAL PLAN

SCALE: 3/8" = 1' - 0"

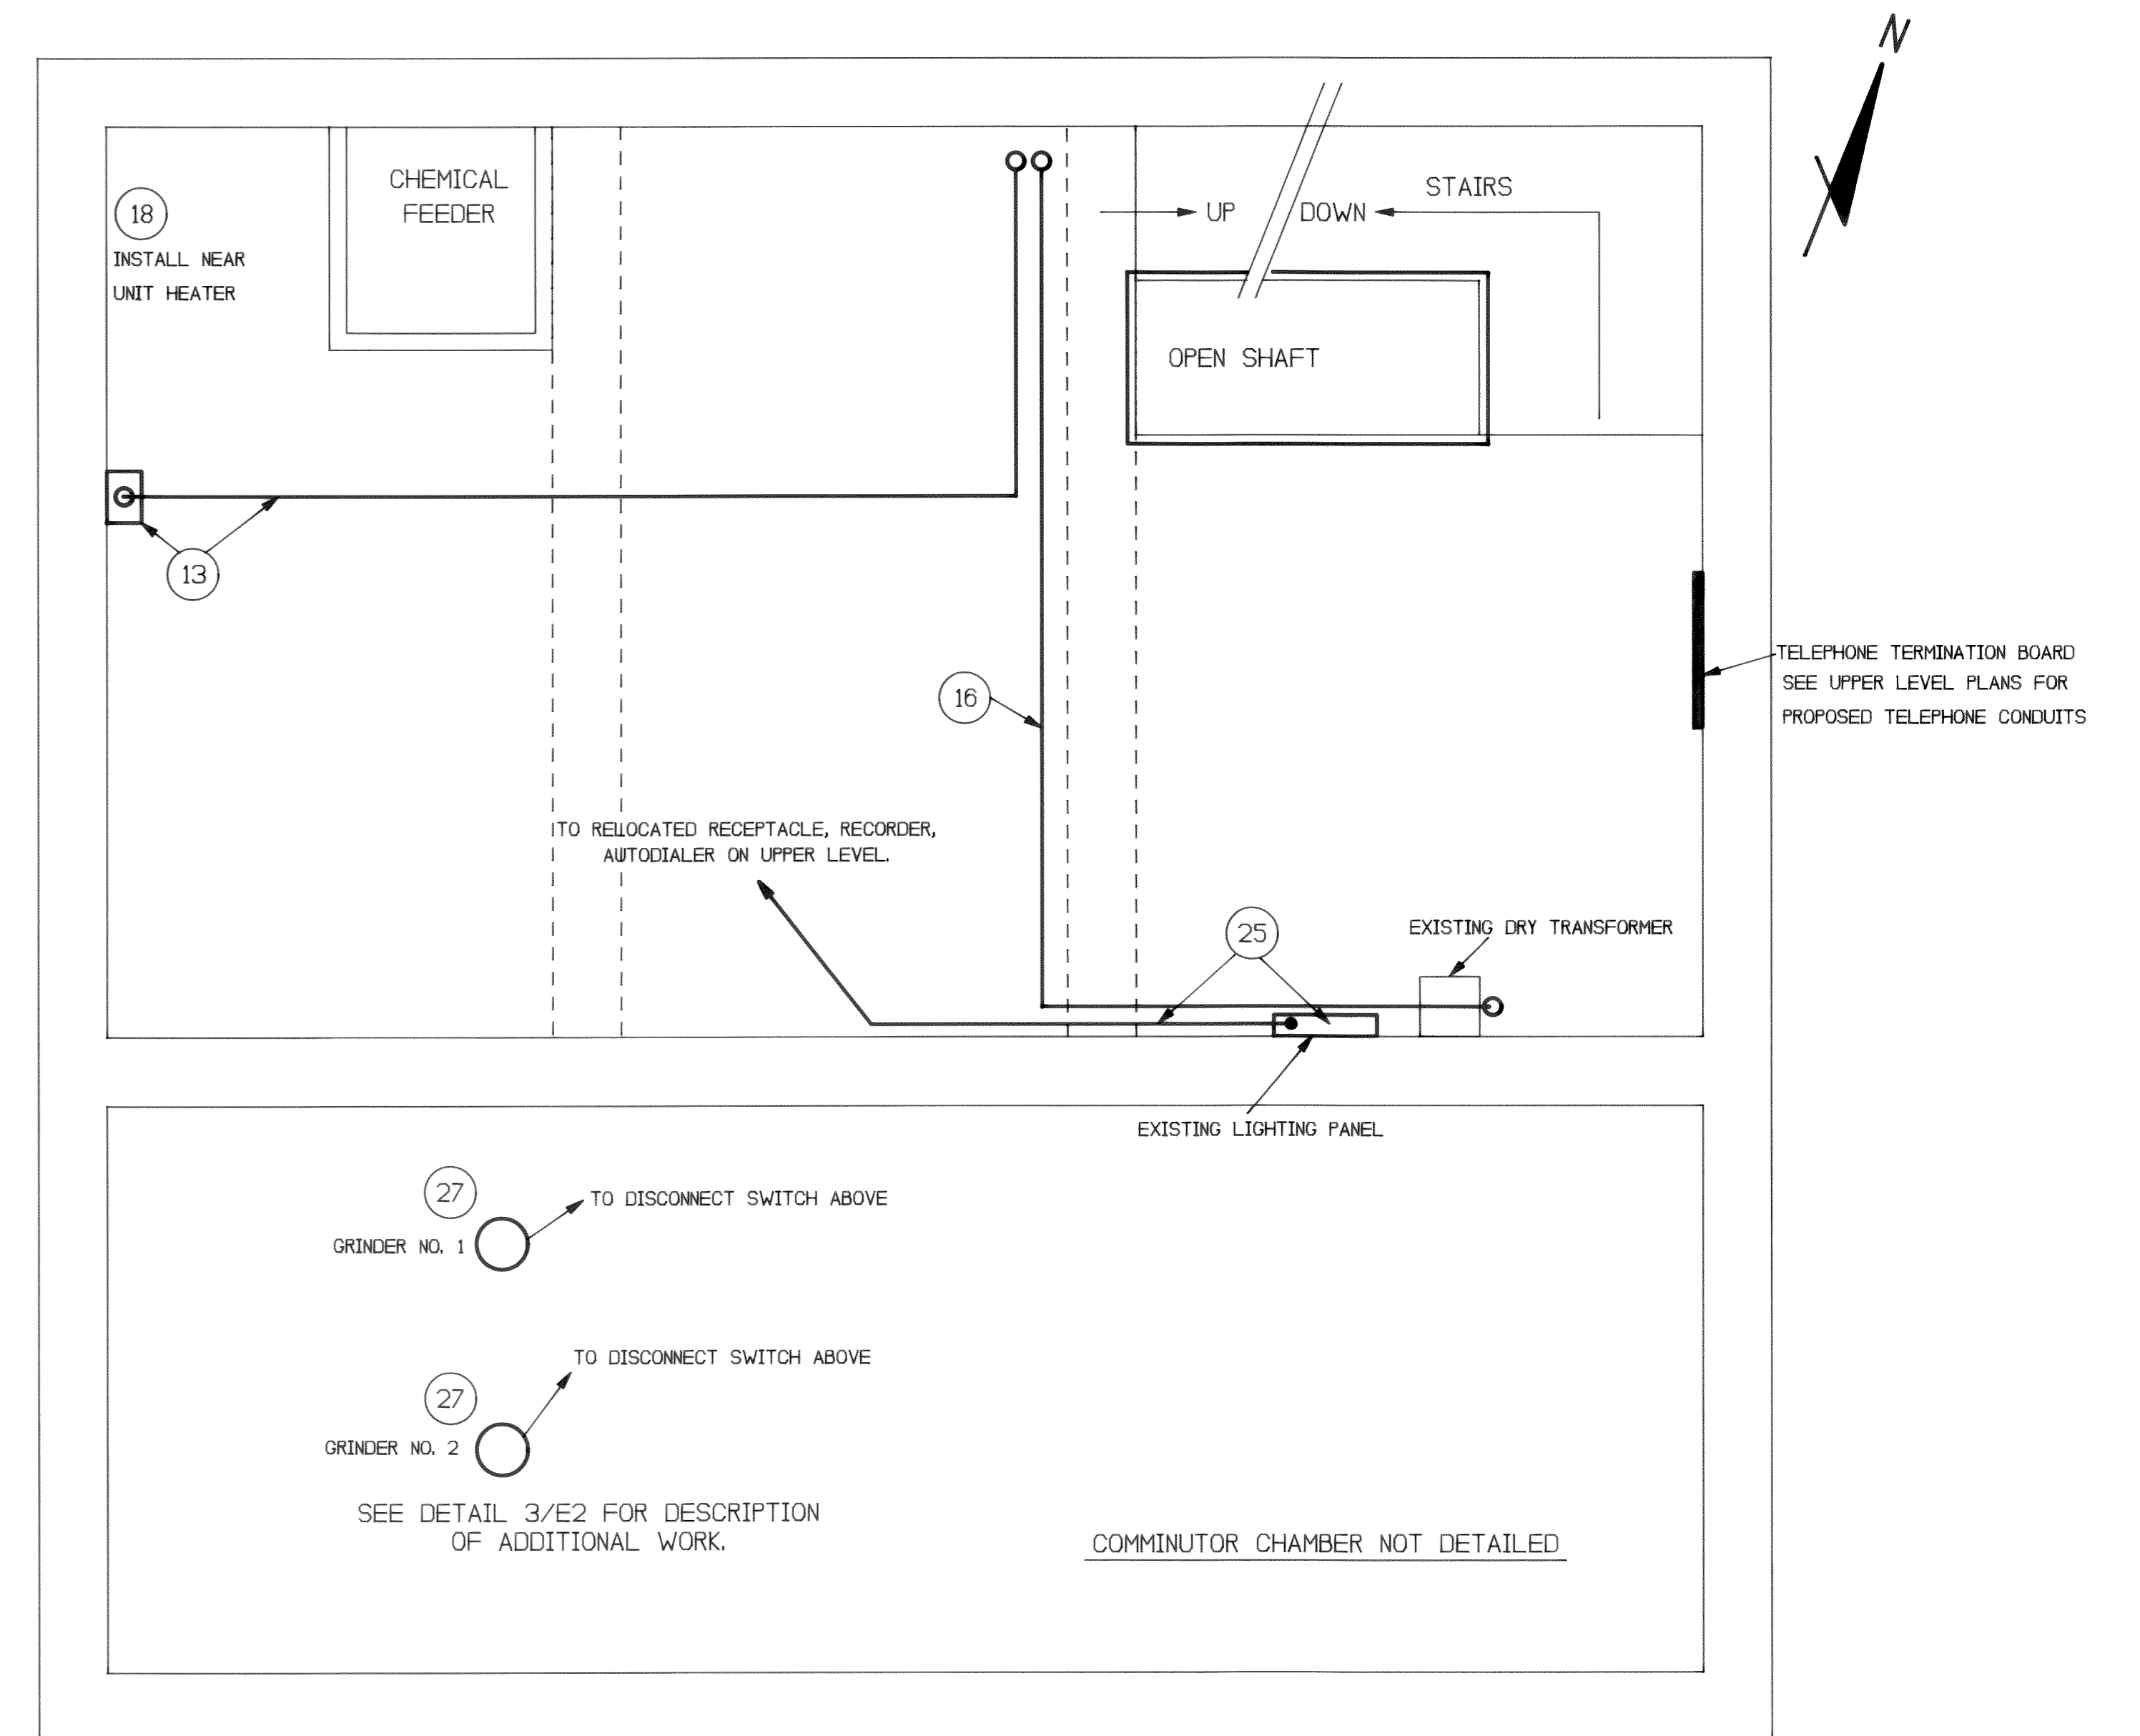

INTERMEDIATE LEVEL ELECTRICAL PLAN

SCALE: 3/8" = 1' - 0"


NOTES

- 1" TELEPHONE C TO T/M RTU EQUIPMENT VIA CP-1.
- 1" TELEPHONE C FROM T/M RTU VIA CP-1 TO TELEPHONE TERMINAL BOARD
- EXISTING PUMP #4 CONTROLLER AND LEVEL CONTROLLER. CONVERT TO LEVEL CONTROL ONLY. CONTROLLER TO BE CALLED CONTROL PANEL CP-1.
- POWER AND CONTROL CONDUIT. 2" C WITH WIRES PER CONTROL DRAWINGS. SEE CP-1 IN PARTICULAR. RUN MCC TO T/M RTU WIRES BY WAY OF CP-1 USED AS PULL BOX.
- 2, 3-1/2" EACH WITH 3-500 MCM CU THW THEREIN. BOND CONDUITS TO ENCLOSURES FOR ENHANCED EQUIPMENT GROUNDING WITH MYERS SCRU TITE HUBS WITH BONDING JUMPERS AND LUGS.
- RELOCATE ISOLATOR FROM PRESENT POSITION. CAREFULLY NOTE WIRING CONNECTIONS TO RECORDER AND MAGNETIC FLOW METER BEFORE DISCONNECTING. PULL NEW WIRES TO MAG METER AND RECORDER.
- 2, 1" C FROM RECORDER TO MAGNETIC FLOW METER IN PUMP ROOM. DUPLICATE PRESENT NUMBER OF WIRES. WIRE SIZE MAY BE CHANGED TO #12 THWN. APPLY E-Z CODE WIRE LABELS TO BOTH ENDS. SUBMIT WIRE LIST AND INTERCONNECTION DIAGRAM TO ENGINEER AS "AS BUILT" DATA.
- 2-#12 PWR AND 1-#12 GRD IN 3/4" C TO LTG PANEL ON INTERMEDIATE FLOOR. PROVIDE 1P-20A BREAKER. TYPE RECORDER, DIALER, RECEPTACLE ON DIRECTORY CARD.
- 1" C FROM DIALER BACKBOARD TO CP-1. FOR INSTRUMENTATION CABLES PER INSTRUMENTATION DRAWINGS. INCLUDE ONE BELDEN 8719 FOR FLOW METER RECORDER TO T/M RTU ANALOG INPUT VIA CP-1.
- 1" C FROM CP-1 TO TELEMETRY PANEL. WIRES PER INSTRUMENTATION DRAWINGS.
- RELOCATED DEDICATION PLAQUE. PROVIDE ANCHORS. PATCH ANCHOR HOLES AT OLD LOCATION.
- 3-#10 PWR, #10 GRD IN 3/4" C TO MCC HTR CRT "A". REMOVE WIRE FROM OBSOLETE CONDUIT. CAP.
- 3-#12 PWR, #12 GRD IN 3/4" C TO MCC HTR CRT "B". CONNECT TO EXISTING HTR FEEDERS AT EXISTING PULL BOX. REMOVE OBSOLETE WIRE BACK TO OLD MCC. CAP.
- 3-#12 PWR, 1-#12 GRD & 2-#14 OT WIRES IN EXISTING C TO EXISTING MCC STUB UP. CONNECT STUB UP TO PROPOSED GRINDER REVERSING CONTROLLER WALL MOUNTED WITH MATCHING SIZE CONDUIT.
- 3-#12 PWR, 1-#12 GRD IN 3/4" C TO MCC "HOIST".
- 2-#8 PWR, 1-#8 GROUNDING ELECTRODE CONDUCTOR IN 1" C TO MCC "LIGHTING TRANSFORMER". CARRY #8 GROUND TO SECONDARY MID POINT AND ALSO GROUND TO LTG PANEL.
- LABEL "ELECTRIC HEATER CRT "A".
- LABEL "ELECTRIC HEATER CRT "B".
- GENERATOR MAIN LINE CIRCUIT BREAKER. REMOVE EXISTING GE TJK636F000 BREAKER FROM GENERATOR CONTROL PANEL (NOT PRESENTLY CONNECTED). TEST AND CONFIRM THAT BREAKER IS IN GOOD OPERATING CONDITION. FURNISH GE ENCLOSURE, BELIEVED TO BE MODEL TJB00S W/GRD KIT TGL6. INSTALL CB IN ENCLOSURE AND THEN INSTALL BESIDE GENERATOR CONNECTION COMPARTMENT. PROVIDE LTFMC FROM CB ENCLOSURE TO FLOOR STUB UP. SEEK TO OBTAIN SPECIAL PERMISSION FOR NON-COMFORMANCE RE ARTICLE 110-16 WITH BUILDING OFFICIAL. ADJUST INSTALLATION IN ACCORDANCE WITH INSTRUCTION FROM BUILDING INSPECTOR. PROVIDE LTFMC VIBRATION ISOLATION CONNECTION BETWEEN GENERATOR AND CB ENCLOSURE IF CB IS NOT RIGIDLY ATTACHED TO GENERATOR CONNECTION BOX. CB TEST TO INCLUDE TRIPPING TIMES AT 2X RATED AND 1960 V 1 MIN. DIELECTRIC WITHSTAND.
- EXISTING GENERATOR CONTROL PANEL.
- RELOCATED THERMOSTAT
- MOUNT EXISTING (BUT LOOSE) TELEMETRY (T/M) REMOTE TELEMETRY UNIT (RTU) "B" TO LEFT OF CP-1. CONNECT ALARM INPUTS TO CP-1 TERMINALS AND OTHER ALARM SENSORS. SEE CP-1 DRAWINGS.
- PROVIDE BELDEN 9566, 6 PAIR, #24 GAGE TELEPHONE CABLE IN CONDUITS DESCRIBED IN NOTES 1 & 2. RECONNECT TELEPHONE, AUTODIALER AND T/M-RTU EQUIPMENT.

- 2-#12 FROM ATS TO GENERATOR CONTROL PANEL. 6-#14 FROM ATS TO CP-1. 3/4" C, TEE-ED OVER CP-1. 2 #14 ARE SPARE.
- 2-#12 PWR, 1-#12 GRD IN 3/4" C TO NEW RECEPTACLE, AND EXISTING RELOCATED RECORDER AND AUTODIALER ON UPPER LEVEL. PROVIDE PROPOSED 1P-20 A CB IN PANEL.
- PROVIDE "CONFINED" SPACE SIGNS REQUIRED BY SPEC 10000 LOOSE TO OWNER.
- PROVIDE SIGN READING "GRINDER NO. X".
- 5-#12 PWR, 1-#12 GRD IN 1" C FOR 480 VAC TO CP-1 & GRINDER D.S. DO NOT RUN W/ SIG. WIRES IN 2" C.
- 30 A FUSED, 480 VAC, 3P DISCONNECT SWITCH, NEMA 1 ENCLOSURE, NEMA HD, FUSE BUS FR5-R-7. PROVIDE LABEL READING "GRINDER CONTROLLER NO. X DISCONNECT SWITCH".
- PROVIDE LABEL READING "GRINDER #X DISCONNECT SWITCH. LOCK OUT BEFORE WORKING ON GRINDER".
- SEE ELEVATION DIAGRAM FOR EQUIPMENT THIS AREA. DETAIL 1/E2.
- INSTALL SIGN ON CIRCUIT BREAKER ENCLOSURE READING WARNING "REDUCED WORKING SPACE ABOUT THIS EQUIPMENT. DO NOT WORK ON WHILE ENERGIZED".
- INSTALL SIGN ON GENERATOR CONTROL PANEL READING "REDUCED WORKING SPACE ABOUT THIS EQUIPMENT. DO NOT WORK ON WHILE ENERGIZED".
- REMOTELY MOUNTED CONTROL POWER TRANSFORMER ASSOCIATED WITH CONTROL PANEL CP-1. 4-#12 PWR, 1-#12 GRD, IN 3/4" LTFMC. MOUNT BELOW T/M RTU.
- HISTORICAL DRAWINGS ASSERT THAT AN EMPTY HOME RUN CONDUIT EXISTS FOR FUTURE USE IF FEASIBLE. OTHERWISE, PROVIDE NEW 3/4" CONDUIT.
- REMOTELY MOUNTED OPT FOR CP-1.
- GRINDER NO. 1 AND NO. 2 CONTROLLERS.
- TAG EXISTING WIRES AND THEIR SOURCE AND LOAD. NUMBER UNKNOWN. RECONNECT.
- PREPARE CONNECTION DIAGRAM FOR ATS CONTROL WIRES BEFORE DISTURBING EXISTING WIRING. RECONNECT ATS CONTROL WIRES BASED UPON EXISTING CONNECTIONS AND MODIFICATIONS SHOWN IN CONTROL DRAWINGS.
- 30 A NON-FUSED, 480 VAC, 3P DISCONNECT SWITCH, NEMA 4X-SS ENCLOSURE, NEMA HD.

SPECIAL PERMISSION REQUESTED

- PRESENT INSTALLATION IS IN VIOLATION OF NEC 445-4(A) (LACK OF OVERCURRENT PROTECTION), AND NEC 110-16 (LACK OF WORK SPACE IN FRONT OF GENERATOR CONTROL PANEL CAUSED BY RACEWAYS RISING FROM FLOOR TO GENERATOR CONNECTION BOX.)
- PART OF PROJECT IS TO INSTALL CIRCUIT BREAKER AT GENERATOR TO REMOVE ARTICLE 445-4(A) VIOLATION. WITH INSTALLATION OF NEW CB, WORKING SPACE WILL REMAIN AS LARGE AS AT PRESENT, BUT STILL SUB-STANDARD. WARNING SIGNS WILL BE INSTALLED (NOTES 32 AND 33) PROHIBITING WORKING ON EQUIPMENT WHILE ENERGIZED.
- SPECIAL PERMISSION IS REQUESTED TO DETERMINE ACCEPTABILITY BEFORE CONSTRUCTION COMMENCES.

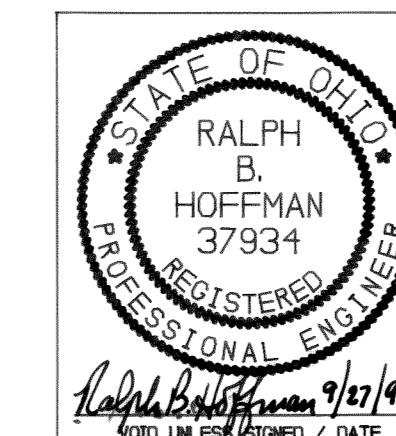


09/15/94
9409BE4


E4

DELAWARE COUNTY, OHIO
ALUM CREEK PUMPING STATION


ELECTRICAL REVISIONS - 1994

HOFFMAN ENGINEERING CO.
CONSULTING ELECTRICAL & INSTRUMENTATION ENGINEERS
WESTERVILLE, OHIO
TEL: (614) 898-6272, FAX (614) 794-2030

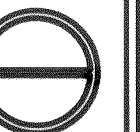


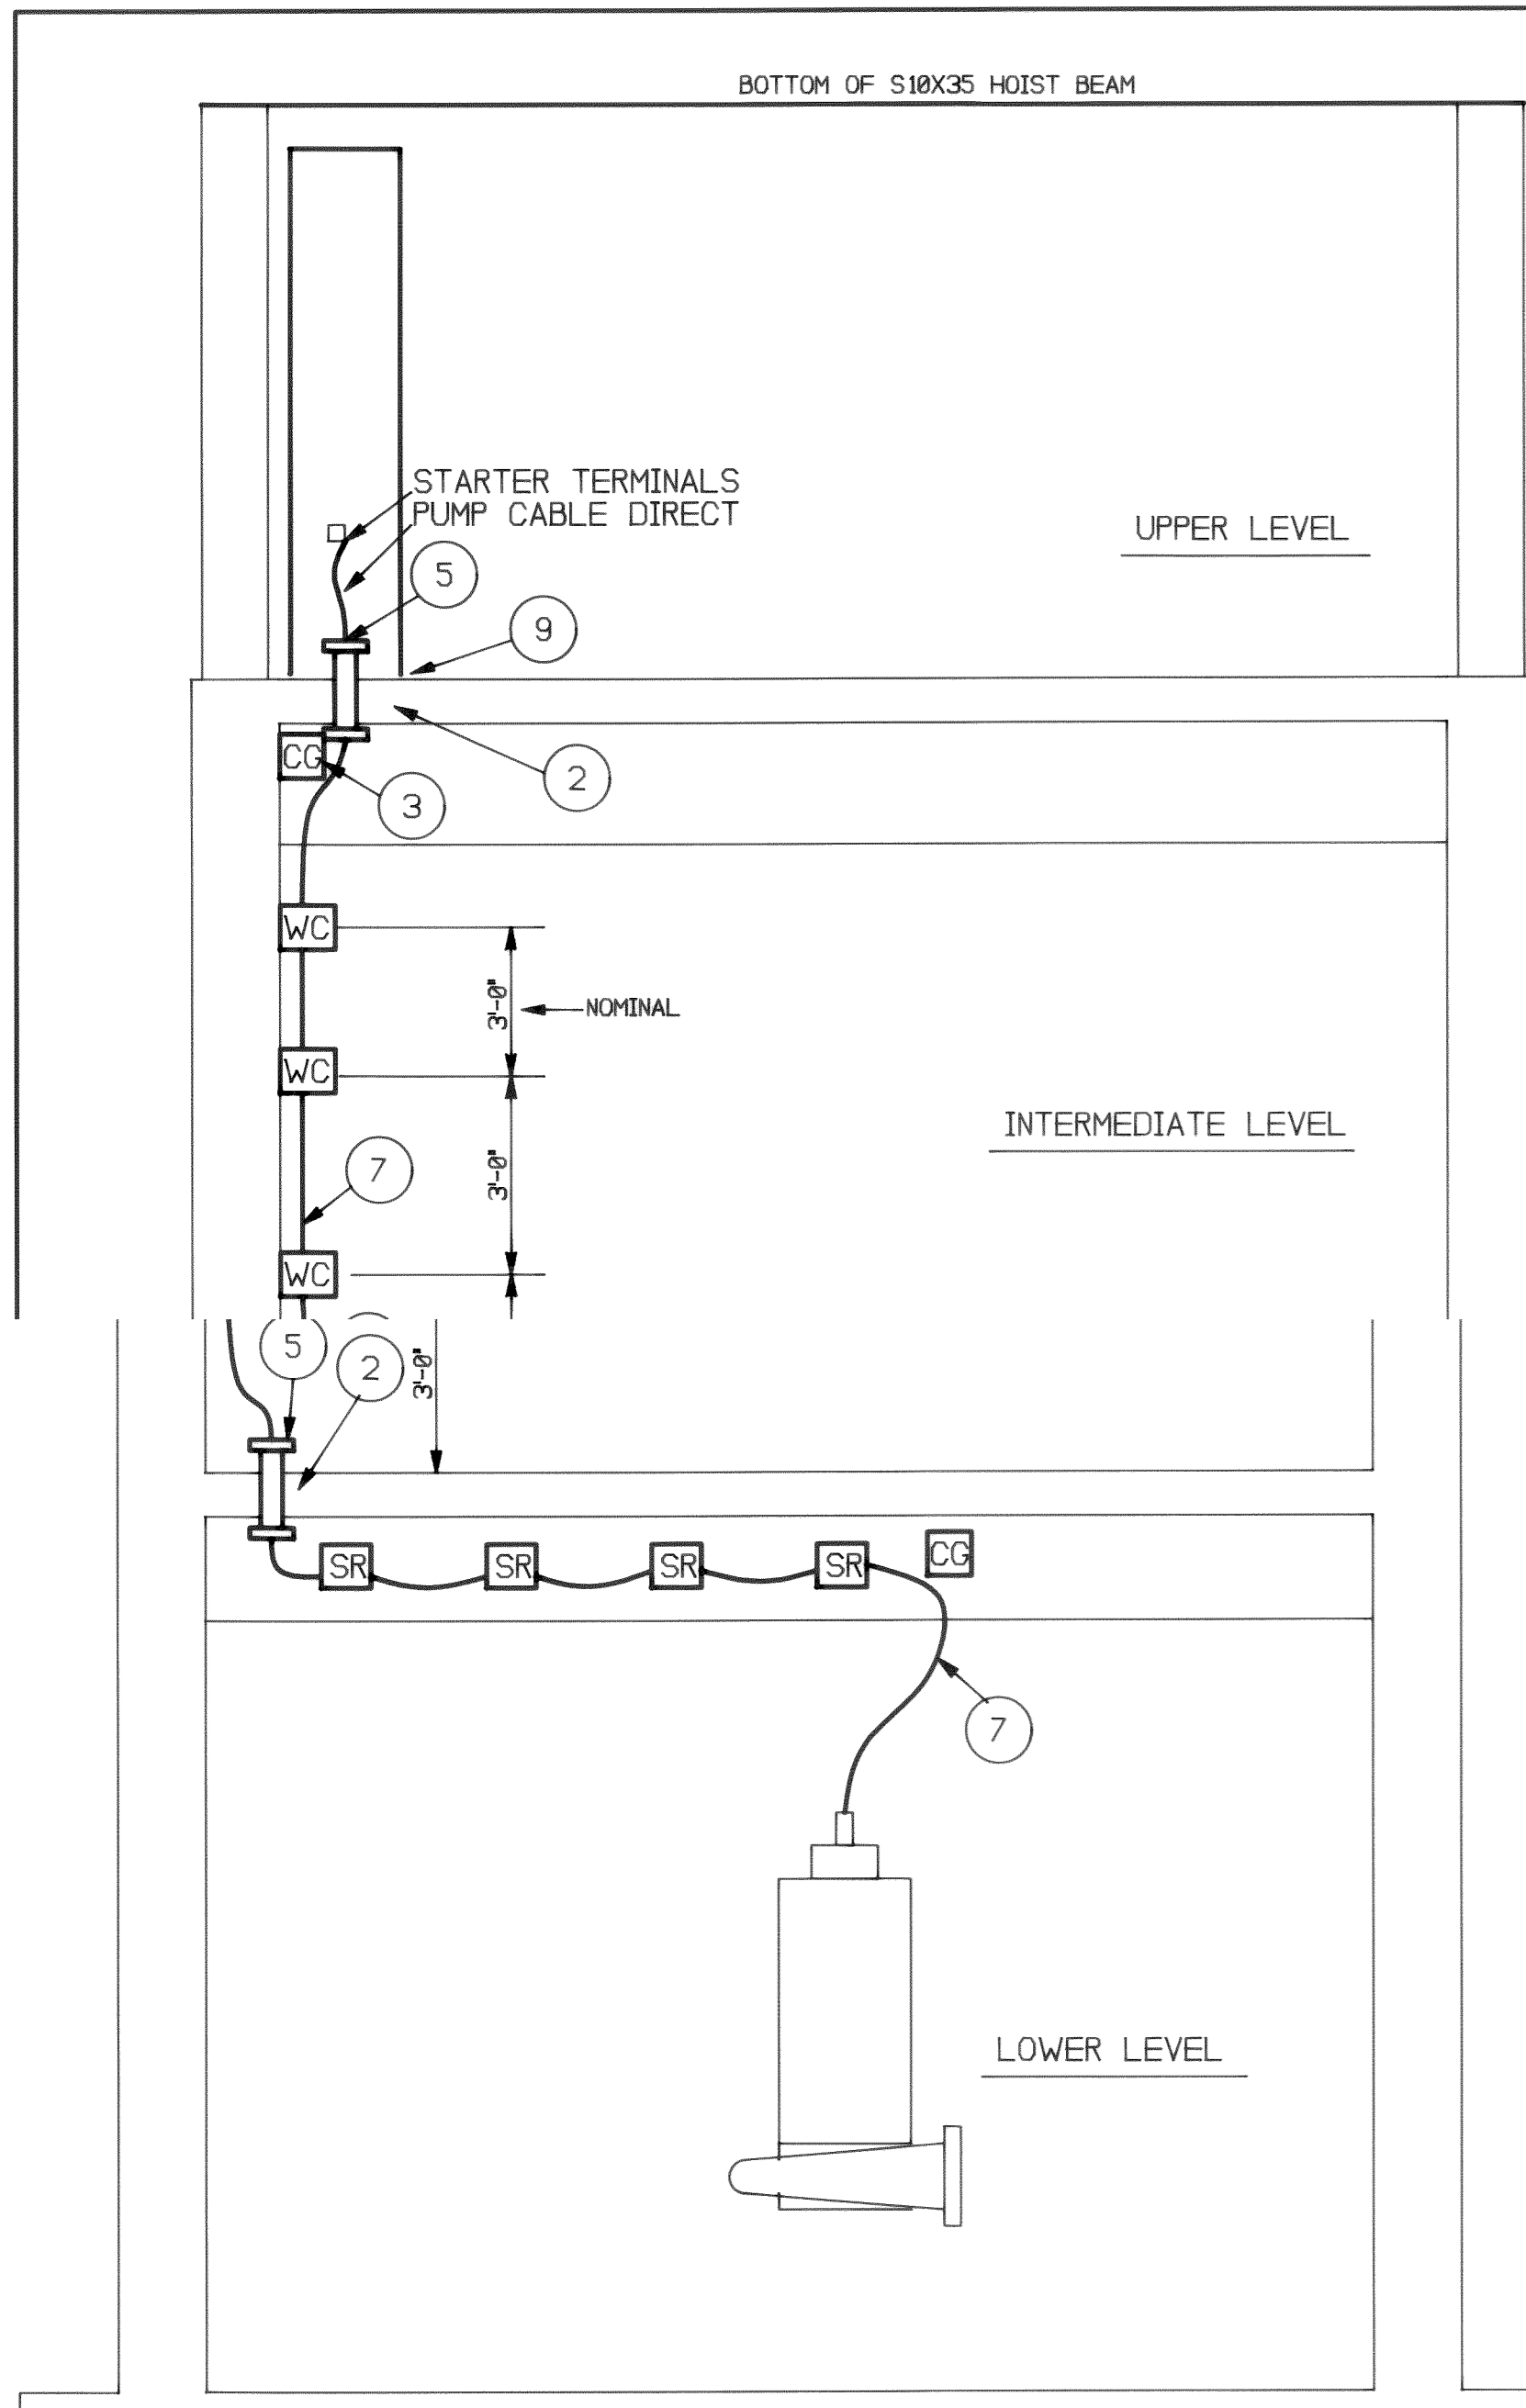


PUMP CABLE SUPPORT DETAIL 1
NOT TO SCALE E5

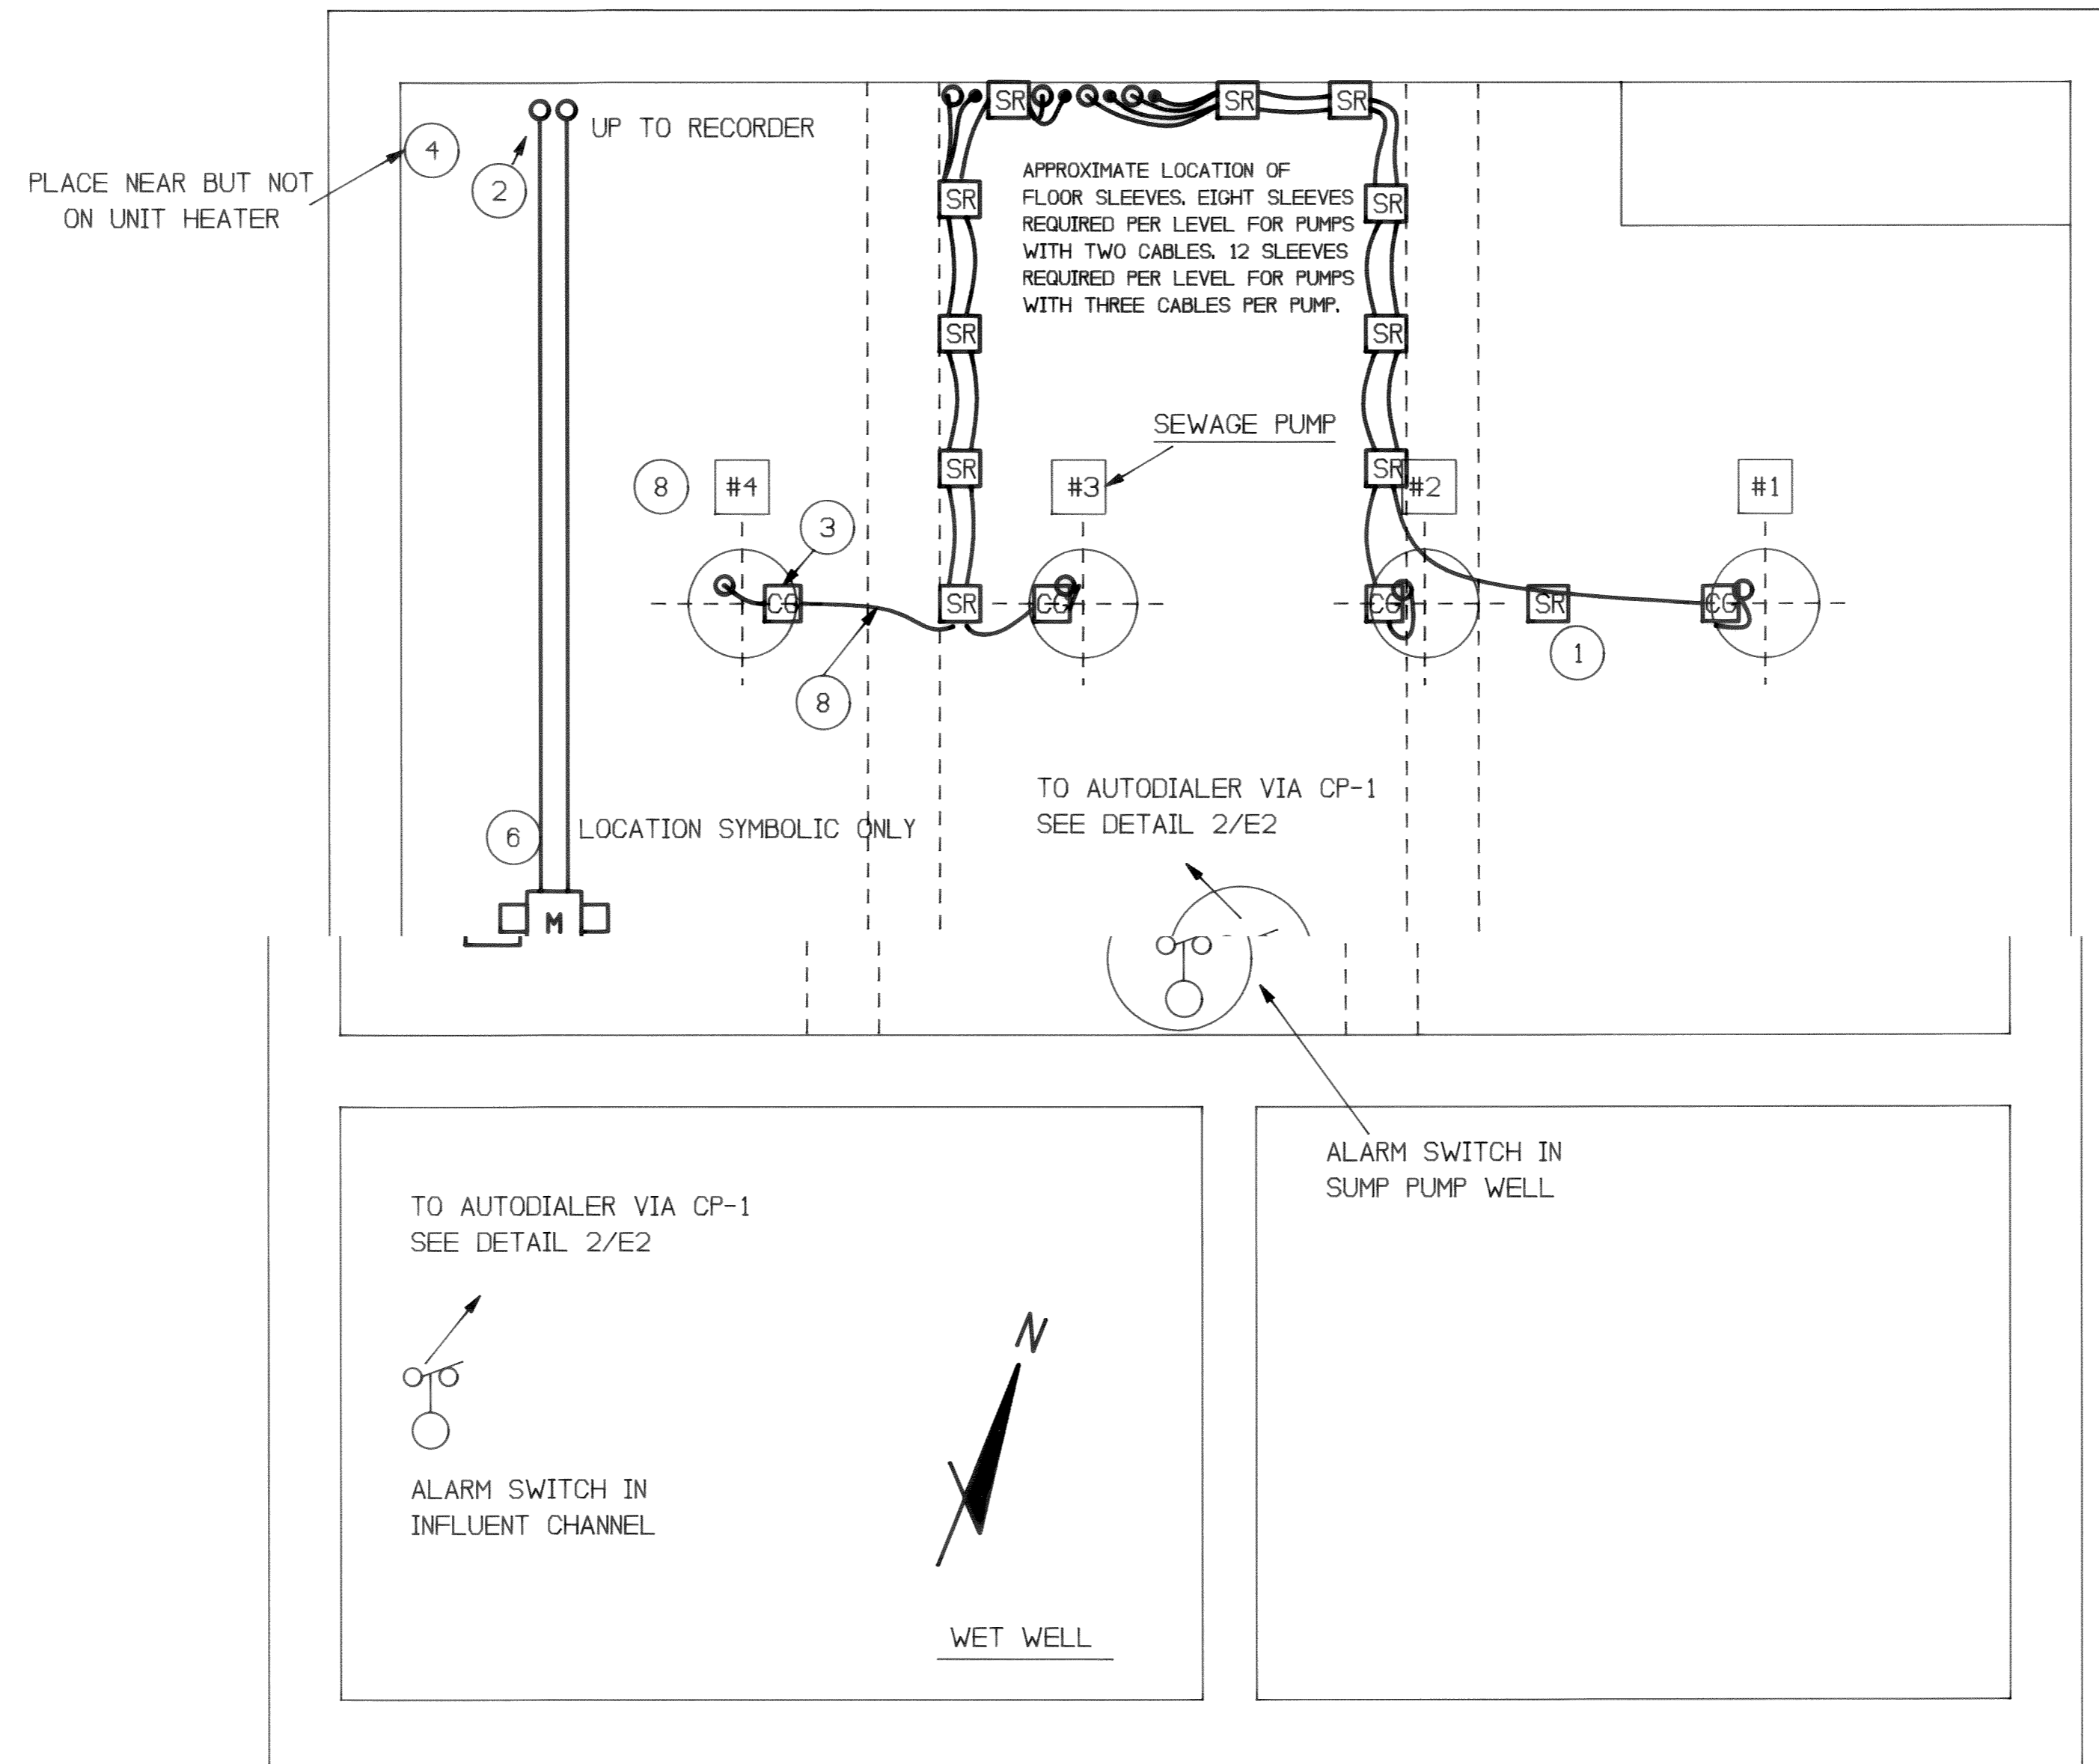


LOWER LEVEL ELECTRICAL PLAN
SCALE: 3/8" = 1' - 0"

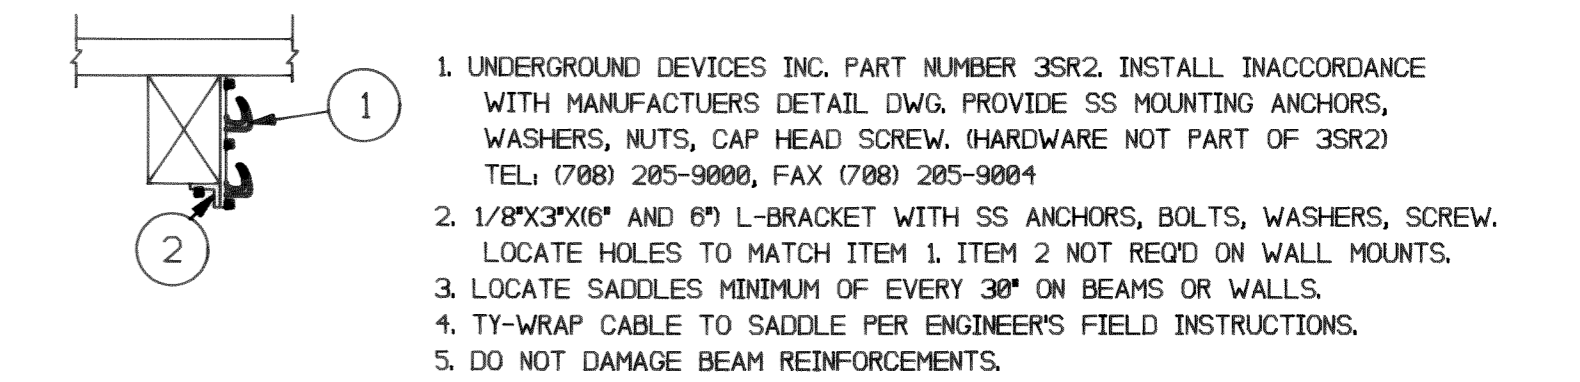

SYMBOL [SR] SADDLE RACK DETAIL 2
NOT TO SCALE E5

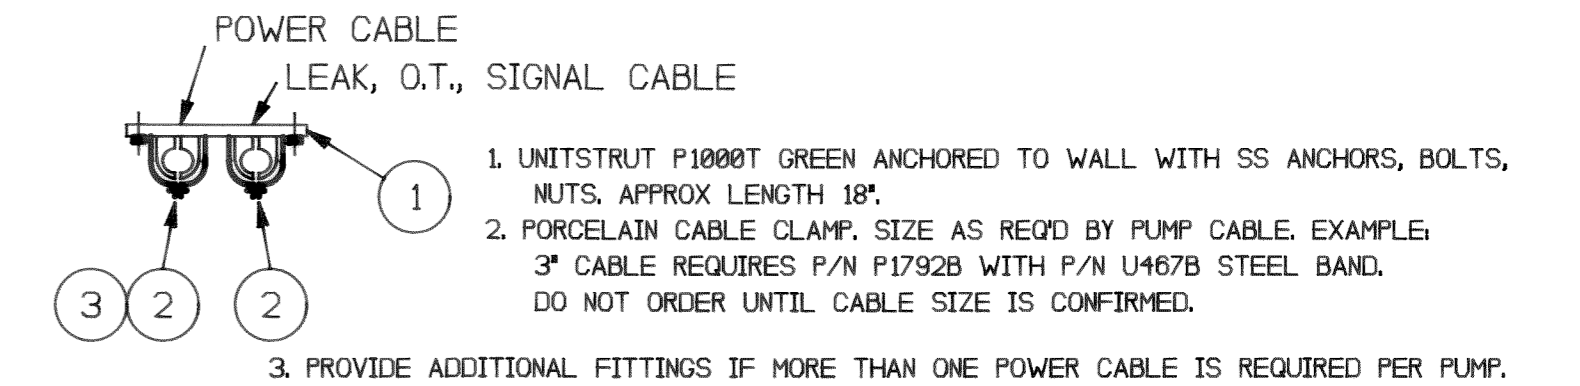


SYMBOL [WC] PORCELAIN WALL CLAMP 3
NOT TO SCALE E5

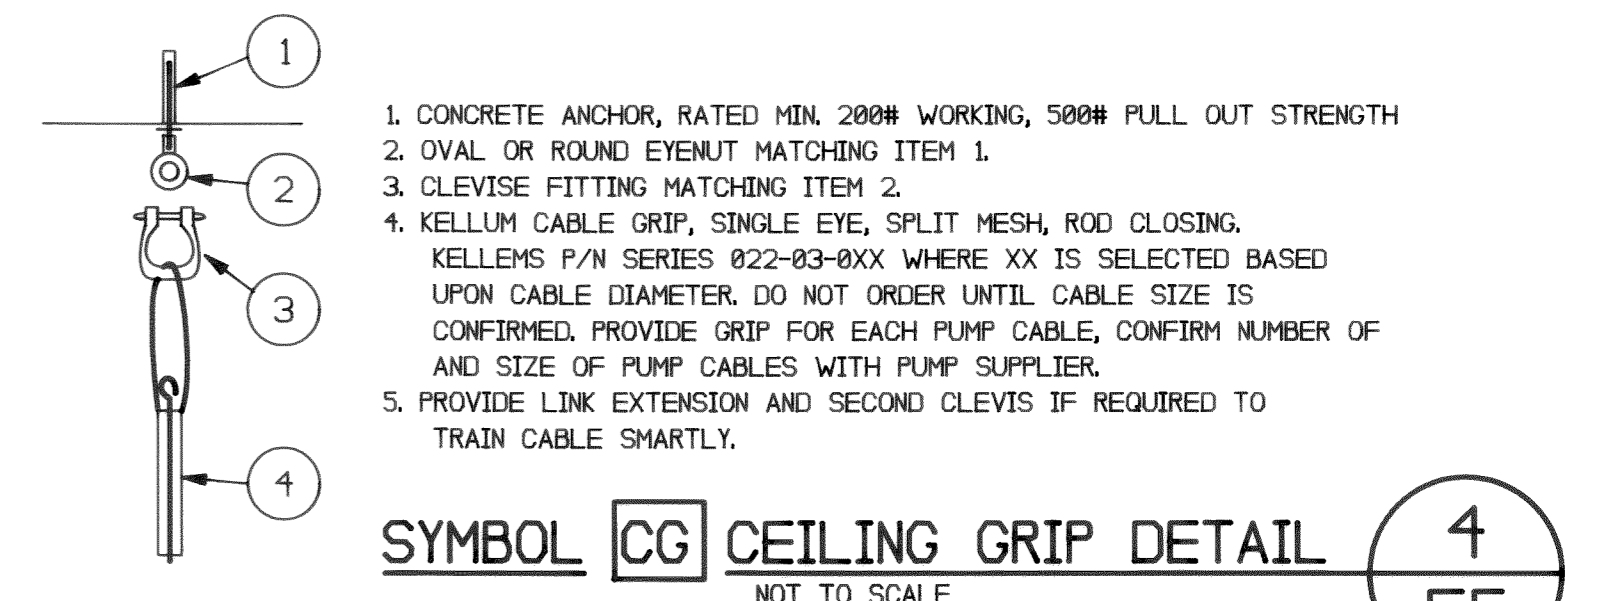

SYMBOL [CG] CEILING GRIP DETAIL 4
NOT TO SCALE E5

NOTES

1. MODIFY SADDLE RACK DETAIL WITH A L-BRACKET, CEILING MOUNTED. LONG LEG OF BRACKET DOWN. MOUNT SADDLE RACK IN VERTICAL POSITION. TWO CEILING ANCHORS.
2. CONDUCT RADIOGRAPHIC EXPLORATION FOR REINFORCING ROD. DO NOT CORE DRILL FLOOR UNTIL REPORT IS APPROVED BY ENGINEER. SEE SPECIFICATION 10015.
3. PROVIDE INDIVIDUAL KELSUM GRIPS FOR EACH POWER CABLE AND EACH SIGNAL CABLE. DO NOT PUT TWO CABLES IN ONE GRIP IF NEEDED TO TRAIN OR SUPPORT CABLES BELOW MCC.
4. LABEL: "ELECTRIC HEATER CIRCUIT 'B'"
5. SCHEDULE 40 PVC CONDUIT SLEEVE THROUGH FLOORS WITH BELL END FITTINGS. SIZE SLEEVE 1 TRADE SIZE LARGER THAN CODE REQUIREMENT FOR CABLE SUPPLIED AS PART OF PUMPS. GROUT IN SLEEVES. CEMENT BELL ENDS TO SLEEVES.
6. EXISTING FLOW METER. REFEED POWER AND SIGNAL CONNECTIONS FROM RELOCATED RECORDER.
7. SUPPLY PUMP CABLES OF SUCH LENGTH TO REACH MCC WITHOUT SPLICE AND WITH ADEQUATE SLACK FOR TRAINING THE CABLES WITHOUT STRAIN. CONTRACTOR TO SPECIFY CABLE LENGTH REQUIRED TO PUMP SUPPLIER. SUPPLY ALL PUMP CABLES THE SAME LENGTH. LOOP SPARE CABLE ON SADDLES ON LOWER LEVEL CEILING.
8. PUMP 4 IS EXISTING, HOWEVER PROVIDE REPLACEMENT CABLES OF CORRECT LENGTH AND INSTALL. PUMPS 1, 2 AND 3 ARE PROPOSED. ORDER CABLES OF CORRECT LENGTH TO REACH MCC WITHOUT SPLICE.
9. DO NOT PROVIDE CONCRETE CURB UNDER MCC BECAUSE OF RESTRICTED HEAD ROOM.

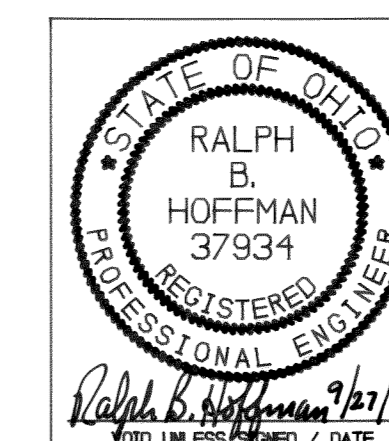

09/15/94
9409BES
E5

DELAWARE COUNTY, OHIO
ALUM CREEK PUMPING STATION

ELECTRICAL REVISIONS - 1994

HOFFMAN ENGINEERING CO.
CONSULTING ELECTRICAL & INSTRUMENTATION ENGINEERS
WESTERVILLE, OHIO
TEL: (614) 890-6272, FAX (614) 794-2030

DELAWARE COUNTY, OHIO
ALUM CREEK PUMPING STATION
ELECTRICAL REVISIONS - 1994

HOFFMAN ENGINEERING CO.
CONSULTING ELECTRICAL & INSTRUMENTATION ENGINEERS
WESTERVILLE, OHIO
TEL: (614) 896-6272, FAX: (614) 794-2836

E6
9/15/94
9408866

6. PROVIDE BUS EXTENSION LINKS BOTH ENDS OF CENTER.

HOIST DISCONNECTING SWITCH


- NOTES:
1. BID CENTER AND DEVICES BASED UPON THIS AVAILABLE FAULT CURRENT.
 - FINAL VALUE TO BE CONFIRMED WITH POWER COMPANY. PROVIDE CIRCUIT BREAKERS OF APPROPRIATE INTERRUPTING RATING.
 2. PULL BOX, 12" H X 20" W X 20" D, OR LARGER IF REQUIRED BY CODE FOR ENTERING CABLE & CONDUIT. ADVISE ENGINEER PROMPTLY IF SIZE IS LARGER.
 3. 800 AMP SUPPLY PROPOSED (2-500 MCM/PHASE), FUTURE 3-500 MCM/PHASE. UTILITY SUPPLY 3 WIRE CORNER GROUNDED DELTA, LOCAL GENERATOR, 4 WIRE WYE.
 4. PLACE AN ADDITIONAL SPECIAL WARNING SIGN, AS LARGE AS FEASIBLE, ON UNIT DOOR READING.
 5. PLACE AN ADDITIONAL SPECIAL WARNING SIGN, AS LARGE AS FEASIBLE, ON UNIT DOOR READING.

MCC UNIT LOCATION NUMBER	MCC UNIT PROJECT MOTOR NUMBER	MCC UNIT NAME/PLATE ENGRAVING	MOTOR HORSE POWER	MOTOR VOLTAGE / PHASE	FUSED SWITCH SIZE W/ REJECTION CLIPS	UL-RK TIME DELAY FUSE RATING AMPS	CB FRAME SIZE	CB TRIP RATING	MCP NEMA SIZE	CB OR MCP NO. BELL ALARM (CLOSE ONLY ON FAULT)	UNIT OPERATOR NO. AUX CONTACTS	STARTER TYPE	NEMA SIZE	NO. AUXILIARY CONTACTS	OVERLOAD RELAY NO. ALARM AUX. CONTACT	2 HV PRT FUSES, OPT, 120 SEC, 1 LV SEC. FUSE OFF-ON SELECTOR SWITCH	HAND-OFF-REMOTE SEL. SW.	AMBER P.T.T. PILOT L.T. (RUN)	RUNNING TIME METER (RTM)	STARTS COUNTER (CTS)	START-STOP PUSH BUTTONS	ADDITIONAL DEVICES	CONDUCTORS	CONDUIT SIZE (INCHES)	MOTOR RATED SAFETY DISCONNECT SWITCH AT LOAD	REMOTE EQUIPMENT AND CONTROL DEVICES	PROVIDE EQ. & DEVICES NOTED OR BY CODED NOTE.	RELATED WORK BY CONTRACTOR	NOTES					
1A	M4	SEWAGE PUMP 4	120	480/3	400	300	400	INTCT	5	X	2	SNC+W/ PUMP CONTROL	5	1	1	X	X	X	X	X	X	2	PL-G (OFF)	2	RELAY (TYPE P) PUMP CABLES TO STARTER	NO	SEE ADDITIONAL REQUIREMENTS IN SPECIFICATIONS AND DRAWINGS (NEXT SHEET)							
2A	M3	SEWAGE PUMP 3	175	480/3	400	400	400	INTCT	5	X	2	SNC+W/ PUMP CONTROL	5	1	1	X	X	X	X	X	X	2	PL-G (OFF)	2	RELAY (TYPE P) PUMP CABLES TO STARTER	NO	SEE ADDITIONAL REQUIREMENTS IN SPECIFICATIONS AND DRAWINGS (NEXT SHEET)							
3A	M2	SEWAGE PUMP 2	175	480/3	400	400	400	INTCT	5	X	2	SNC+W/ PUMP CONTROL	5	1	1	X	X	X	X	X	X	2	PL-G (OFF)	2	RELAY (TYPE P) PUMP CABLES TO STARTER	NO	SEE ADDITIONAL REQUIREMENTS IN SPECIFICATIONS AND DRAWINGS (NEXT SHEET)							
4A	M1	SEWAGE PUMP 1	175	480/3	400	400	400	INTCT	5	X	2	SNC+W/ PUMP CONTROL	5	1	1	X	X	X	X	X	X	2	PL-G (OFF)	2	RELAY (TYPE P) PUMP CABLES TO STARTER	NO	SEE ADDITIONAL REQUIREMENTS IN SPECIFICATIONS AND DRAWINGS (NEXT SHEET)							
5A		INCOMING LUG COMPARTMENT																																
5C		INCOMING LUG COMPARTMENT																																
5E		SPARE CB	150	20																														
5F		SPARE CB	150	20																														
5G		GRINDER FEEDER	150	30																														
5K		CONTROL PANEL FEEDER	150	15																														
5L	M6	HOIST DISCONNECTING SWITCH	150	15																														
5M		LIGHTING TRANSFORMER	150	40																														
5N		ELECTRIC HEATER CIRCUIT W.	150	30																														
5P		ELECTRIC HEATER CIRCUIT B.	150	20																														

3

WIRE	ENCLOSURE	INCOMING SUPPLY	BUS WORK				MISCELLANEOUS				
NEMA TYPE CLASS 2 WITH INTERWIRING	DEPTH FRONT MOUNTING	VOLTAGE LINE	CONNECTION	CABLE SIZE	MAIN BUS	BRAC-ING	GROUND	NEUTRAL BUS	U.L. SERVICE ENTRANCE	PROTECTIVE CAPS	MASTER NAME PLATE INSCRIPTION
1A <input type="checkbox"/> 1B <input type="checkbox"/> 2C <input type="checkbox"/>	15 <input type="checkbox"/> 30 <input type="checkbox"/> 40 <input type="checkbox"/> 60 <input type="checkbox"/>	3 PHASE, 60 HERTZ	LUGS ONLY	500 MCM	600 800 1000 1200 1600 2500	42000 65000 100000	NONE	NONE	U.L. LISTED SECTIONS & UNITS	UNIT ISOLATION BARRIER	ALUM CREEK PUMPING STATION
CLASS 1 WITHOUT INTERWIRING	FRONT MOUNTING	3 PHASE, 60 HERTZ	MAIN CB	TOTAL PER	ALUMINUM	AMPS, (RMS SYMMETRICAL)	PLATING	NEUTRAL SYS. AND LOADS.	AUTOMATIC SHUTTERS	BETWEEN UNIT & VERTICAL	ALUM CREEK PUMPING STATION
CLASS 2 WITH INTERWIRING	BACK TO BACK (INCHES)	OTHER	FUSIBLE	NO. OF INCOM	ALUMINUM	AMPS, (RMS SYMMETRICAL)	PLATING	NEUTRAL SYS. AND LOADS.	MANUAL SHUTTERS	UNIT ISOLATION BARRIER	ALUM CREEK PUMPING STATION
1A <input type="checkbox"/> 1B <input type="checkbox"/> 2C <input type="checkbox"/>	BACK TO BACK (INCHES)	OTHER	SWITCH	NO. OF INCOM	ALUMINUM	AMPS, (RMS SYMMETRICAL)	PLATING	NEUTRAL SYS. AND LOADS.	MANUAL SHUTTERS	BETWEEN UNIT & VERTICAL	ALUM CREEK PUMPING STATION
■ MEANS TO PROVIDE FEATURE

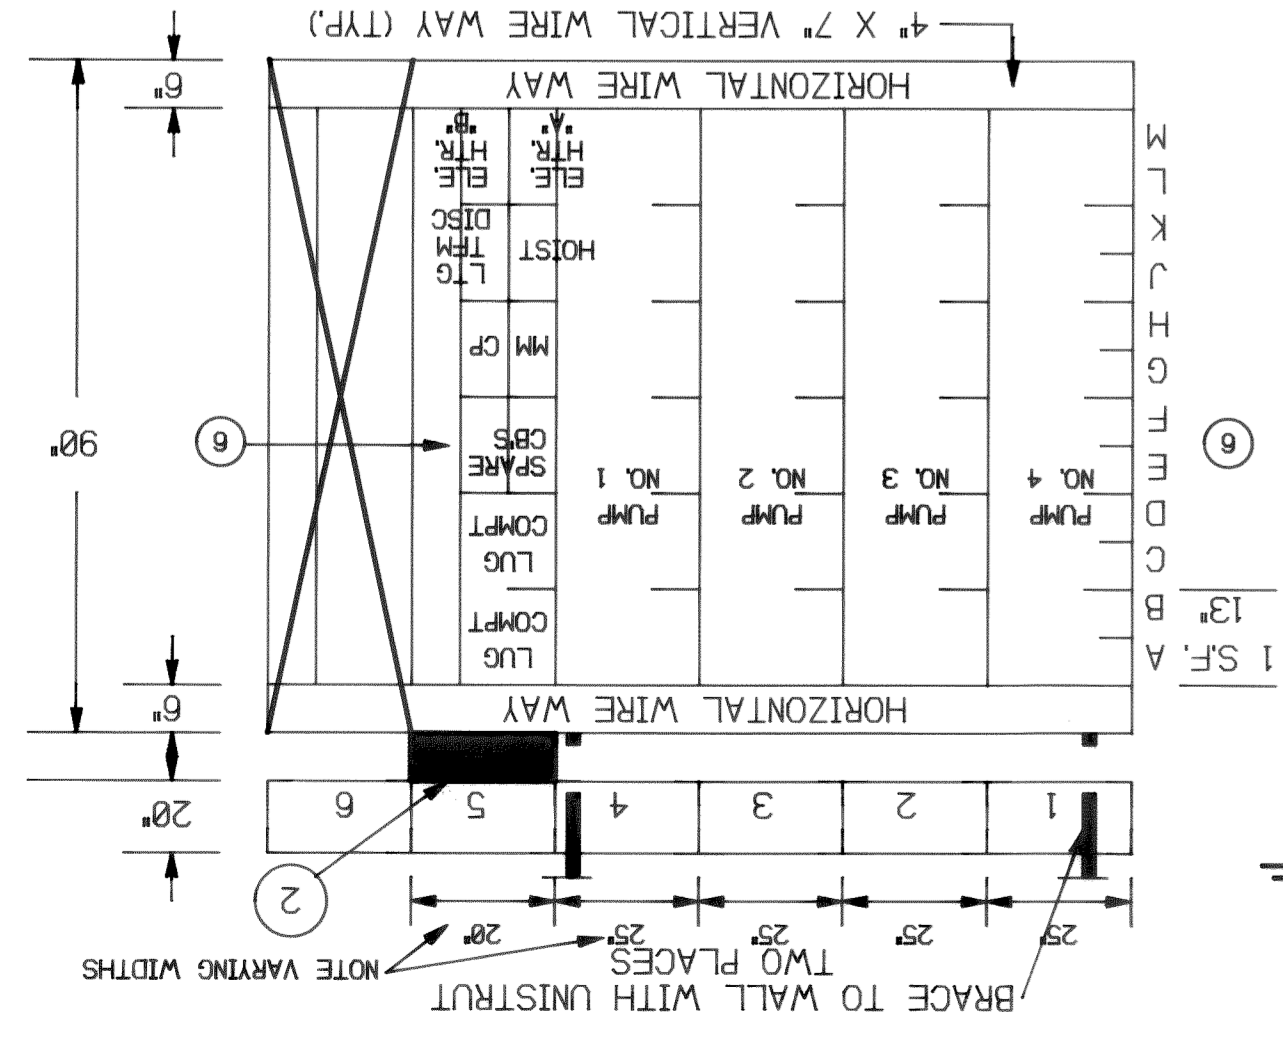

MCC NO. 1

X MEANS TO PROVIDE FEATURE OR CHARACTERISTIC / CAPACITY NUMBERS IN COLUMNS MEAN QUANTITY

MCC SMC UNIT NOTES

- STARTS COUNTER, 120 VAC, 5 DIGIT MINIMUM, RATED FOR CONTINUOUS ENERGIZING. PROVIDE LABEL: NON-RESET.
- RUNNING TIME METER, 120 VAC, 6 DIGIT, TIME UNITS IN MINUTES, NON-RESET.
- PROVIDE INTERPOSING RELAY IF SMC CONTACTS 70-80-90 DO NOT HAVE SUFFICIENT CAPACITY FOR INDICATED LOADS.
- RELAYS CR1 AND CR2, A-B, TYPE P, 4 NO CONTACTS.
- EMERGENCY STOP PUSH BUTTON WARNING PLATE:

EMERGENCY STOP
 WARNING - EMERGENCY STOP SHUTS OFF MOTOR IMMEDIATELY.
 PUMP CONTROL STOP IS DEFEATED BY EMERGENCY STOP.
 DANGER - MOTOR MAY RESTART IMMEDIATELY WHEN
 EMERGENCY STOP PUSH BUTTON IS RELEASED.
 DO NOT RELEASE EMERGENCY STOP BUTTON UNTIL PROBLEM
 IS COMPLETELY RESOLVED.

- STANDARD DUTY (SMC PLUS) SOLID STATE MOTOR CONTROLLER, BULLETIN 2155F
 LINE VOLTAGE: 480 VAC L-L, 3 PHASE, DELTA SOURCE.
 CONTROL TRANSFORMER: 120/240 V, SPECIAL, SEE NOTE 9.
 STANDARD DUTY AMPS: 240 AMPERES
 NOMINAL MAX HORSEPOWER: 200
 PUMP CONTROL OPTION 13XB
 LINE SIDE PROTECTION MODULE OPTION 13D
 LOAD SIDE PROTECTION MODULE OPTION 13E
 SCR FUSES
- ISOLATION CONTACTOR, SIZE 5, NOTE 240 VAC COIL.
- OVERLOAD RELAY WITH 3 NEMA CLASS 20 HEATERS SIZED TO SPECIFIC MOTOR NPC
- CONTROL POWER TRANSFORMER WITH 2 PRIMARY AND 2 SECONDARY FUSES.
 VA AND INRUSH VA PER LOADS SHOWN, 480 VAC PRI, 120/240 VAC SEC.
 NOTE NON-STANDARD CONNECTIONS. PLEASE CONSULT WITH MR. DAVID FORD,
 AT ALLEN-BRADLEY, (414) 382-2514 WITH QUESTIONS.
- PUSH TO TEST, TRANSFORMER PILOT LIGHT, AMBER, "ON" OR "RUN".
- PUSH TO TEST, TRANSFORMER PILOT LIGHT, GREEN, "OFF".
- IT IS THE INTENT THAT PUMP SECTIONS 1, 2, 3 AND 4 BE IDENTICAL AND
 INTERCHANGEABLE IN FUNCTION. IT SHALL ONLY BE NECESSARY TO CHANGE OL HEATERS
 AND MCP TRIP ADJUSTMENTS TO OPERATE 120 TO 175 HP MOTORS FROM
 ANY OF THE FOUR SECTIONS.

SECTION	HP	THERMAL MAGNETIC CB TRIP
1	PROPOSED 175 HP	400
2	PROPOSED 175 HP	400
3	PROPOSED 175 HP	400
4	EXISTING (AND TO CONTINUE) 120 HP	300

IF MCP'S CAN NOT ACCOMPLISH THE REQUIREMENT, PROVIDE INTERCHANGEABLE TRIP 400 A FRAME THERMAL-MAGNETIC TRIP CIRCUIT BREAKERS WITH THE TRIP UNITS LISTED ABOVE.


- PROVIDE TERMINAL BLOCKS AS SHOWN FOR FEED THRU WIRING AND REMOTE DEVICES.
- PROVIDE WARNING SIGN NEAR H-O-R SWITCH READING:

WARNING
 H-O-R SWITCH OPERATES IN "PUMP CONTROL" MODE. MOTOR DOES NOT SHUT
 OFF IMMEDIATELY WHEN SWITCH IS TURNED TO OFF. USE EMERGENCY
 STOP BUTTON WHEN EMERGENCY STOP IS REQUIRED.

- PROVIDE WARNING SIGN ON PUMP CONTROLLERS 1 AND 2 READING:

DANGER
 DO NOT CHANGE H-O-R SWITCH FROM REMOTE POSITION WHEN PUMPS 1 & 2
 MODE SWITCH ON LEVEL CONTROL PANEL CP1 IS IN THE SERIES MODE,
 AND OR THE PUMP 1 & 2 VALVES ARE IN THE SERIES POSITIONS.
 BODILY INJURY AND EQUIPMENT DAMAGE MAY RESULT FROM THE FAILURE
 TO FOLLOW THESE INSTRUCTIONS.

- HMCP OR INTERCHANGEABLE TRIP THERMAL-MAGNETIC CIRCUIT BREAKER.
- USED ON PUMPS 1 AND 2 FOR SERIES SEQUENCE MODE LOGIC.
- SURGE SUPPRESSOR, 700-N24
- SURGE SUPPRESSOR, NOTE 240 VAC, 599-KA04

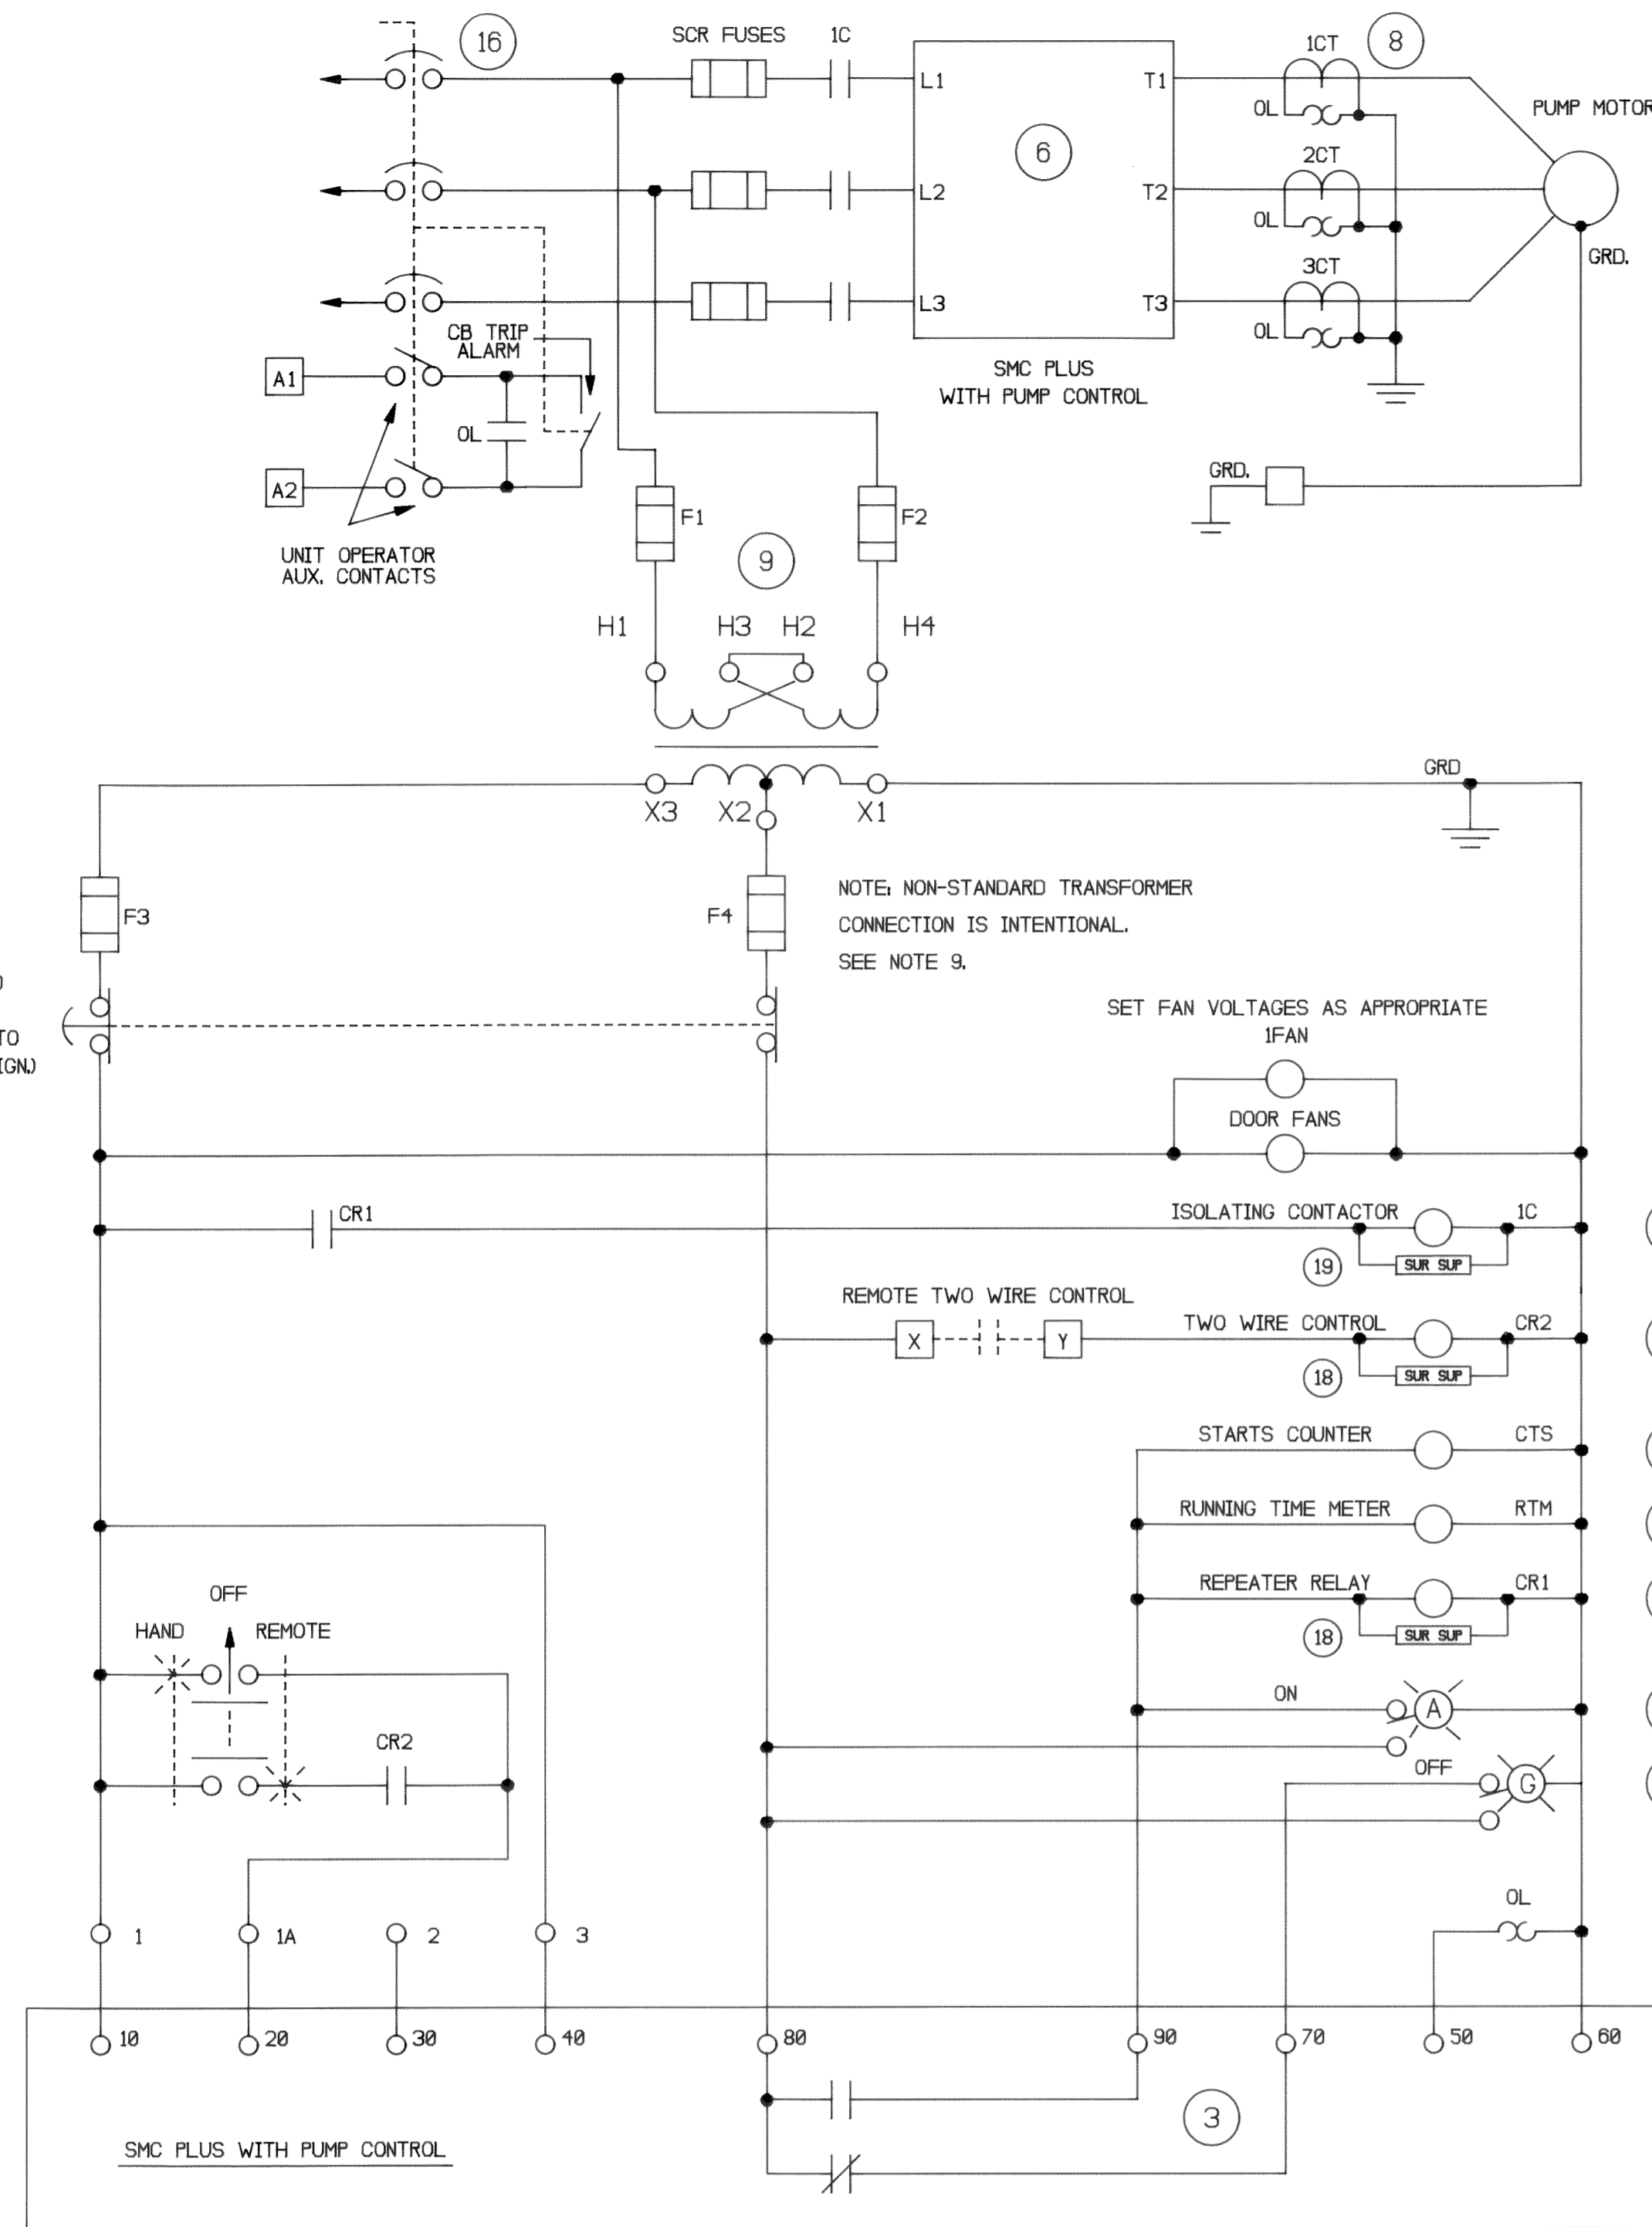

EMERGENCY STOP
 (MECHANICALLY LATCHED
 IN OPEN POSITION
 WHEN OPERATED. TWIST TO
 RELEASE. WITH WARNING SIGN)
 800T-FXJT6A5

JUMBO LEGEND PLATE
 800T-XB47

NOTE: NON-STANDARD TRANSFORMER
 CONNECTION IS INTENTIONAL.
 SEE NOTE 9.

SET FAN VOLTAGES AS APPROPRIATE
 IFAN

DOOR FANS

ISOLATING CONTACTOR 1C

REMOTE TWO WIRE CONTROL

TWO WIRE CONTROL


STARTS COUNTER CTS

RUNNING TIME METER RTM


REPEATER RELAY 18

ON OFF

SMC PLUS WITH PUMP CONTROL

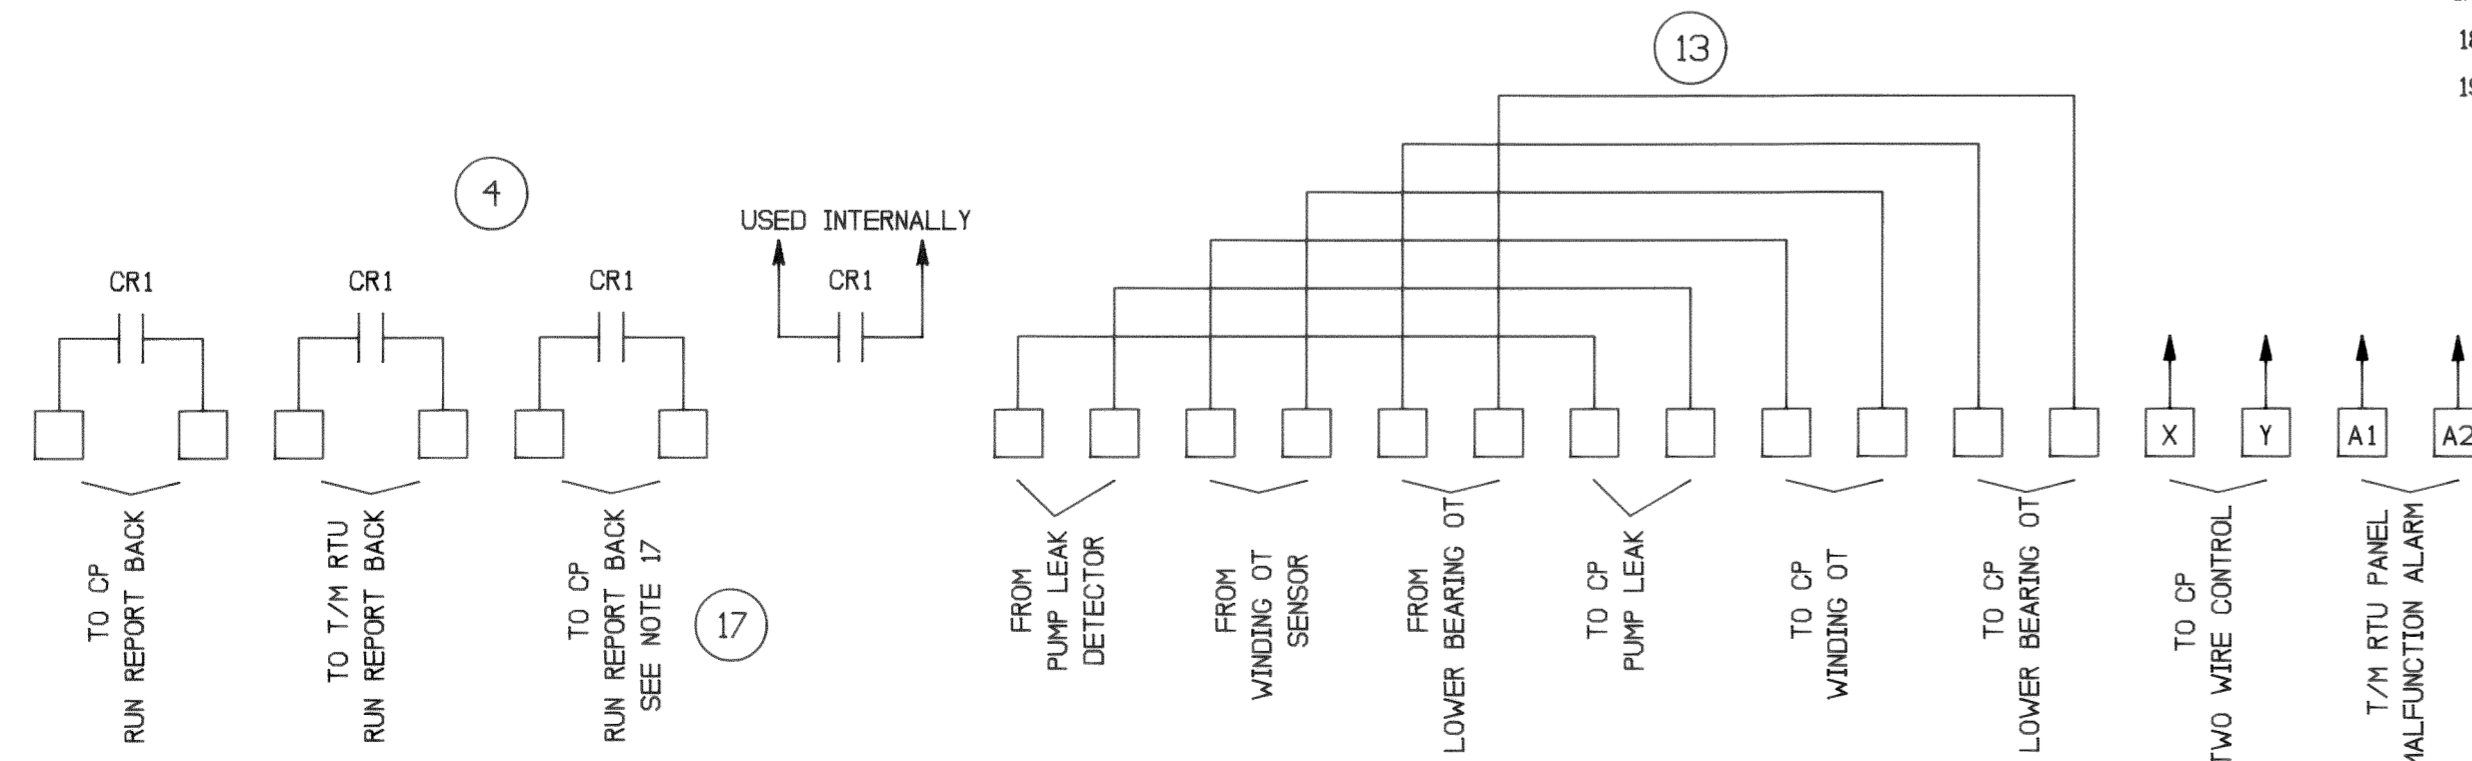






PUMPS 1, 2, 3 & 4 SMC+ PUMP CONTROL UNITS

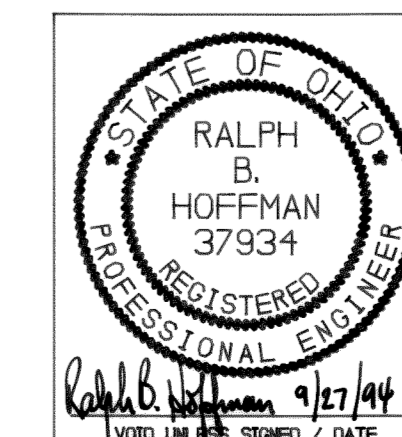

09/15/94
 9409BE7

E7

DELAWARE COUNTY, OHIO
 ALUM CREEK PUMPING STATION
 ELECTRICAL REVISIONS - 1994
 HOFFMAN ENGINEERING CO.
 CONSULTING ELECTRICAL & INSTRUMENTATION ENGINEERS
 WESTERVILLE, OHIO
 TEL: (614) 890-6272, FAX (614) 794-2030

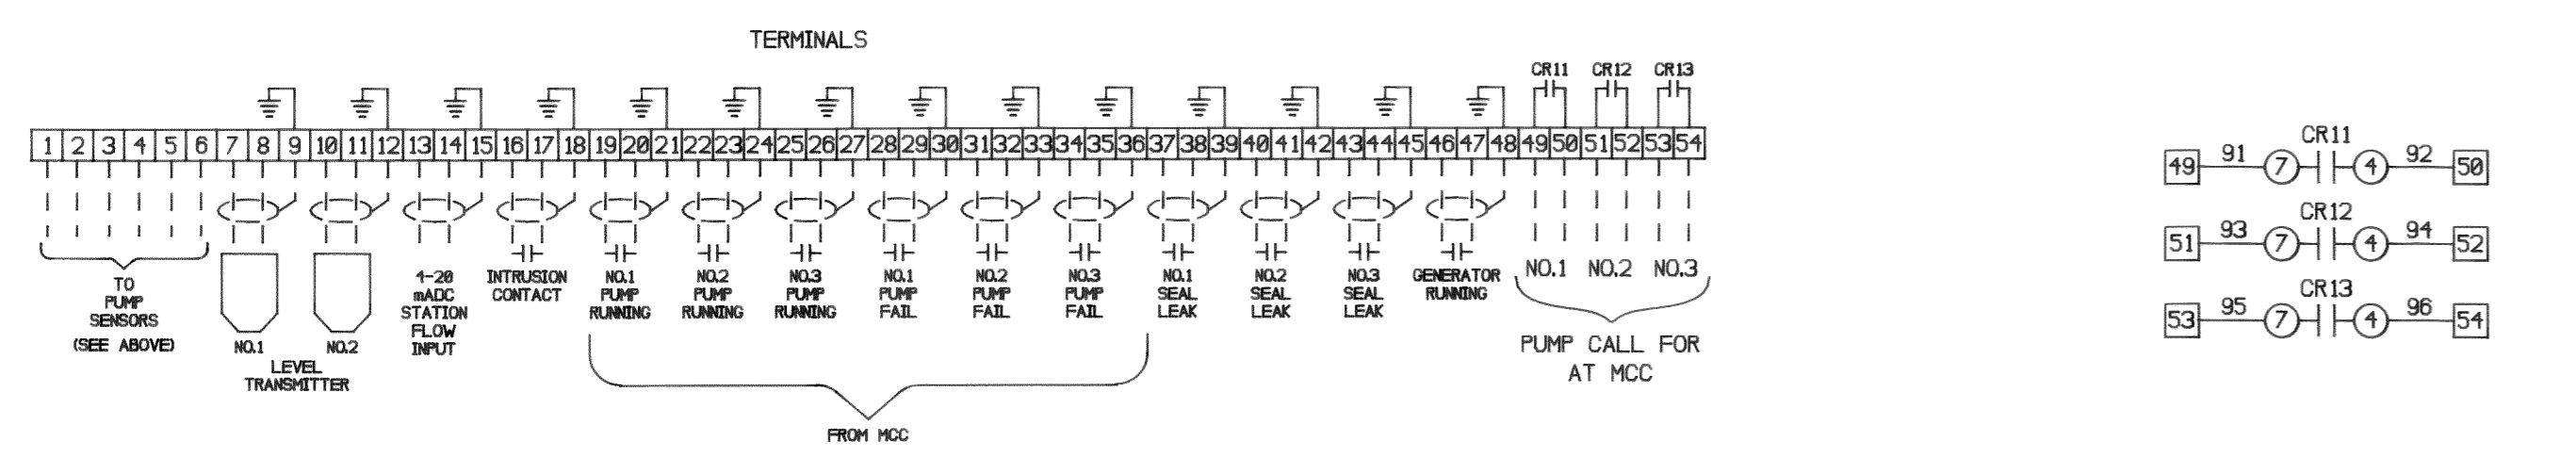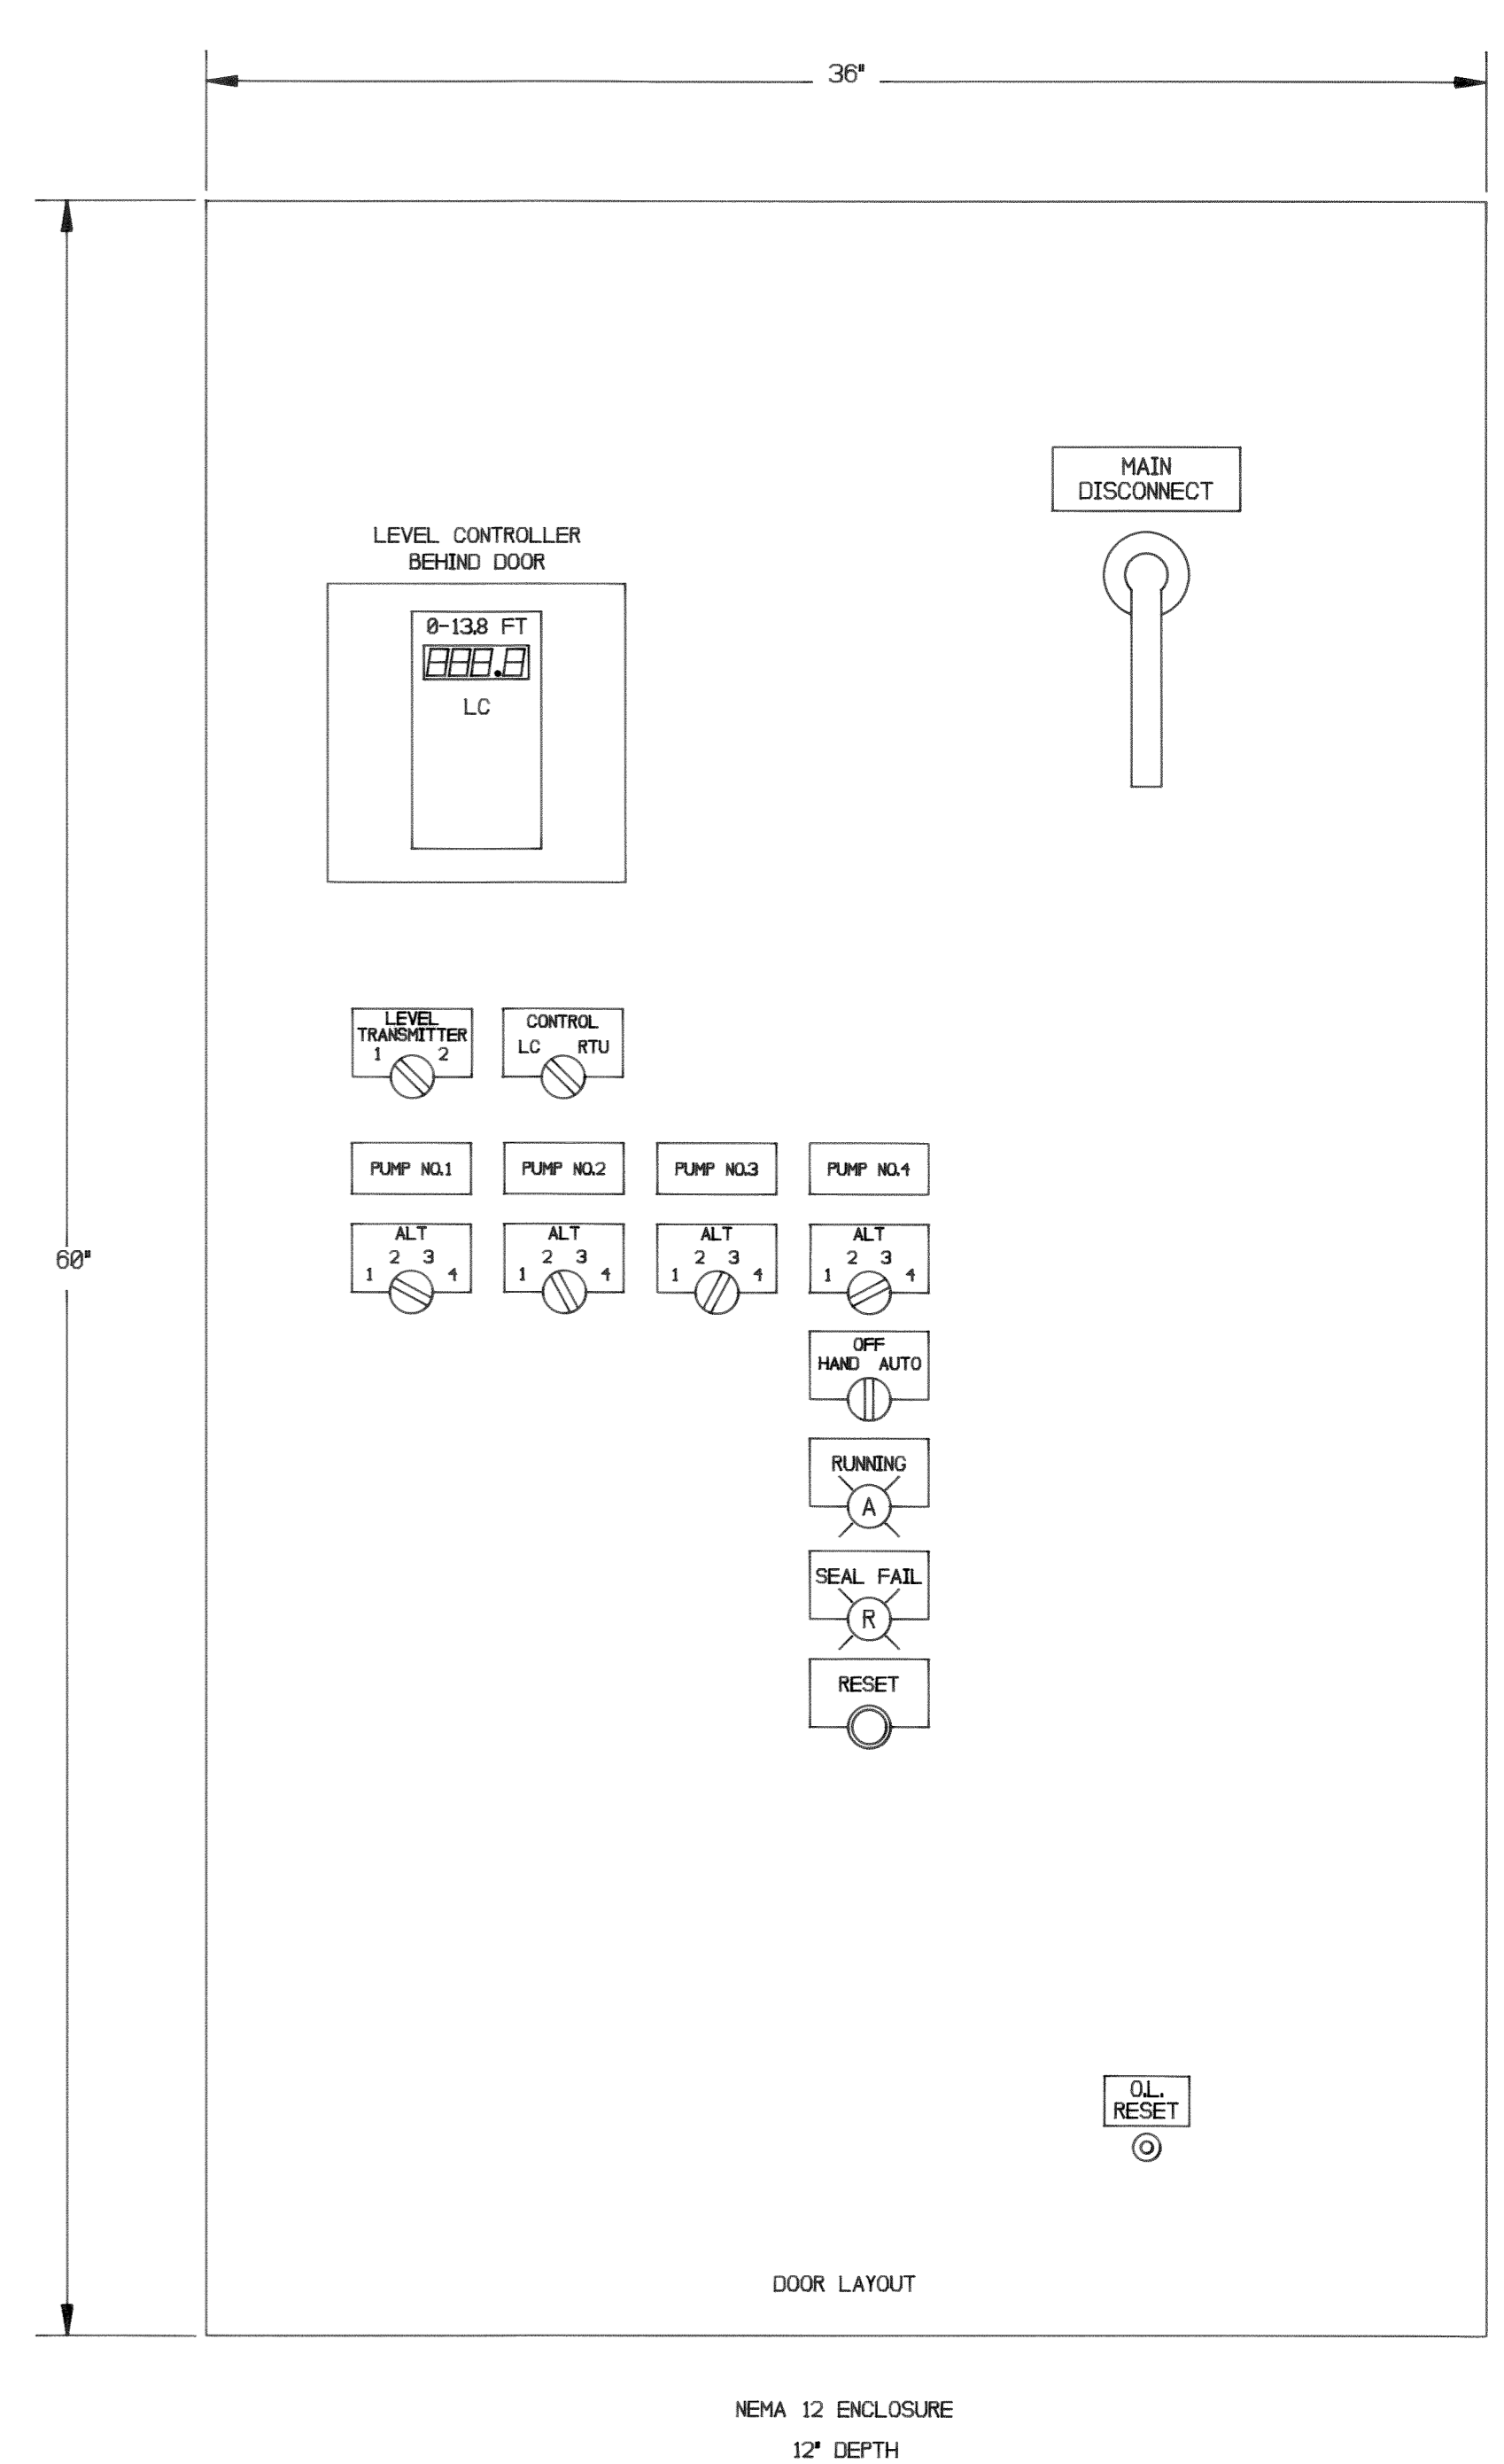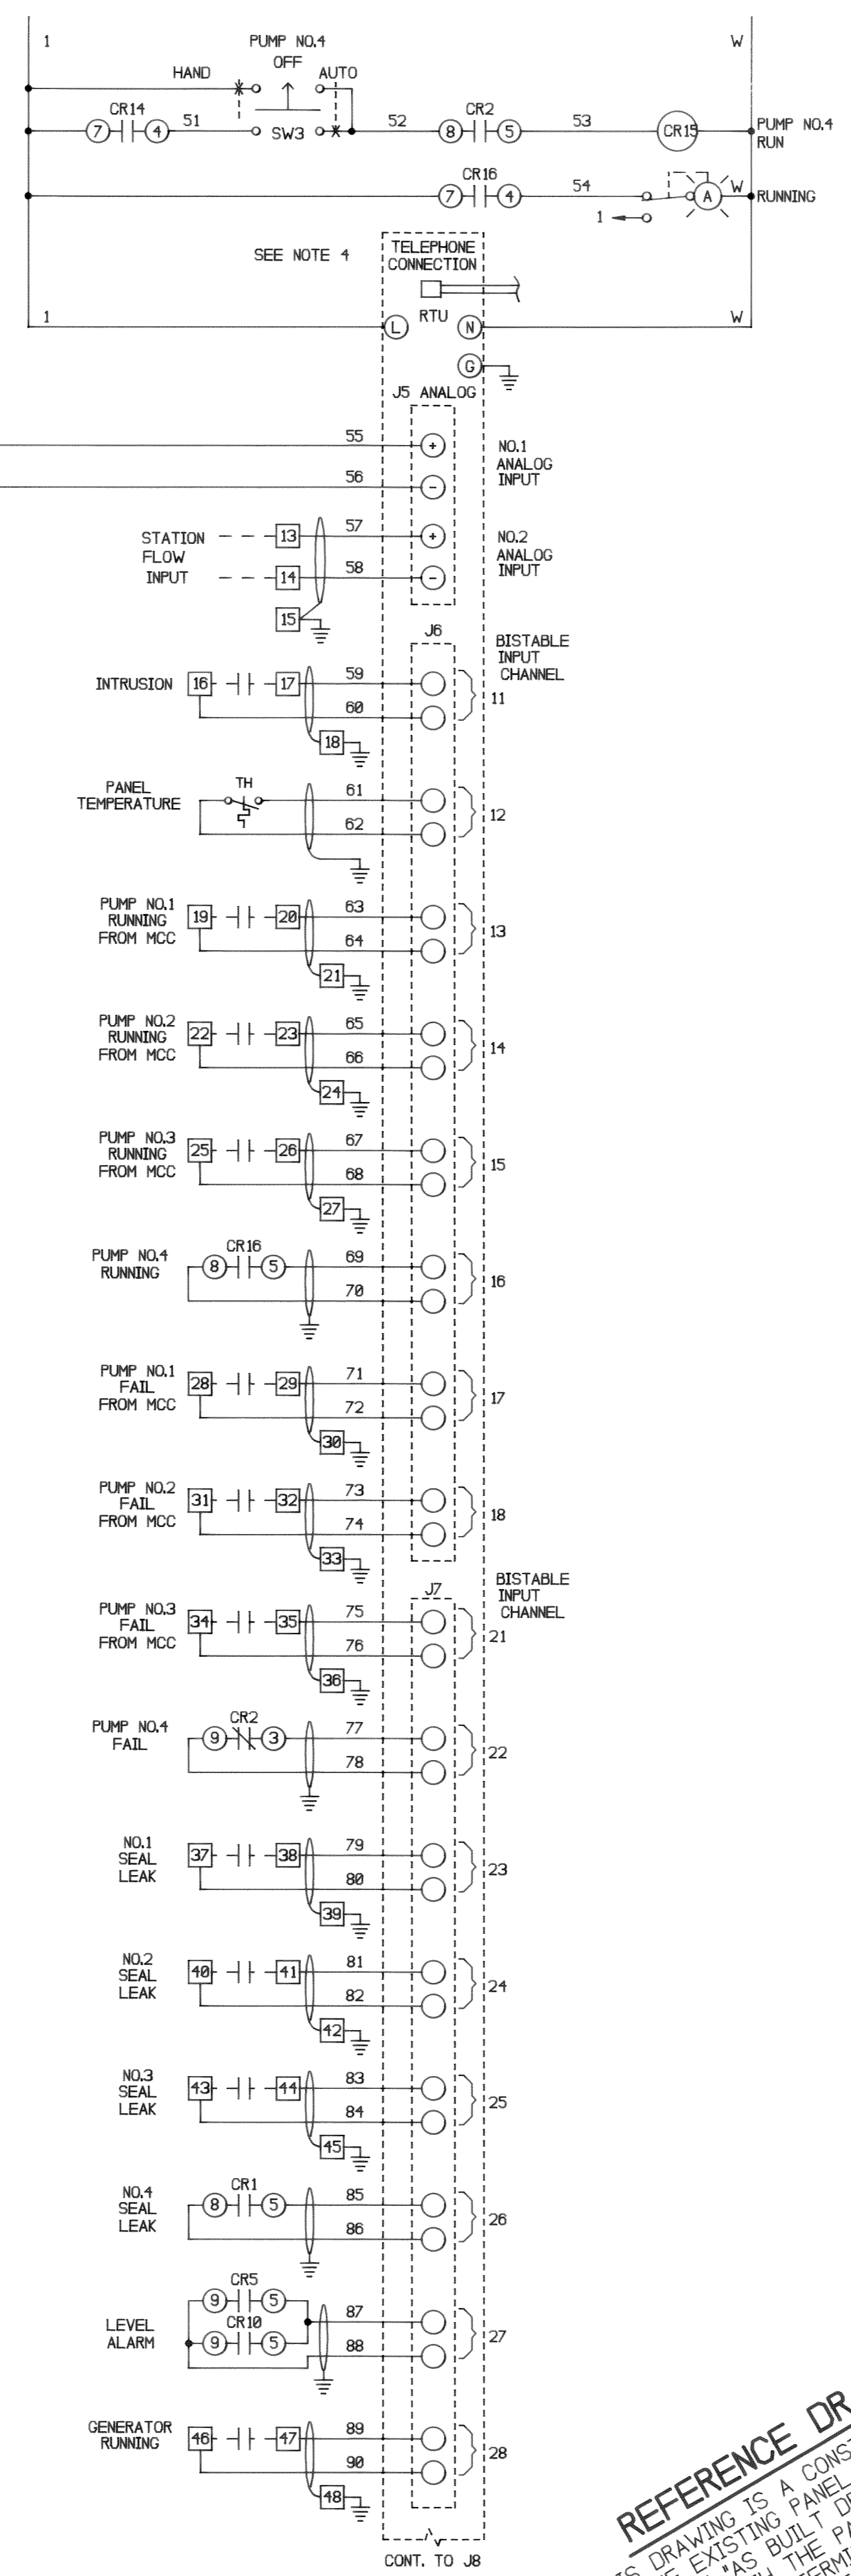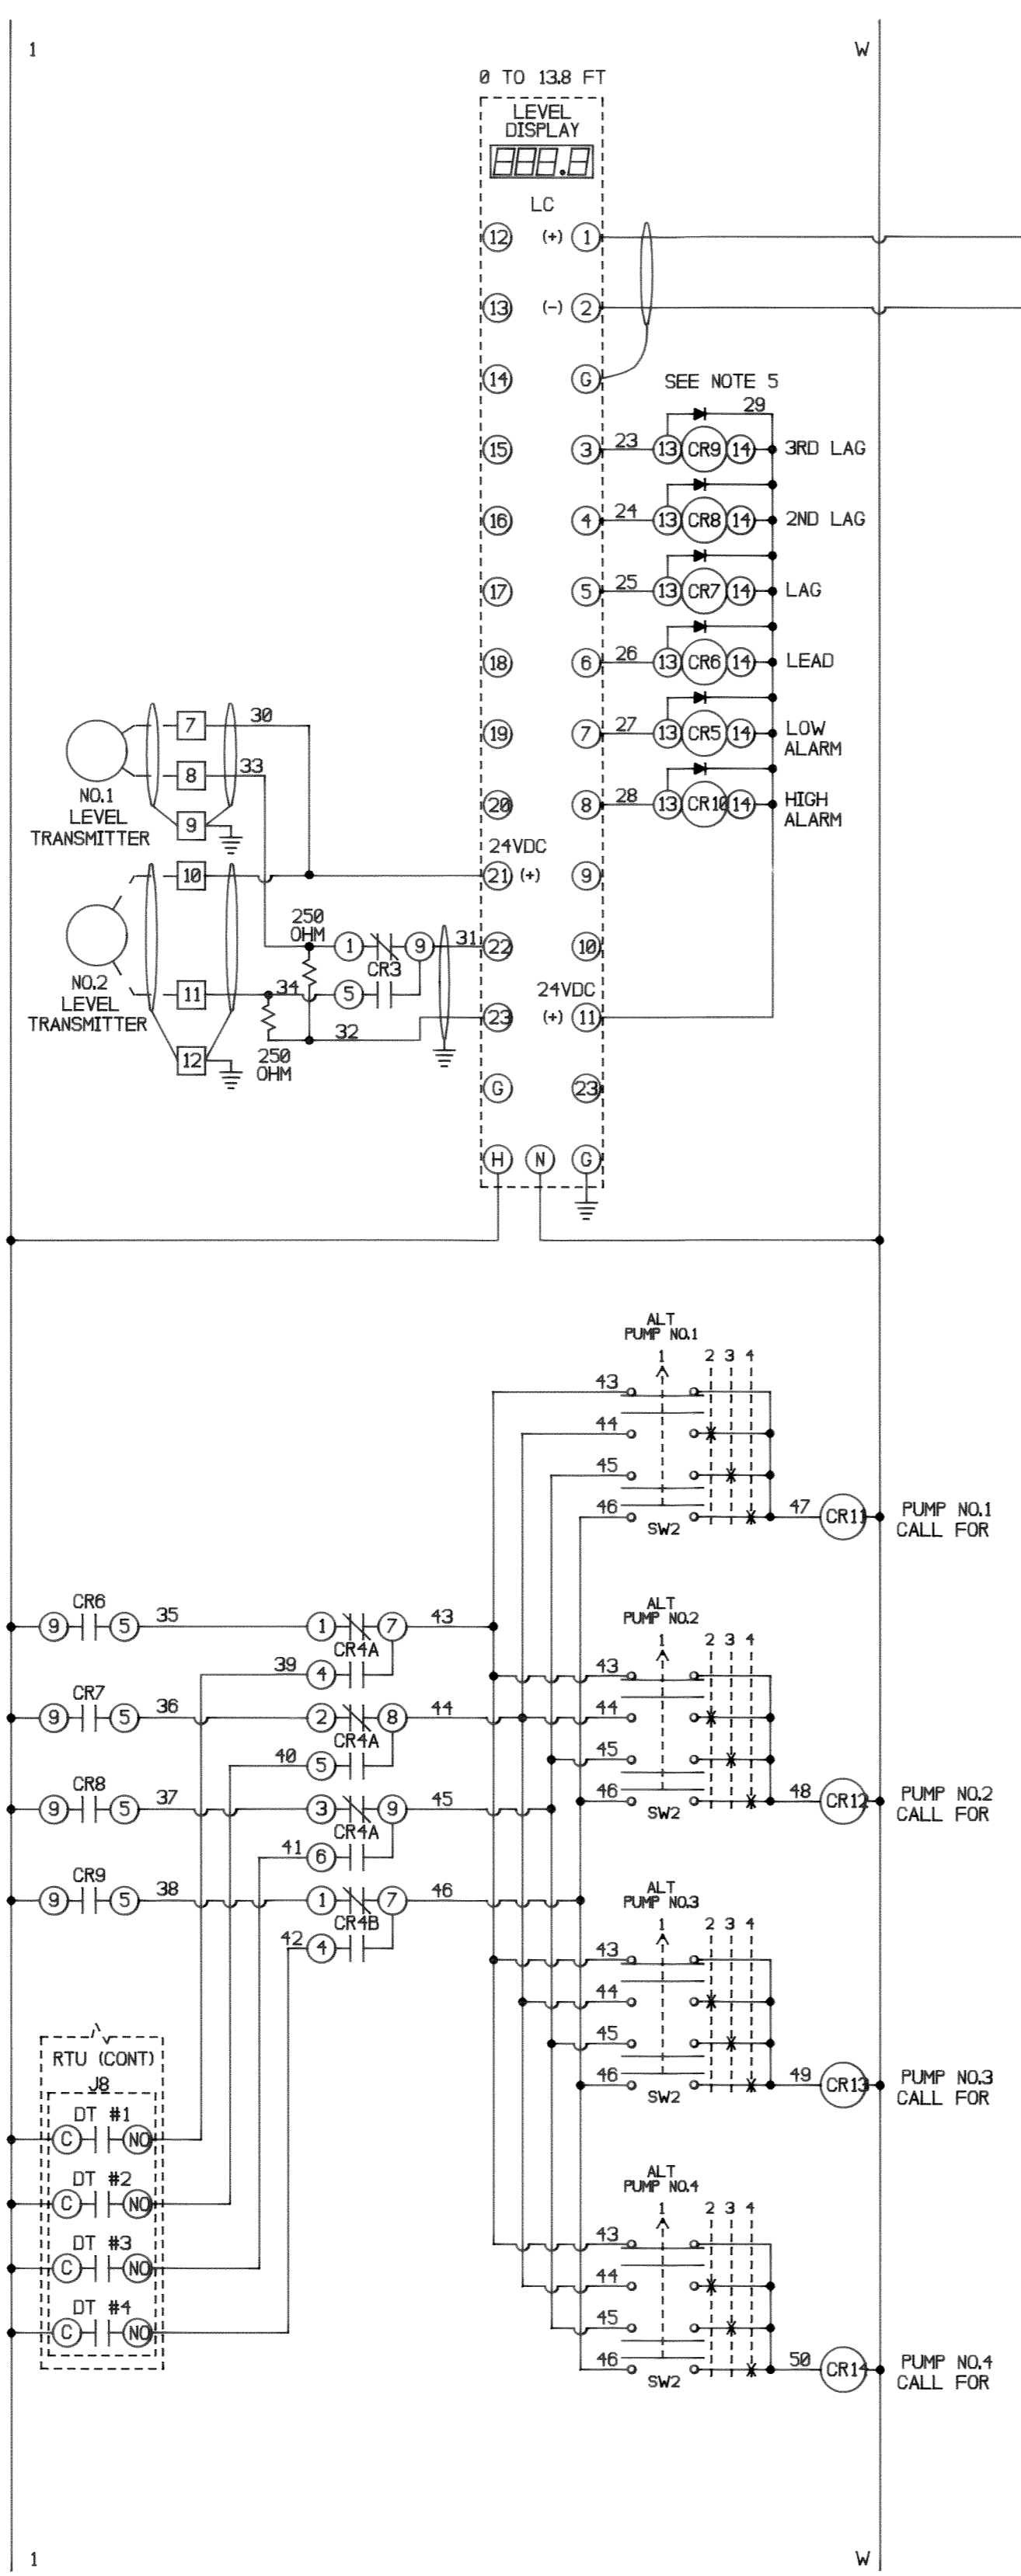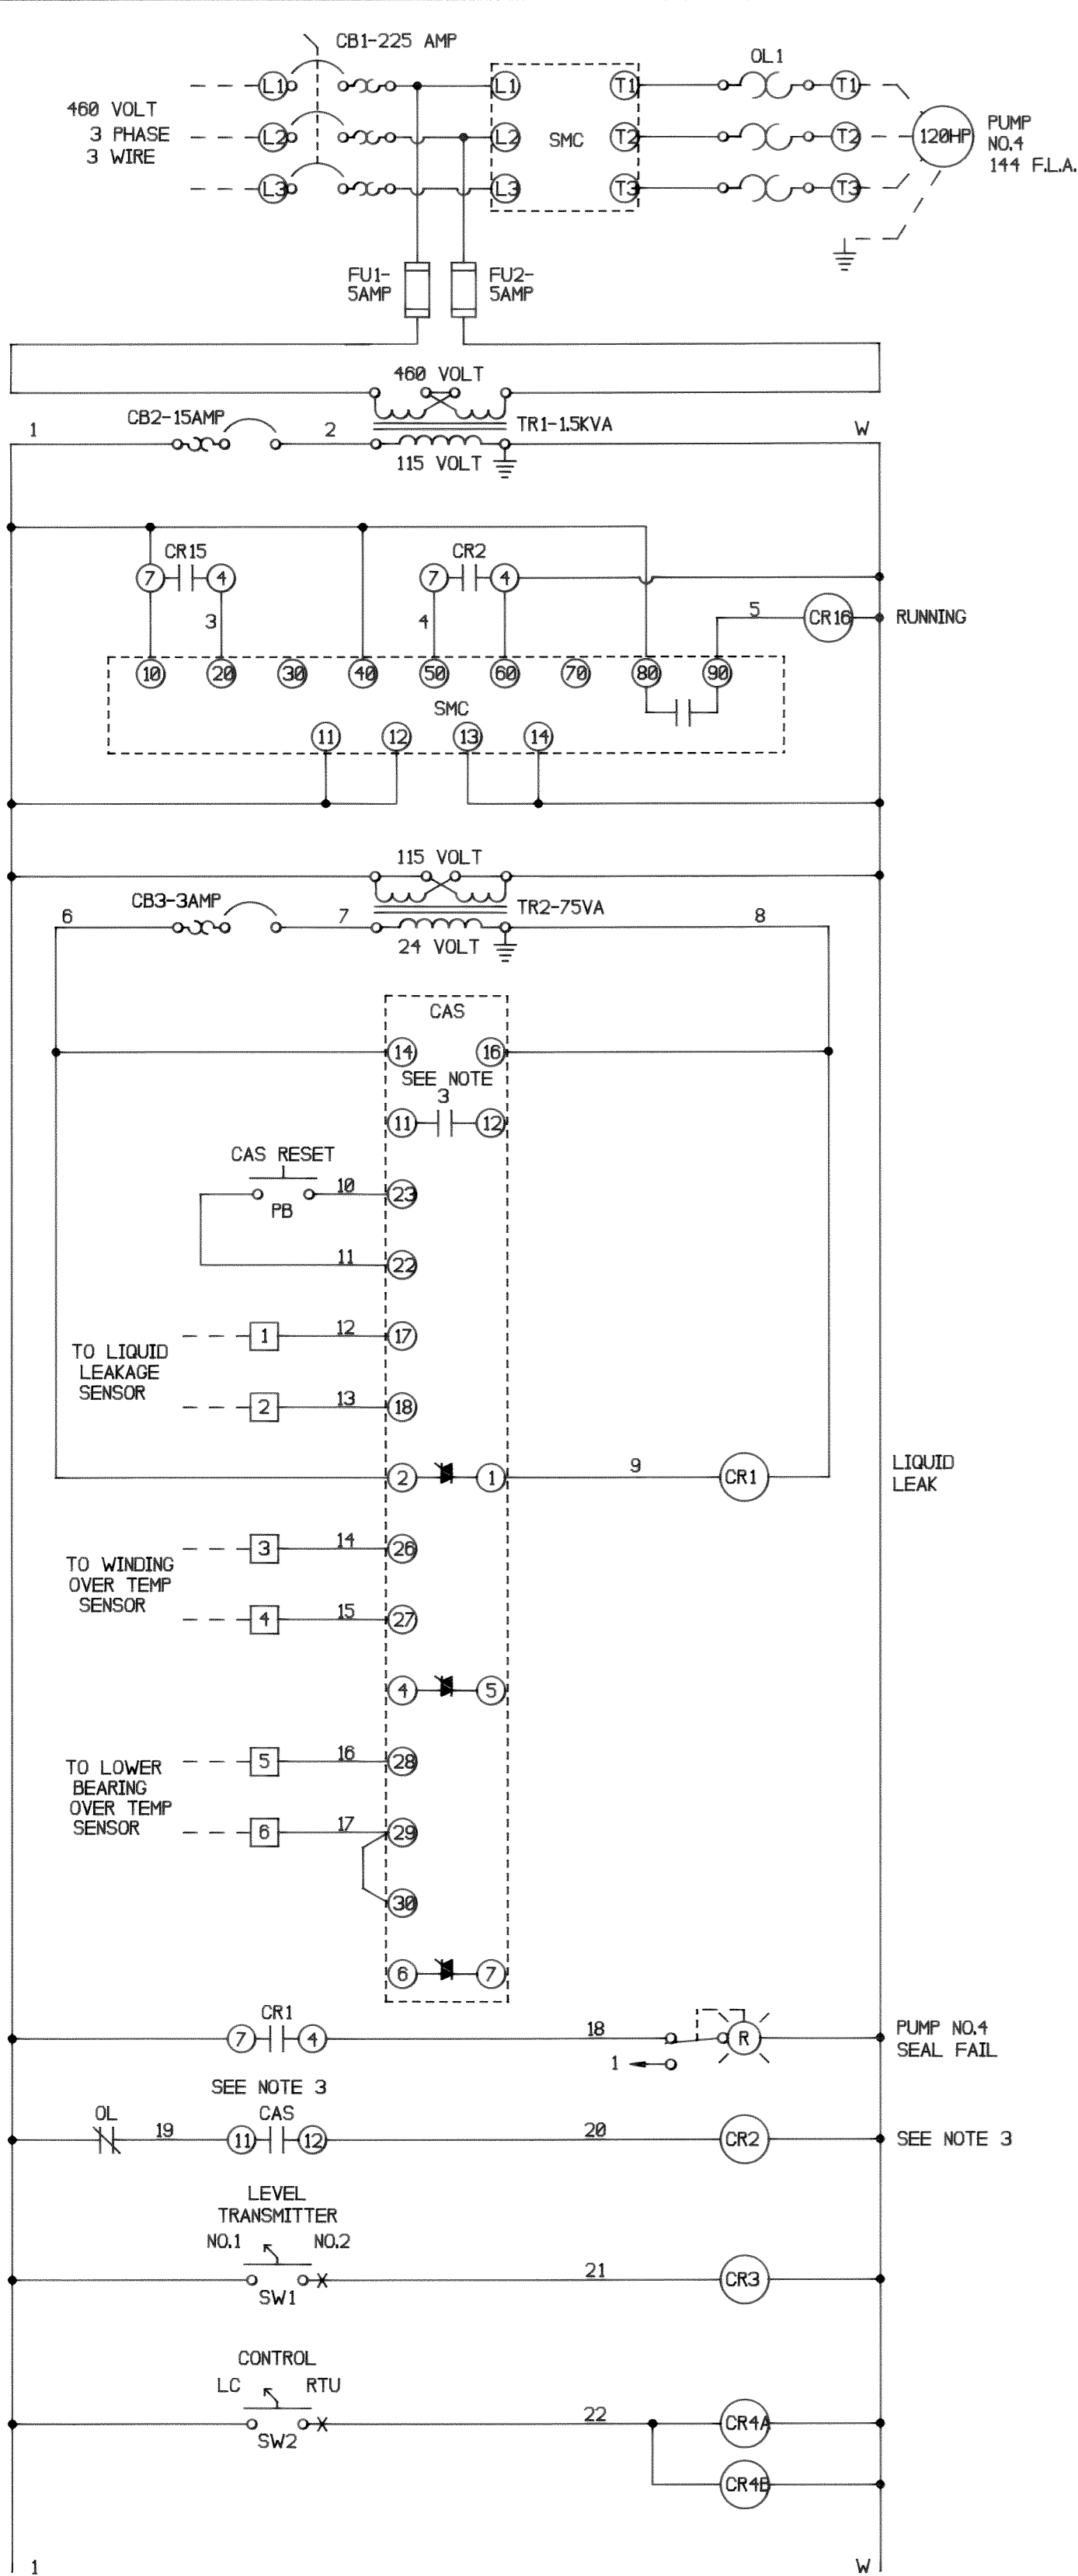

- NOTES
- 1) PANEL GROUND TERMINAL MUST BE CONNECTED TO EARTH GROUND.
 - 2) FACTORY WIRING IS SHOWN
FIELD WIRING IS SHOWN - - - - -
 - 3) PUMP MONITORING UNIT (CAS) ALARM INTERLOCK CONTACT (TERMINAL 11 & 12) IS ENERGIZED CLOSED. IT OPENS UPON ALARM. RELAY CR2 IS ALSO ENERGIZED.
 - 4) SURGE SUPPRESSOR TO BE CONNECTED TO RTU.
 - 5) SILVER BAND ON DIODE TO BE CONNECTED TO TERMINAL 14 ON RELAY.

REFERENCE DRAWING
 THIS DRAWING IS A CONSTRUCTION DRAWING OF THE EXISTING PANEL. IT IS NOT WARRANTED TO BE AN "AS BUILT" DRAWING. WORK THIS DRAWING WITH THE PANEL FINAL CONFIGURATION PARTS AND LABOR TO MODIFY THE EXISTING PANEL.

WIRE TYPE	SIZE	COLOR
POWER	8 AWG	BLACK
120V CONTROL	14 AWG	RED
120V NEUTRAL	14 AWG	WHITE
GROUND	14 AWG	GREEN
24 VAC	14 AWG	BLUE
12 VDC	14 AWG	BLUE

1 OF 1

Revision Dates

1. 10-5-92
2. AB.11-11-92
- 3.
- 4.
- 5.
- 6.
- 7.
- 8.
- 9.
- 10.

CONTROL WORKS INC.
 1179 U.S. Highway 50 * Milford, Ohio 45158 * (513) 831-9859

ALUM CREEK PUMP STATION
 SIMPLEX/PILOT/RTU PANEL

Power Requirements
 120 HP 144 F.L.A. 460 Volts 3 Phase 60 Hz

Drawn By: YATES/JANSENS
 Designed By: R.E.V.
 Checked By: As Built By: Date: 9-17-92

Customer/Project Name & Number: THE RIGHTER COMPANY
 Drawing Number: **CW 2239**




2- 3-2390

09/15/94
 9409BE8
 E8

DELAWARE COUNTY, OHIO
 ALUM CREEK PUMPING STATION

ELECTRICAL REVISIONS - 1994

HOFFMAN ENGINEERING CO.
 CONSULTING ELECTRICAL & INSTRUMENTATION ENGINEERS
 WESTERVILLE, OHIO
 TEL: (614) 890-6272, FAX: (614) 794-2030

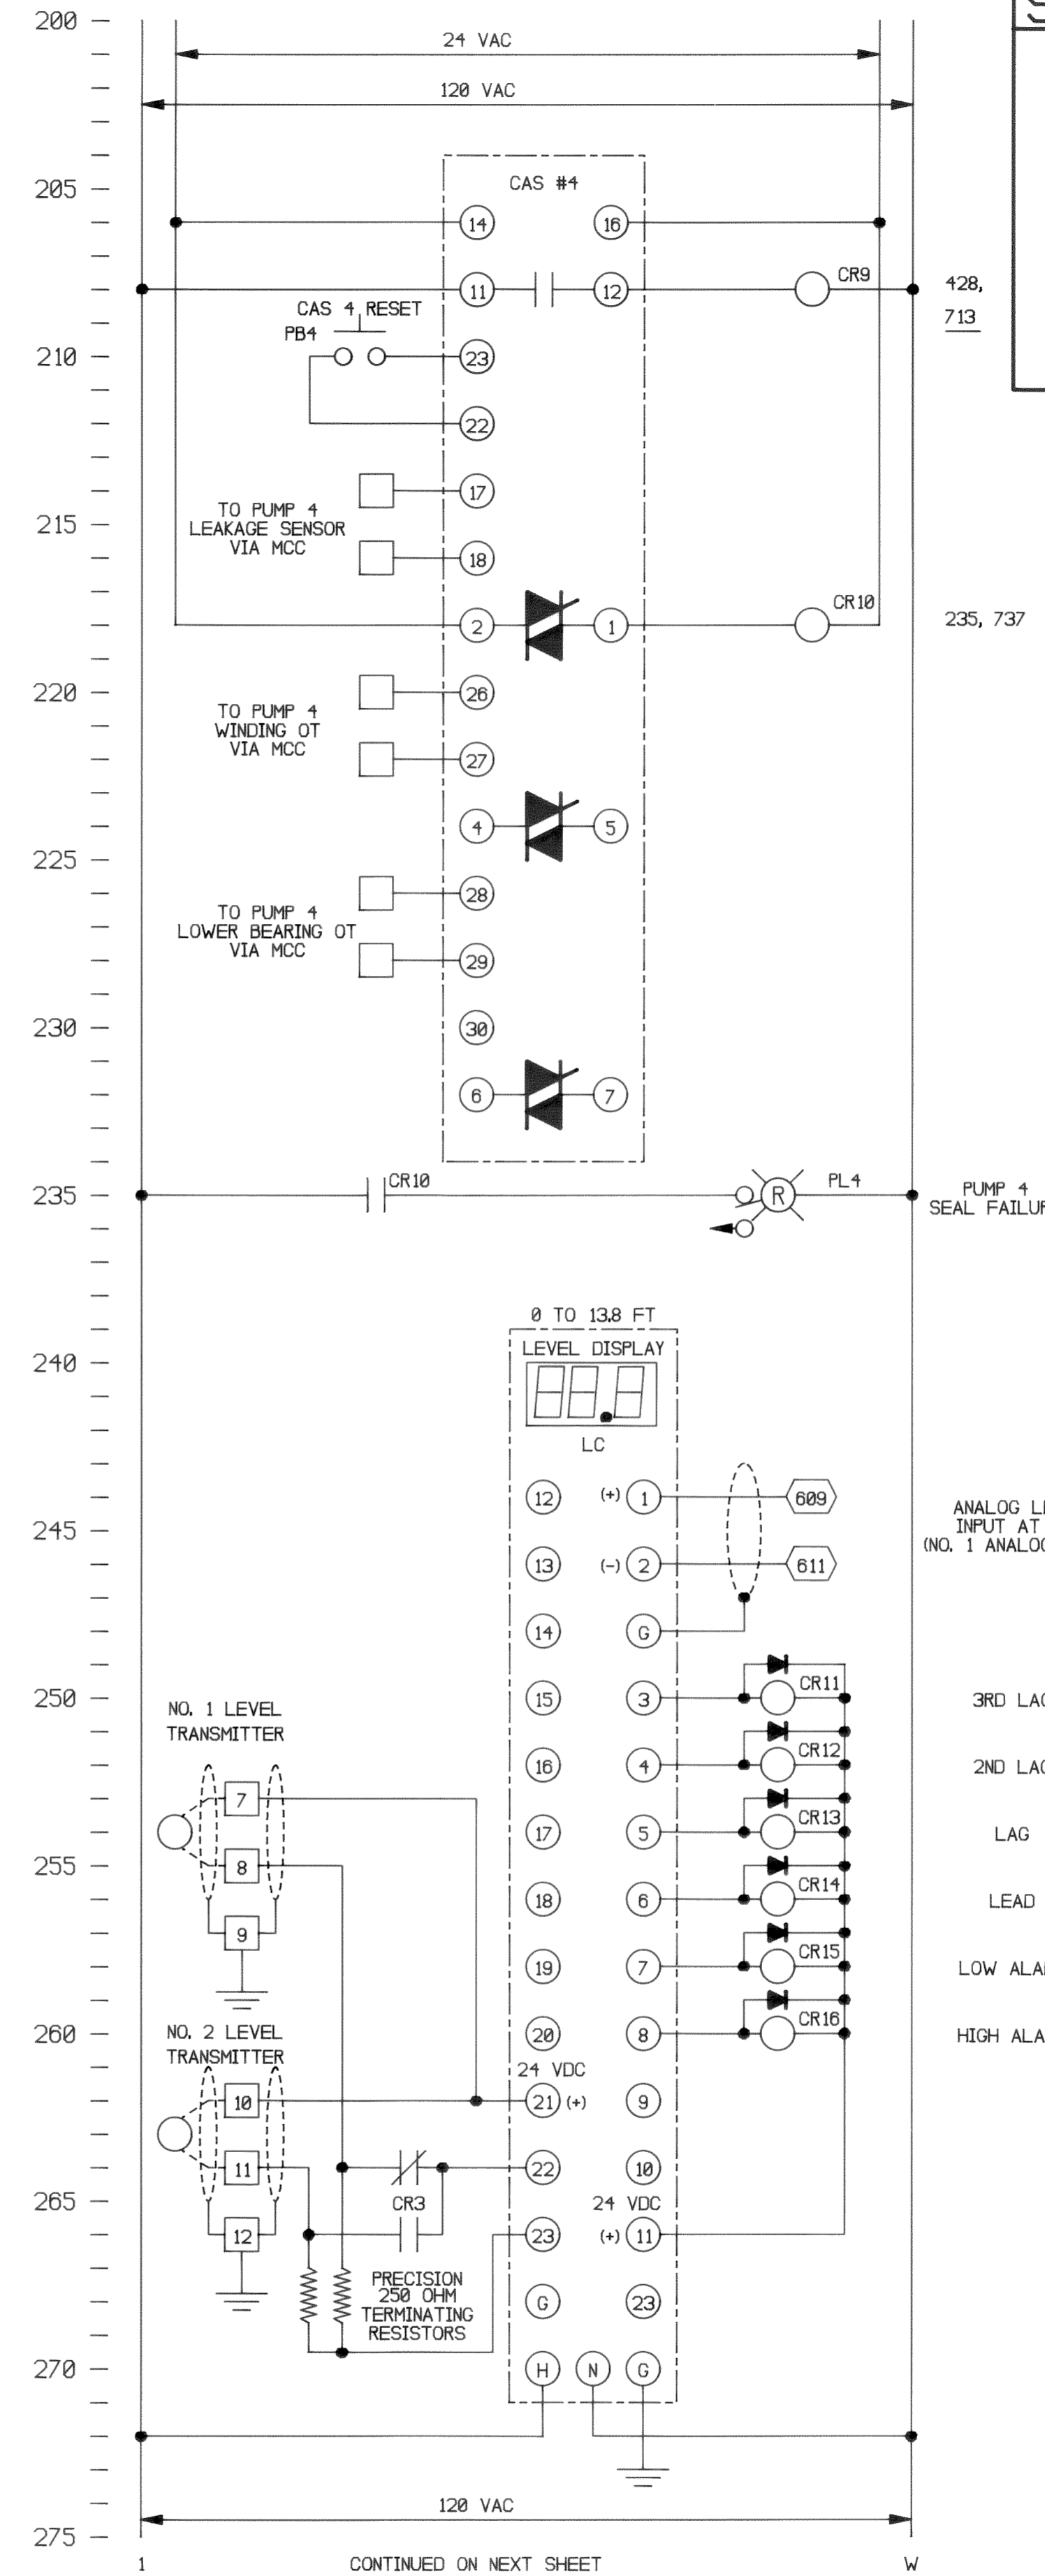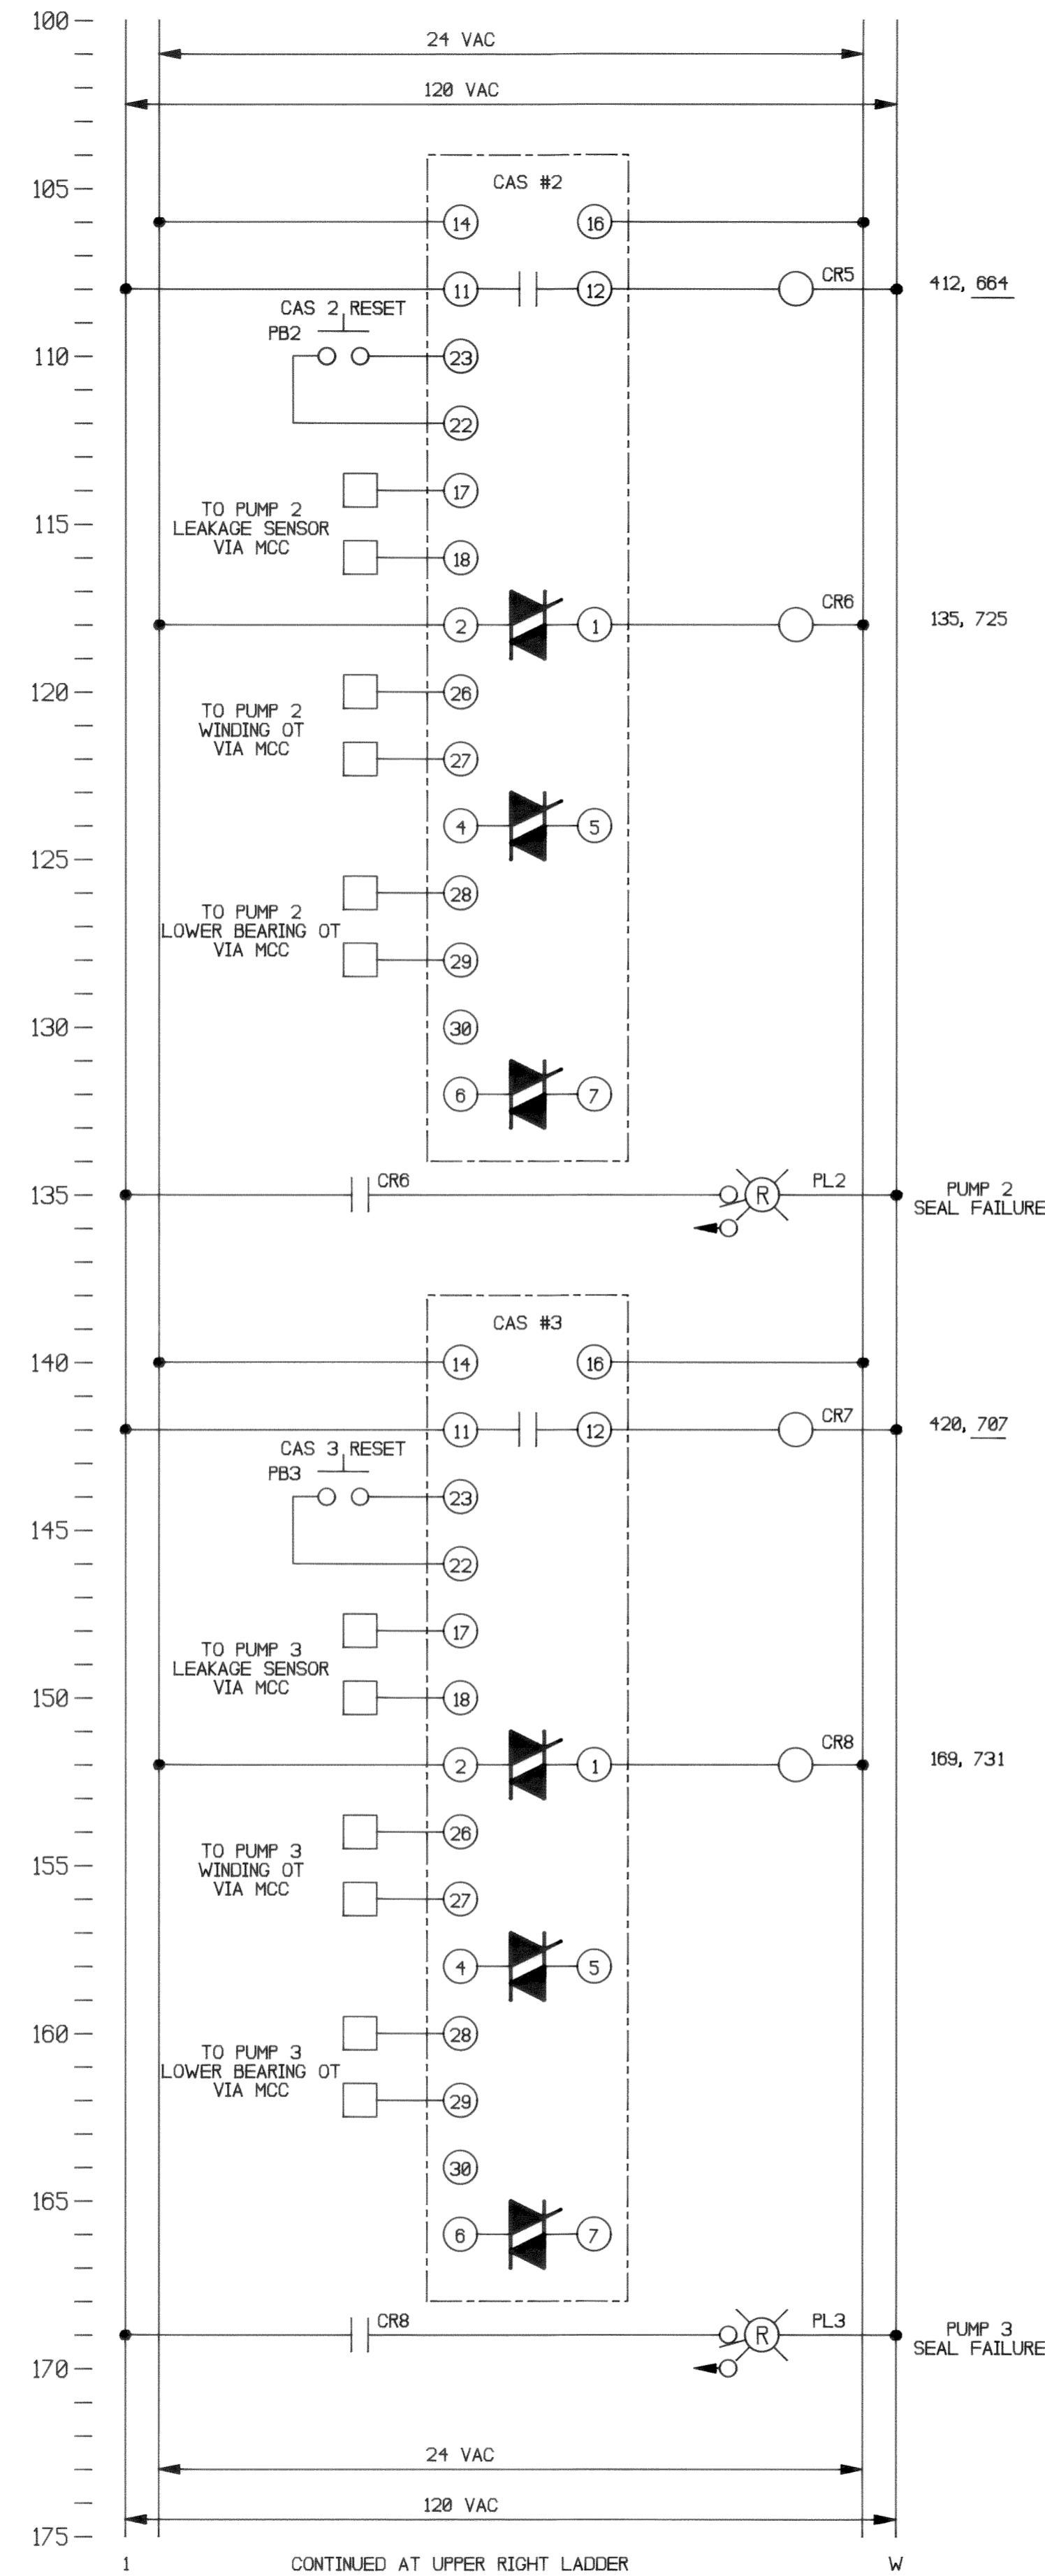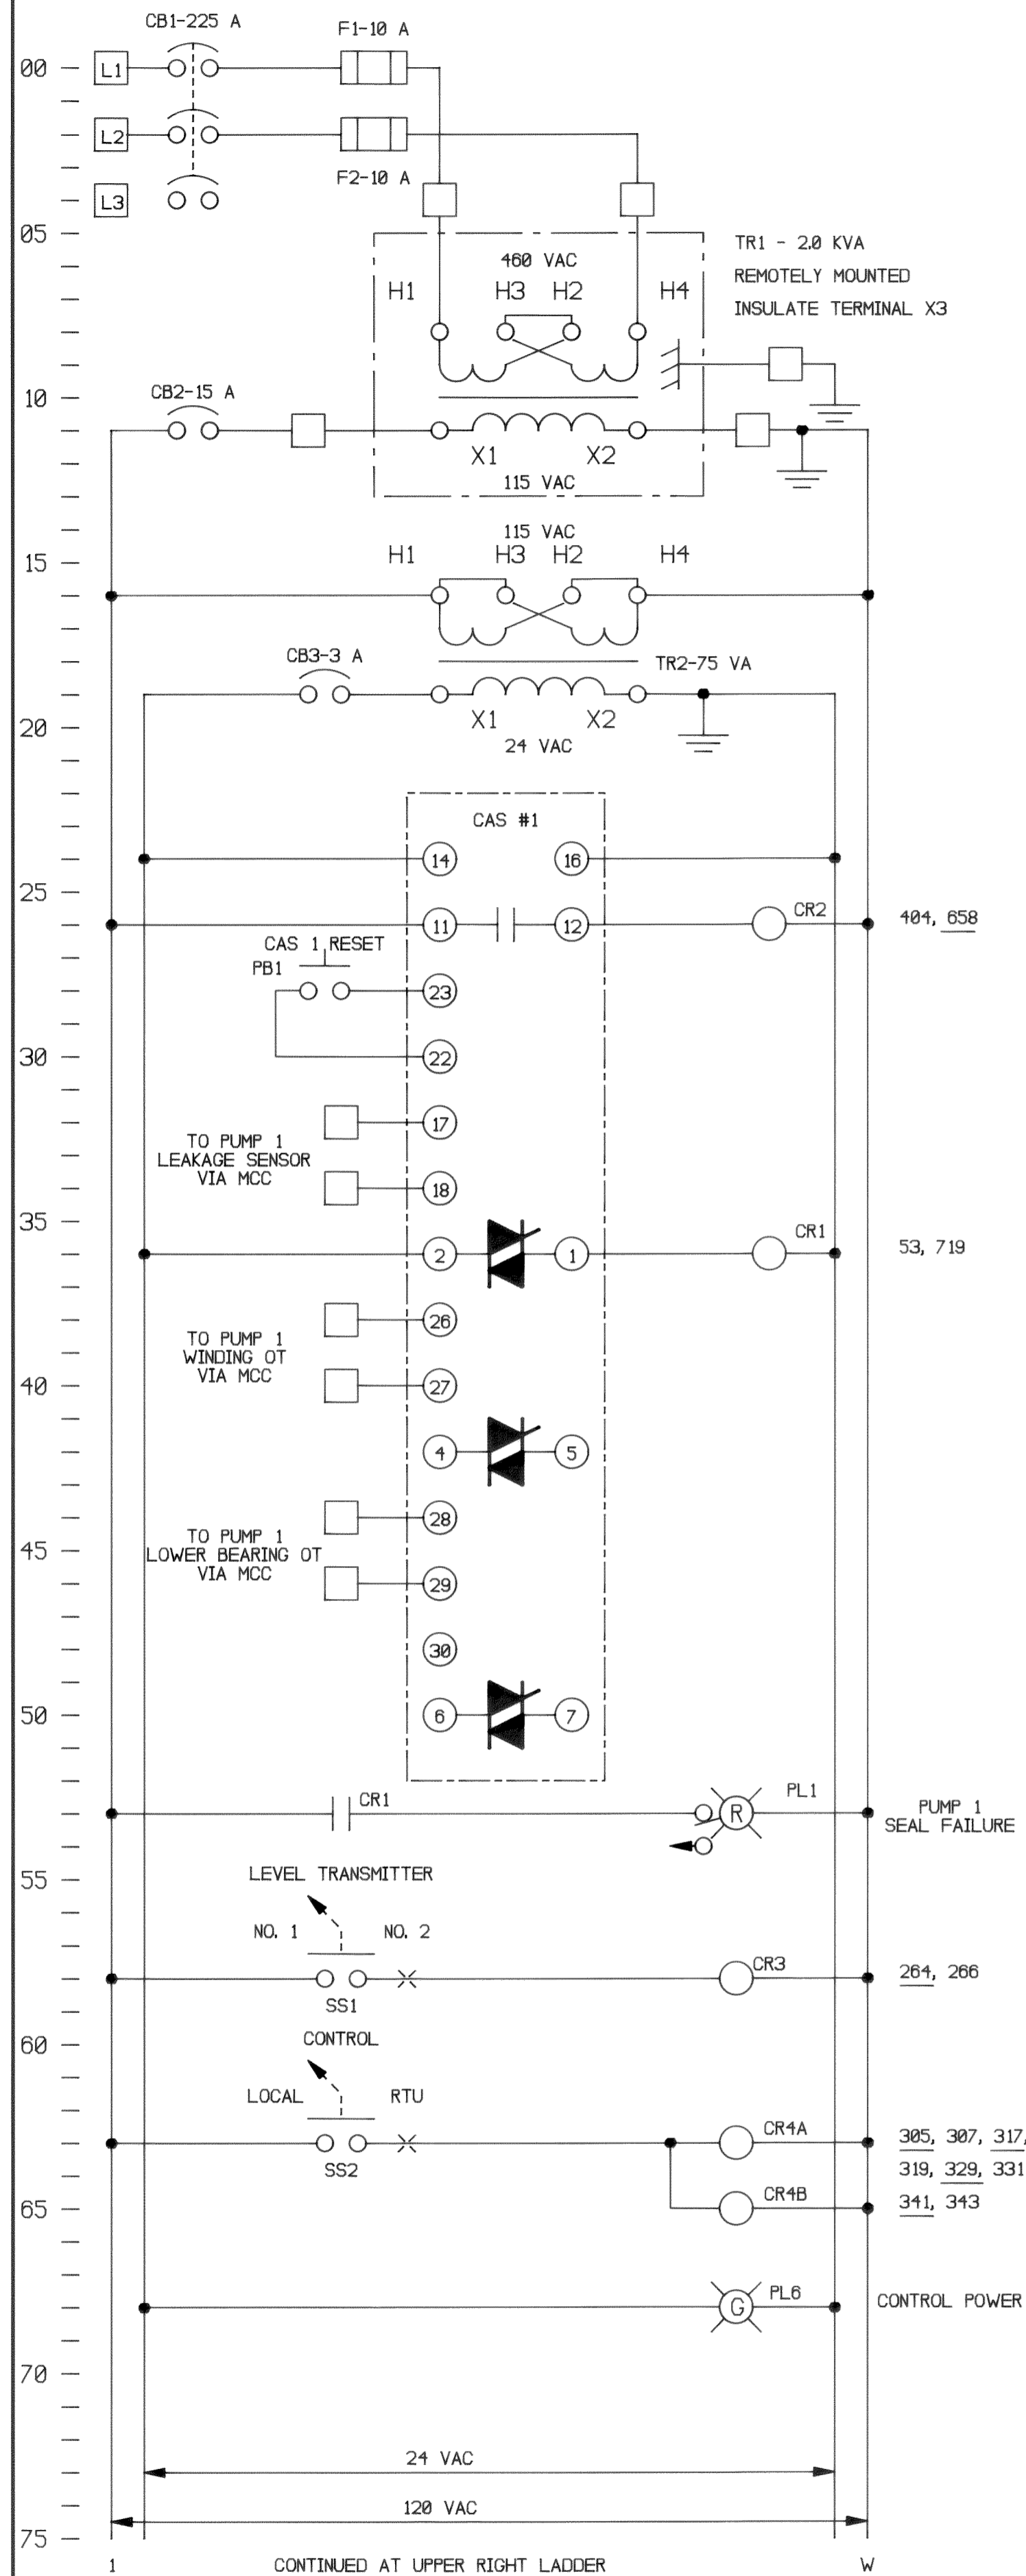

SPECIAL NOTICE CONCERNING CONTROL PANEL

- CONTRACTOR AT HIS OPTION MAY SUPPLY AN ENTIRELY NEW PANEL, OR AN ENTIRELY NEW BACK PANEL TO AVOID REBUILDING THE EXISTING PANEL IN THE FIELD. PROPOSED OR MODIFIED PANEL IS CALLED CP-1.
- REGARDLESS OF HOW CONTRACTOR CHOOSES TO PROVIDE PANEL, STATION MUST BE PROVIDED WITH A TEMPORARY PUMP CONTROL PANEL WHICH WILL CONTROL AT LEAST TWO PUMPS DURING A SHORT PERIOD OF TIME DURING WHICH THE STATION IS NOT FULLY OPERATIONAL. THE NATURE AND DURATION OF THE LESS THAN FULLY OPERATIONAL CONDITION SHALL BE APPROVED BY THE DELAWARE COUNTY SANITARY ENGINEER IN WRITING.
- PROPOSED TEMPORARY PUMP CONTROL PANEL WIRING DIAGRAM, COMPONENT DESCRIPTION, AND OTHER PARTICULARS SHALL BE SUBMITTED TO OWNER FOR REVIEW AND PERMISSION TO INSTALL.


NOTES

- PANEL GROUND TERMINAL MUST BE CONNECTED TO MCC EQUIPMENT GROUNDING BUS WITH NEC SIZED CONDUCTOR.
- PANEL WIRING SHOWN SOLID FIELD WIRING SHOWN DOTTED.
- PUMP MONITORING UNIT (CAS) ALARM INTERLOCK CONTACT (TERMINALS 11 & 12) IS CLOSED WHEN ALL ALARMS ARE IN A SAFE CONDITION. CONTACTS 11 & 12 'OPEN' UPON MALFUNCTION OR ALARM CONDITION.
- SURGE SUPPRESSOR TO BE CONNECTED TO RTU.
- SILVER BAND ON DAMPER DIODE SHALL BE CONNECTED TO (+) SUPPLY.
- IF A FLYGT CAS COMPATIBLE SET OF PUMP SENSORS ARE NOT PROVIDED WITH THE PROPOSED PUMPS, PROVIDE ALTERNATIVE MONITOR SYSTEM PROVIDING THE SAME FUNCTIONS ACCEPTABLE TO OWNER AND ENGINEER.
- MATERIALS IN EXISTING PUMP 4 CONTROL PANEL MAY BE REUSED IN CONSTRUCTING CONTROL PANEL CP-1 IF IN GOOD CONDITION.
- RELABEL WIRES, RELAYS, AND OTHER DEVICES TO CONFORM TO CP-1 DRAWINGS OR APPROVED SHOP DRAWINGS.
- SHOP DRAWINGS SHALL SHOW CONTACT RUNG NUMBER LOCATIONS AND WIRE NUMBERS.
- PUMP SUPPLIER SHALL FURNISH PUMP MONITOR FOR LEAK, WINDING OVER TEMPERATURE LOWER BEARING OVER TEMPERATURE, AND OTHER CONDITIONS WHICH PUMP MANUFACTURER RECOMMENDS TO BE MONITORED. PUMP SUPPLIER SHALL CONVEY SUCH MONITORS AND APPLICATION DATA TO PANEL BUILDER. PANEL BUILDER SHALL INSTALL THE MONITORS IN THE CONTROL PANEL. PANEL BUILDER SHALL INCLUDE MONITOR APPLICATION DATA IN PANEL O&M MANUALS.





ANALOG LEVEL INPUT AT RTU (NO. 1 ANALOG INPUT)

3RD LAG	341
2ND LAG	329
LAG	317
LEAD	385
LOW ALARM	743
HIGH ALARM	745

SCHEMATIC WIRING DIAGRAM, CONTROL PANEL CP-1
NOT TO SCALE

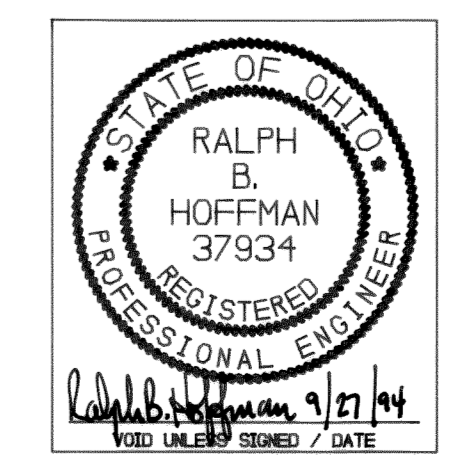

DELAWARE COUNTY, OHIO
ALUM CREEK PUMPING STATION
ELECTRICAL REVISIONS - 1994
HOFFMAN ENGINEERING CO.
CONSULTING ELECTRICAL & INSTRUMENTATION ENGINEERS
WESTERVILLE, OHIO
TEL: (614) 890-6272, FAX (614) 794-2030

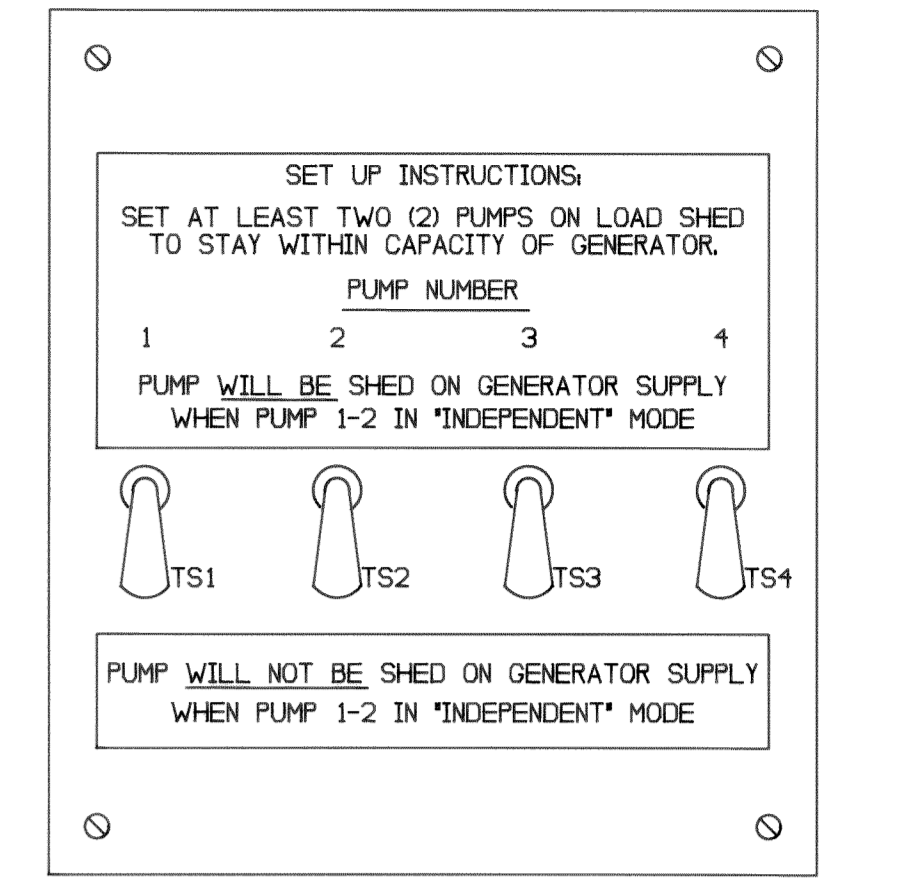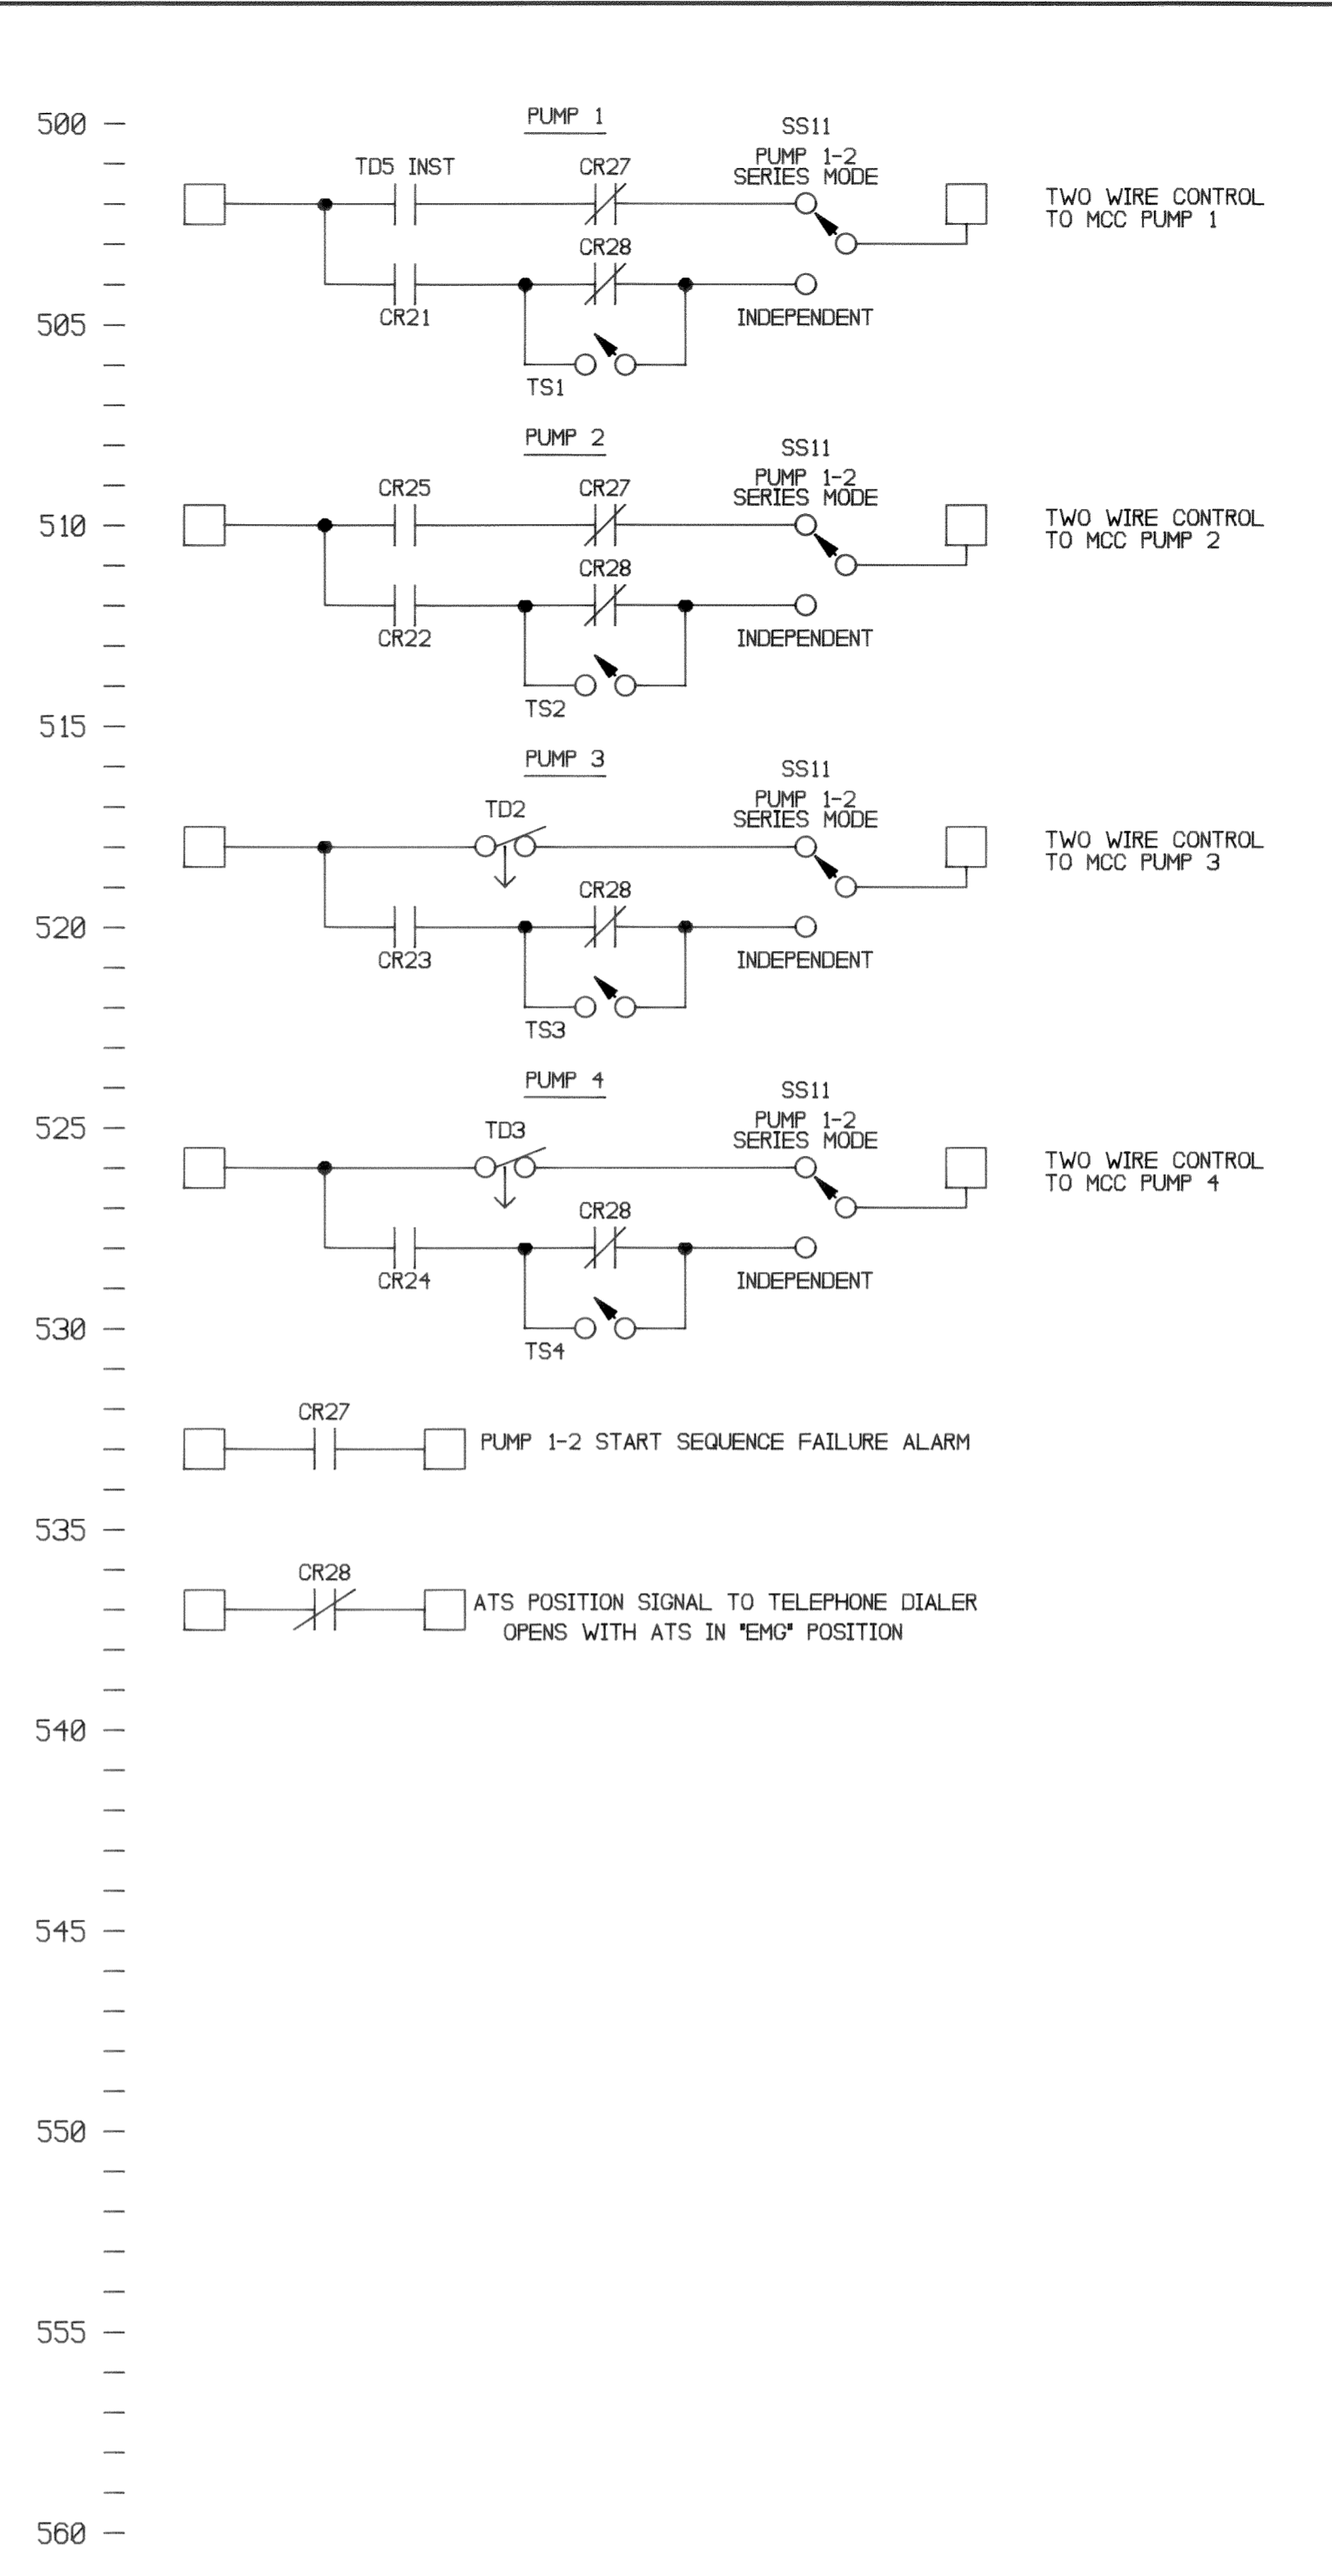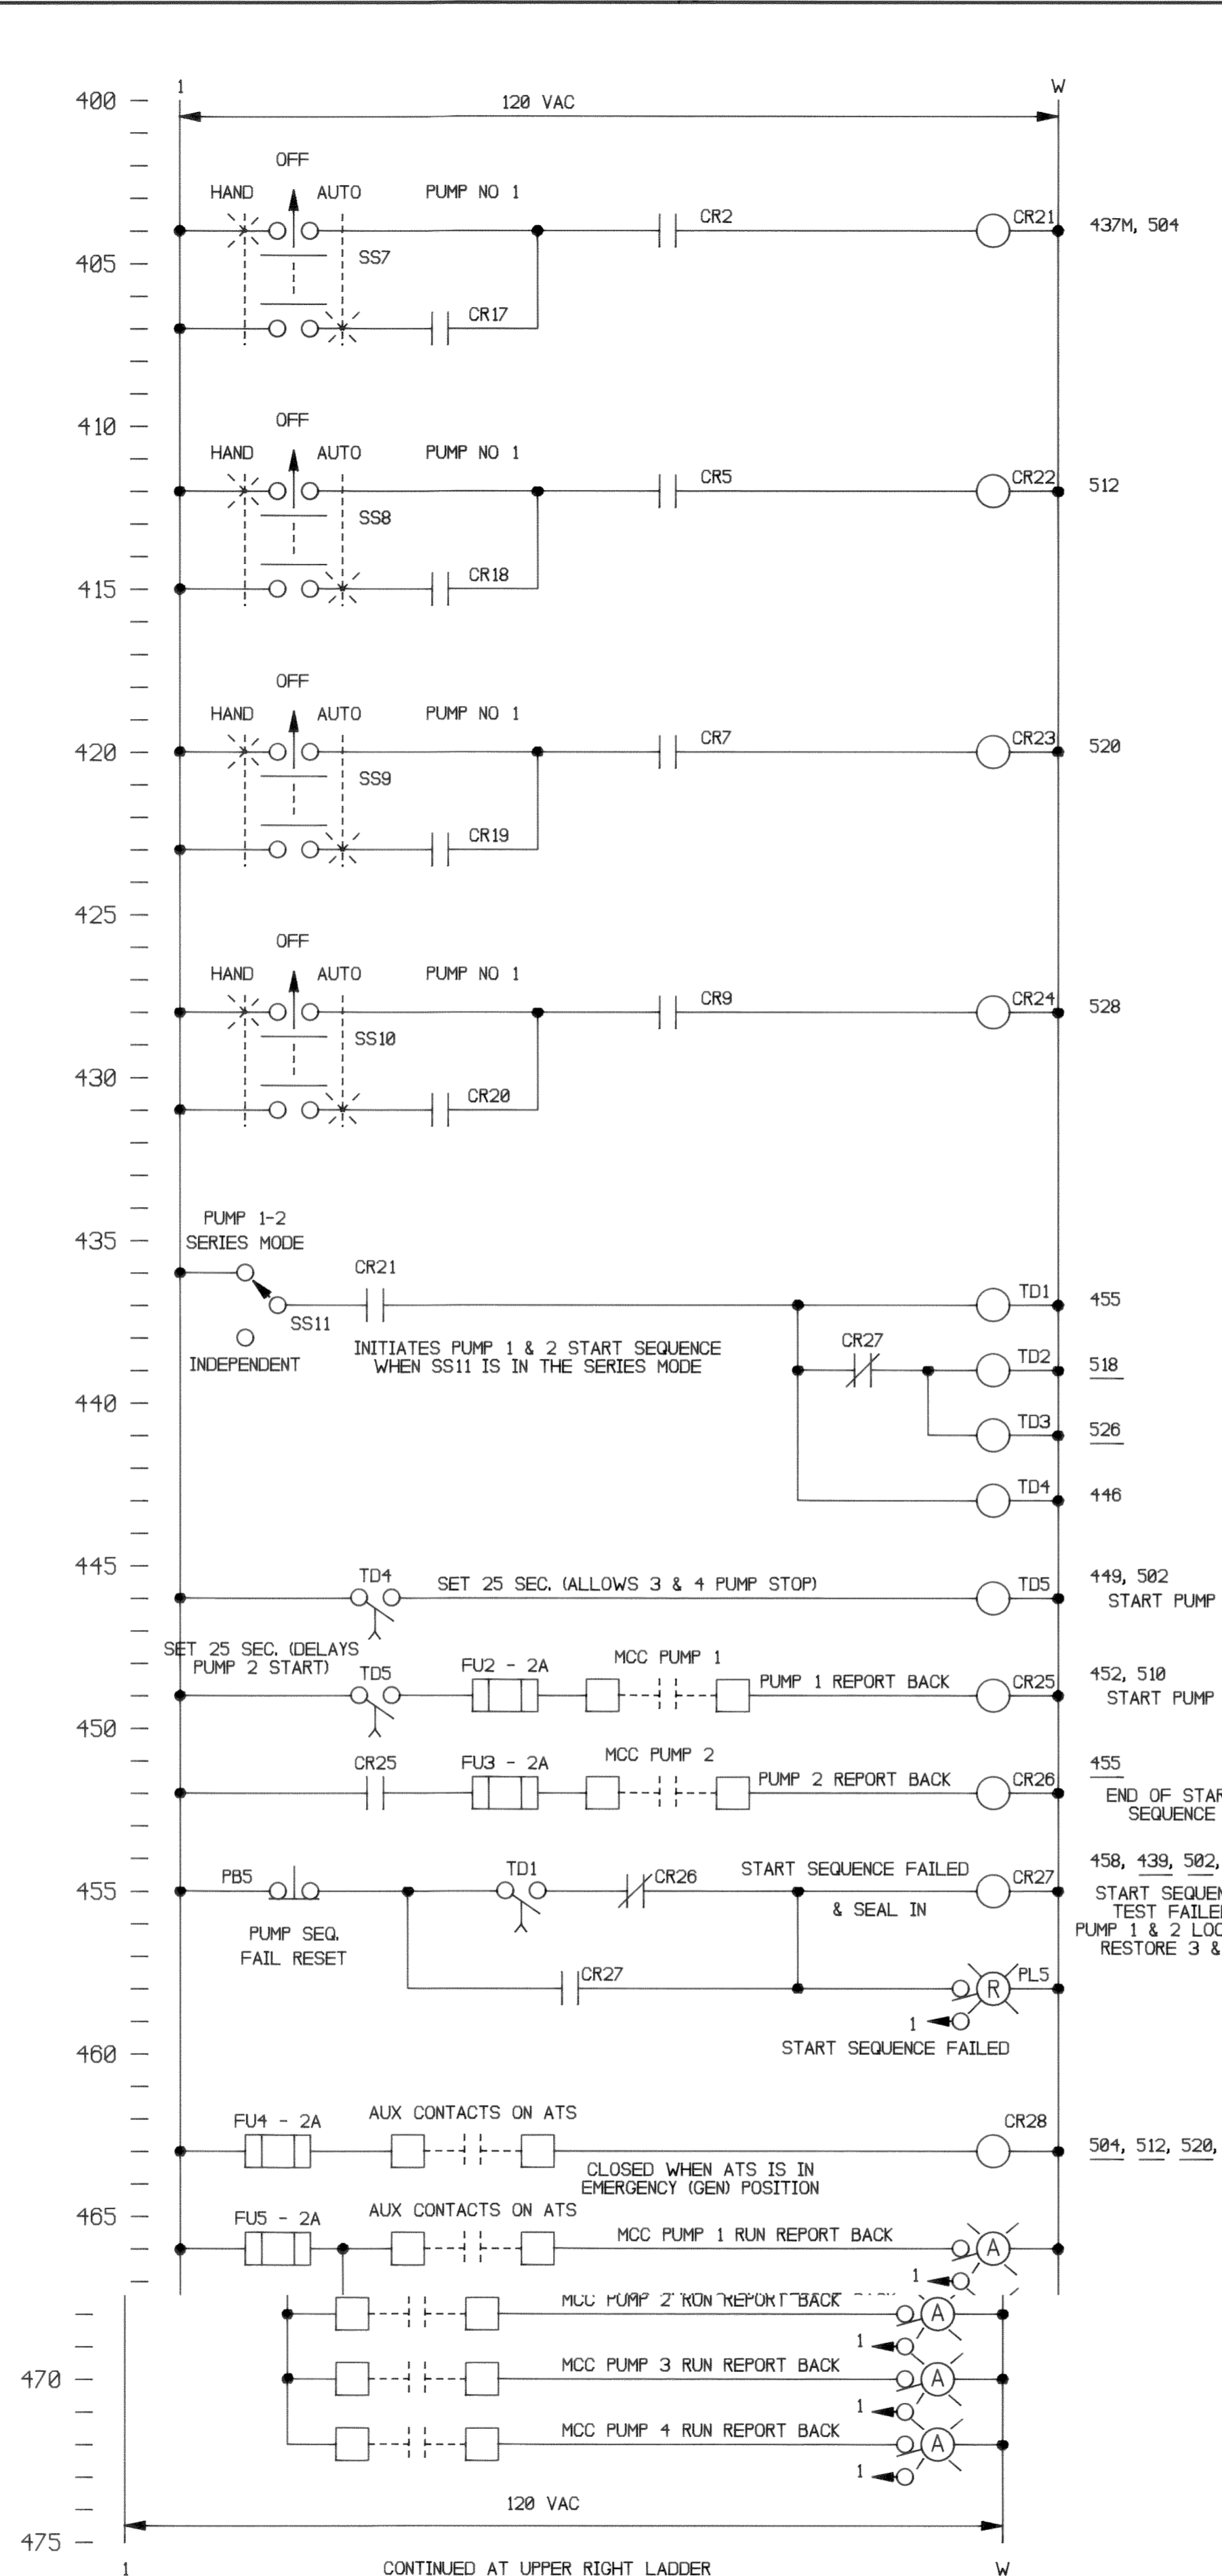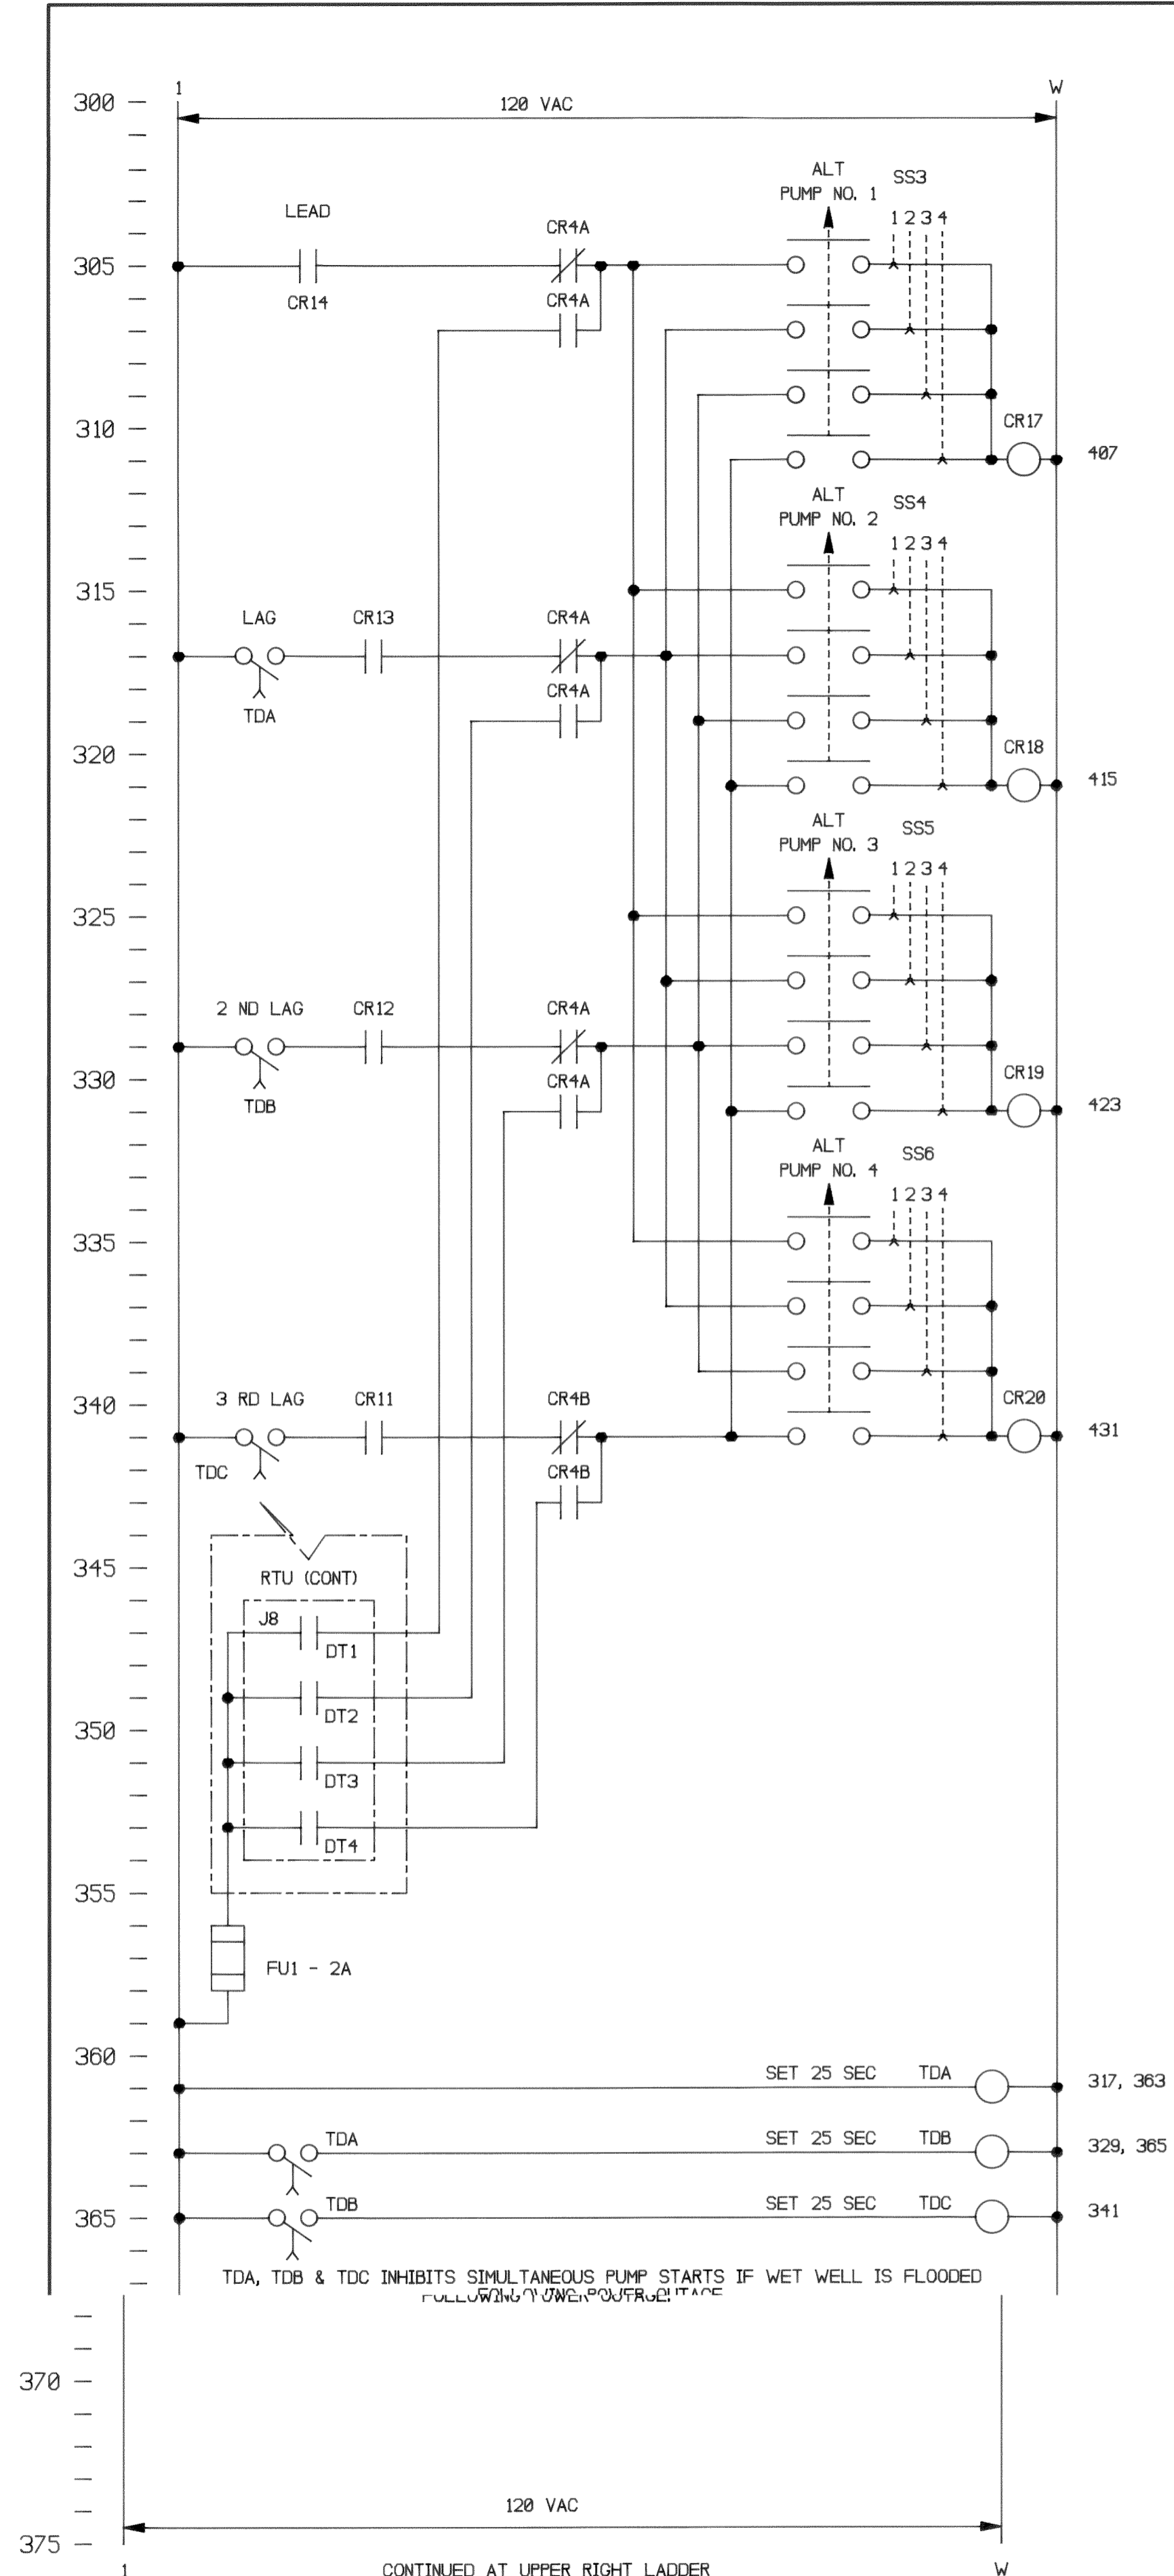


1. STAND OFF PANEL MOUNTED ON BACK PANEL.
 2. STEEL PANEL, PAINTED WHITE. MOUNT ON STANDOFF STUDS.
 3. PROVIDE BLACK LETTER ON WHITE BACKGROUND GRAVOPLATE PLATES.

GEN. LOAD SHED SWITCH ELEVATION

NOTES

- PANEL GROUND TERMINAL MUST BE CONNECTED TO MCC EQUIPMENT GROUNDING BUS WITH NEC SIZED CONDUCTOR.
- PANEL WIRING SHOWN SOLID _____
FIELD WIRING SHOWN DOTTED. - - - - -
- PUMP MONITORING UNIT (CAS) ALARM INTERLOCK CONTACT (TERMINALS 11 & 12) IS CLOSED WHEN ALL ALARMS ARE IN A SAFE CONDITION. CONTACTS 11 & 12 'OPEN' UPON MALFUNCTION OR ALARM CONDITION.
- SURGE SUPPRESSOR TO BE CONNECTED TO RTU.
- SILVER BAND ON DAMPER DIODE SHALL BE CONNECTED TO (+) SUPPLY.

SCHMATIC WIRING DIAGRAM, CONTROL PANEL CP-1
 NOT TO SCALE


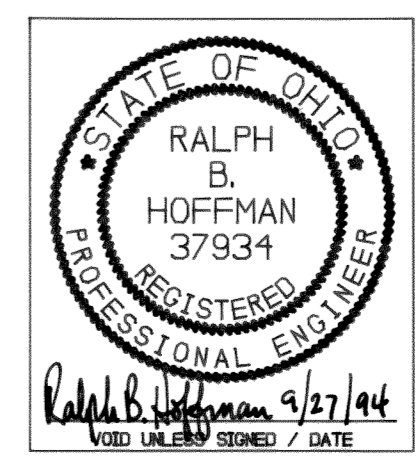


09/15/94
 9409BE10
E10

DELAWARE COUNTY, OHIO
 ALUM CREEK PUMPING STATION

ELECTRICAL REVISIONS - 1994


HOFFMAN ENGINEERING CO.
 CONSULTING ELECTRICAL & INSTRUMENTATION ENGINEERS
 WESTERVILLE, OHIO
 TEL: (614) 890-6272, FAX (614) 794-2030

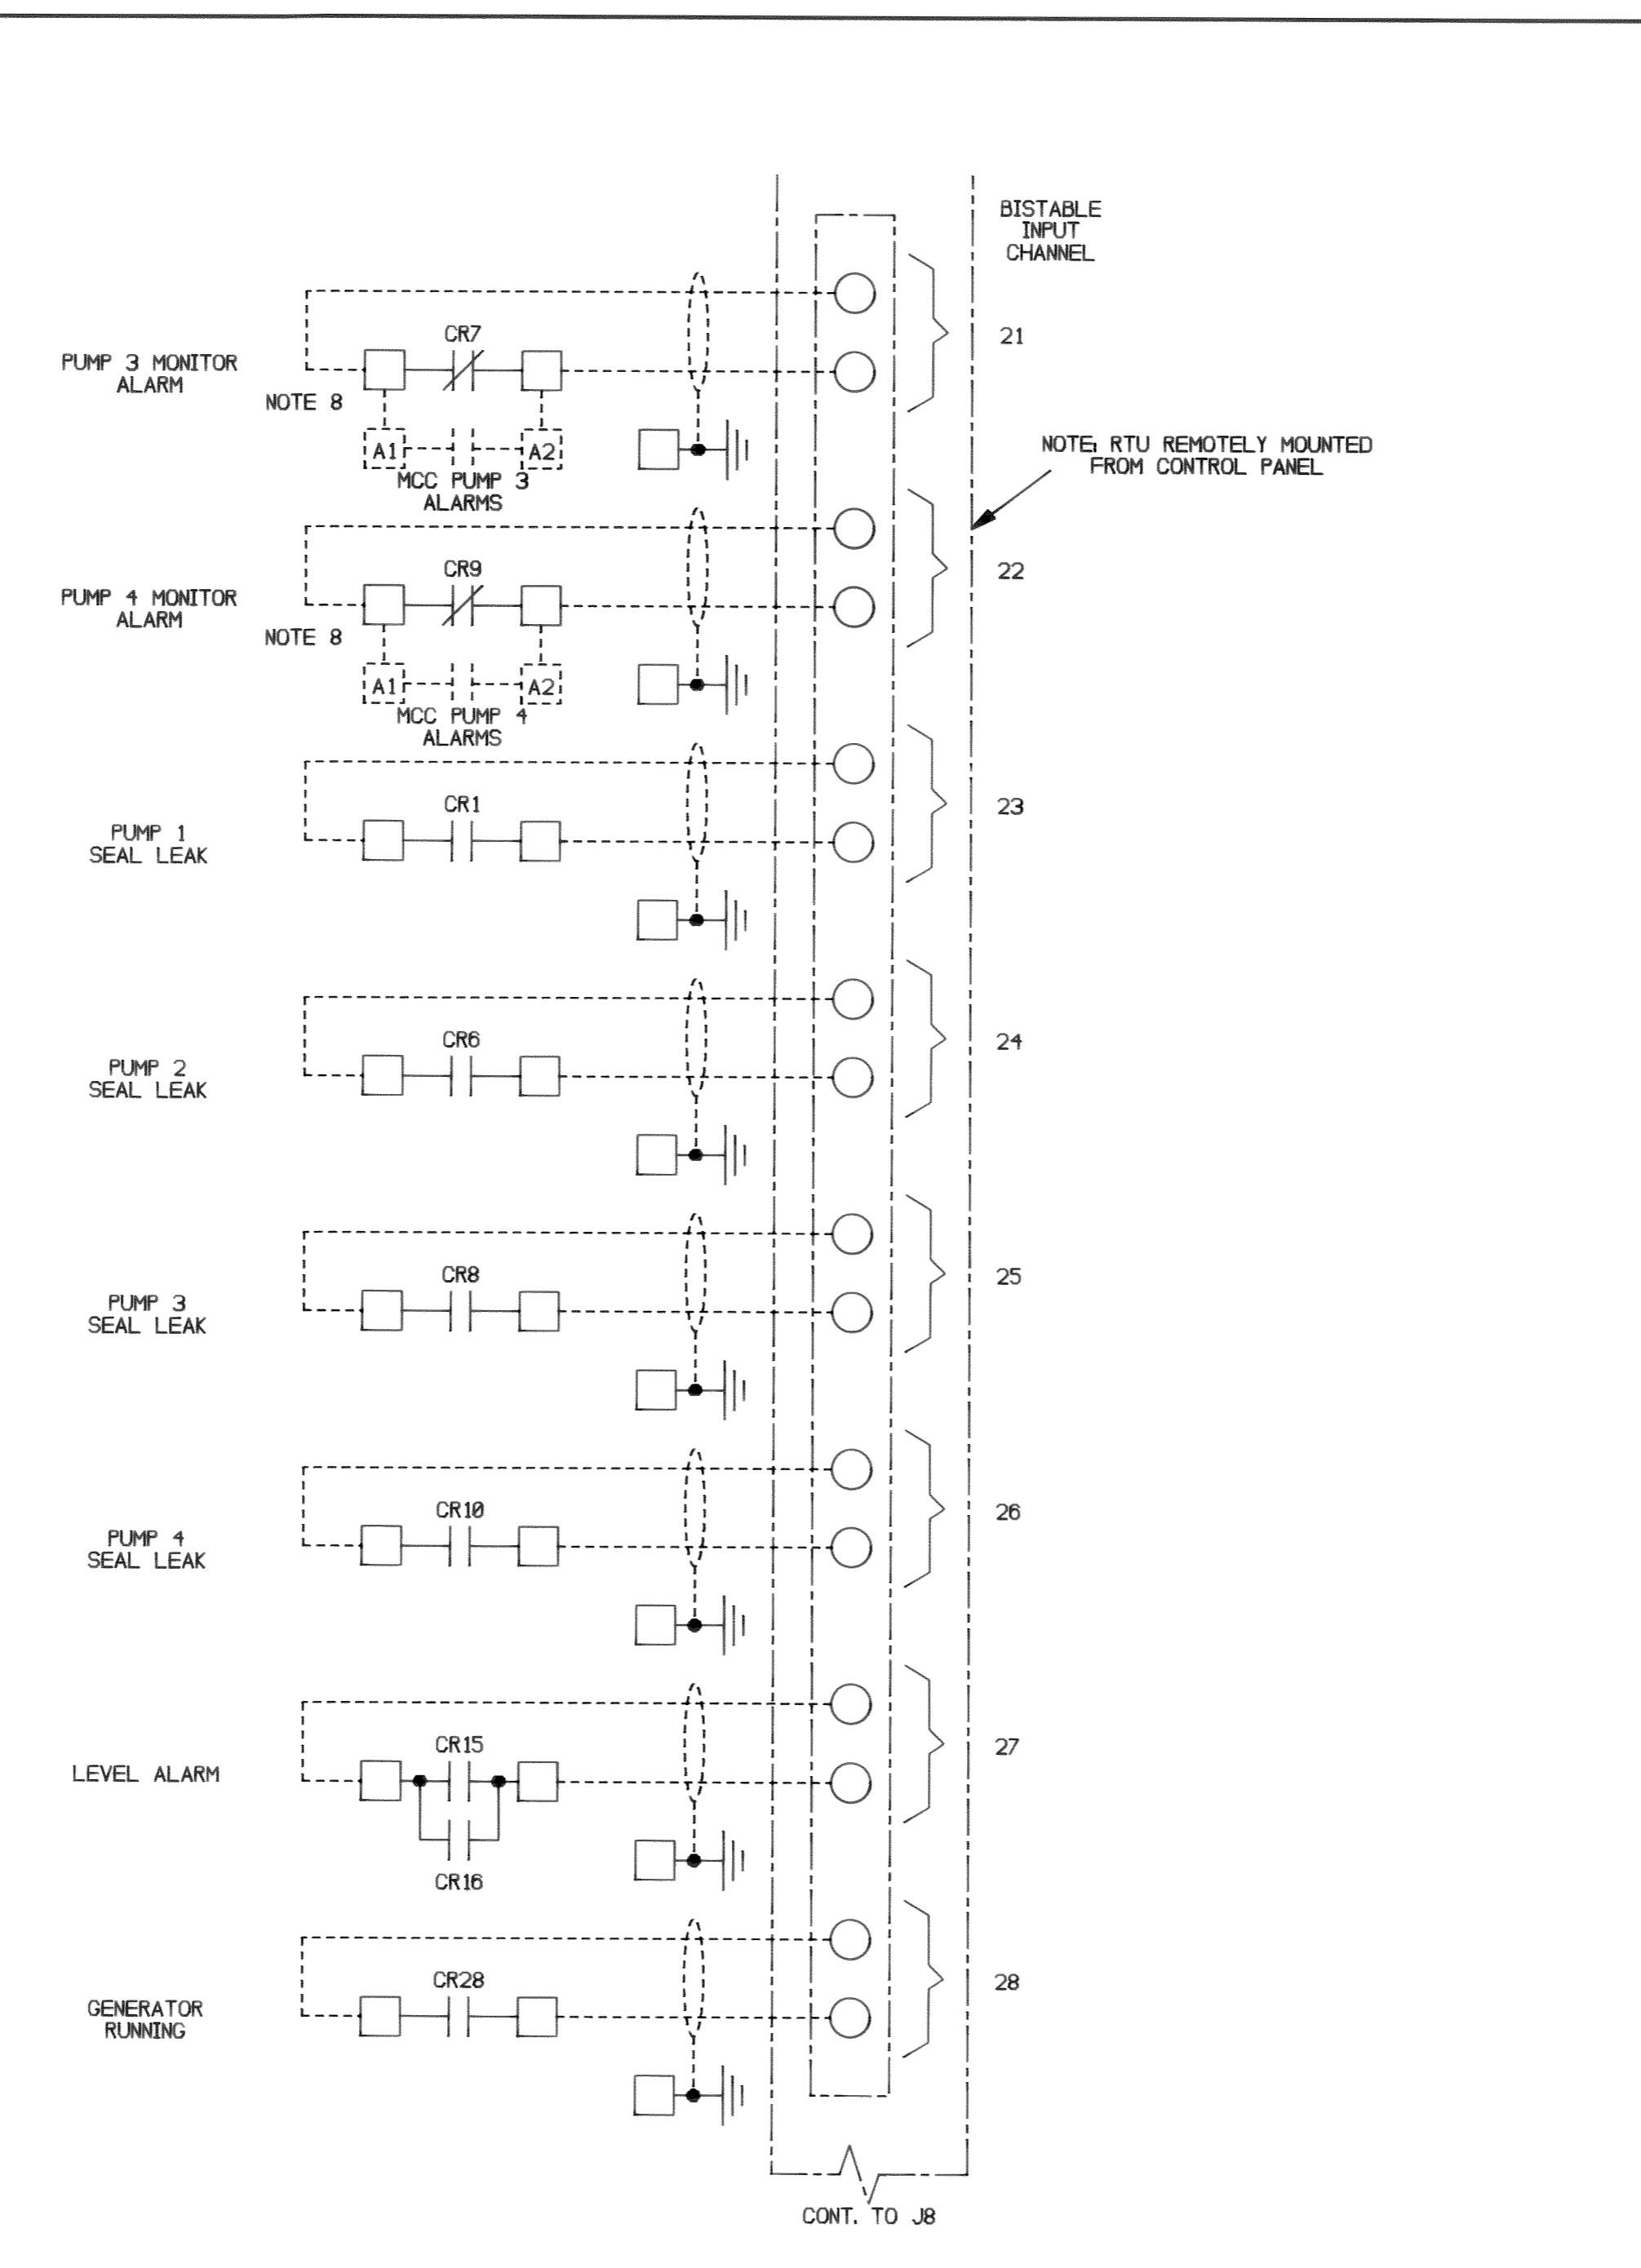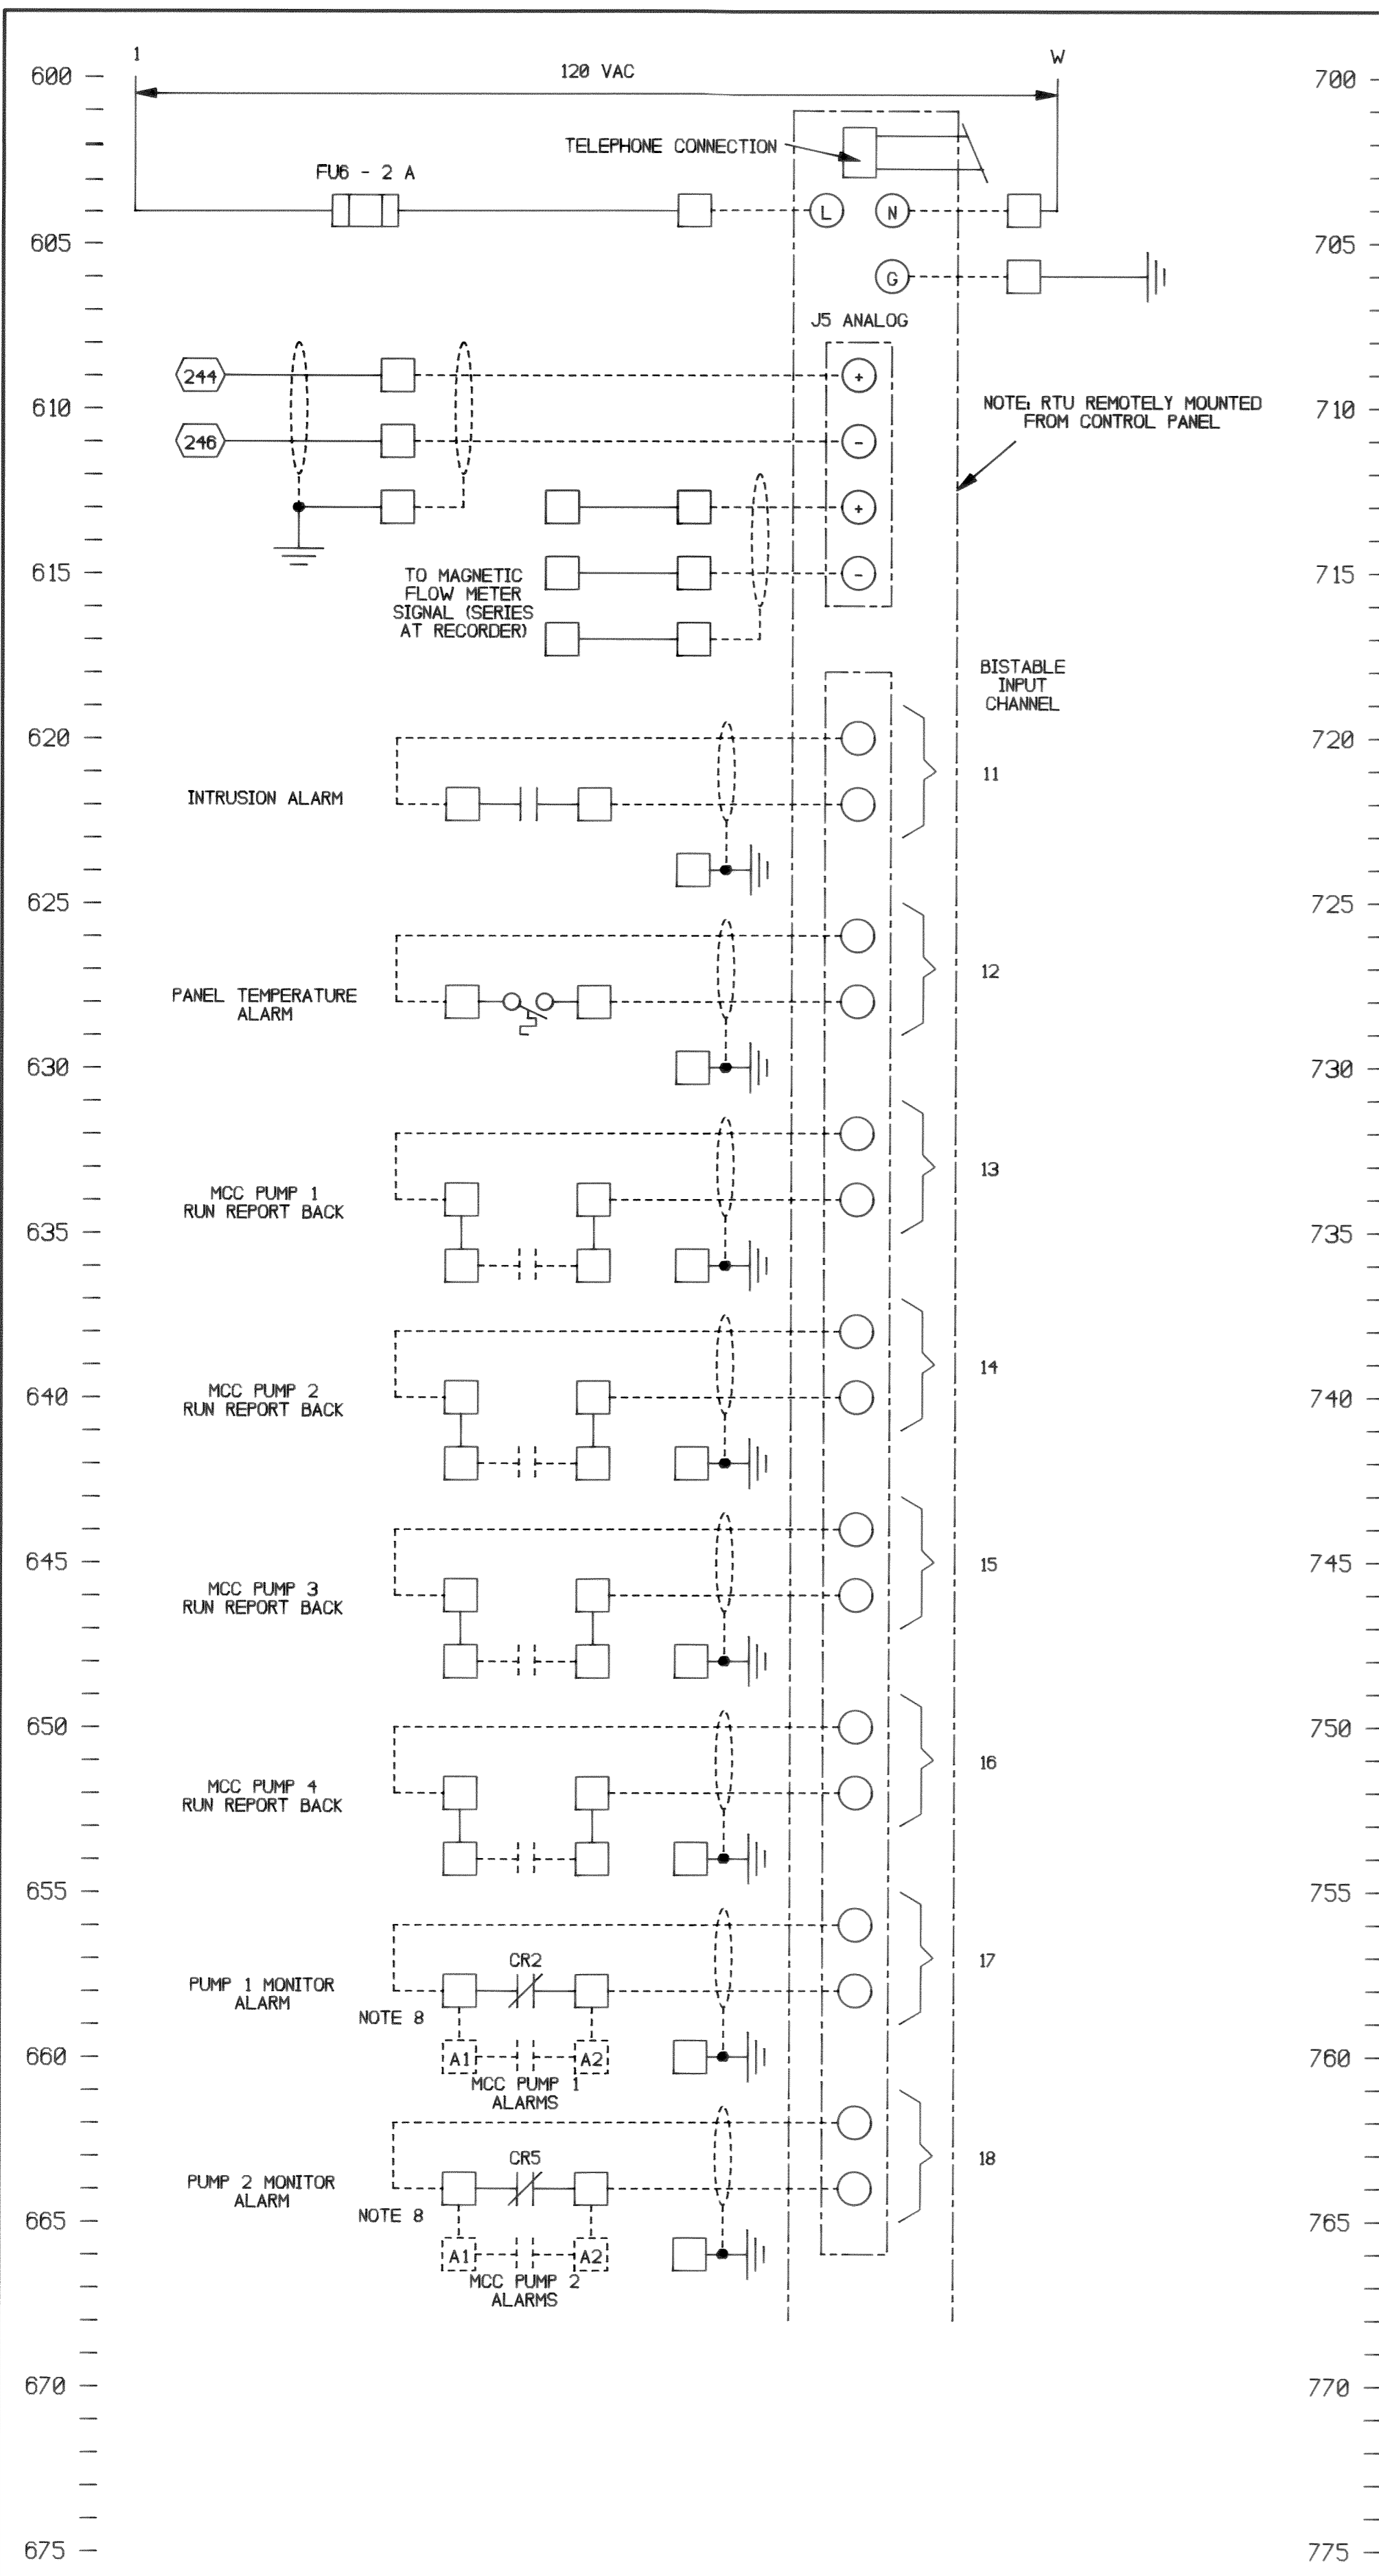

NOTES


1. PANEL GROUND TERMINAL MUST BE CONNECTED TO MCC EQUIPMENT GROUNDING BUS WITH NEC SIZED CONDUCTOR.
2. PANEL WIRING SHOWN SOLID _____
FIELD WIRING SHOWN DOTTED - - - - -
3. PUMP MONITORING UNIT (CAS) ALARM INTERLOCK CONTACT (TERMINALS 11 & 12) IS CLOSED WHEN ALL ALARMS ARE IN A SAFE CONDITION. CONTACTS 11 & 12 'OPEN' UPON MALFUNCTION OR ALARM CONDITION.
4. SURGE SUPPRESSOR TO BE CONNECTED TO RTU.
5. SILVER BAND ON DAMPER DIODE SHALL BE CONNECTED TO (+) SUPPLY.
6. BLANK OIL RESET HOLE AND RUNNING PL HOLES WITH A-B 800T-N1
7. REMOVE RUNNING TIME METER, COVER HOLE WITH INSTRUCTION LEGEN.
8. PARALLEL ALARM WIRES FROM MCC WITH WIRES FROM RTU IN CP-1 TERMINAL BLOCK.

NOT TO SCALE

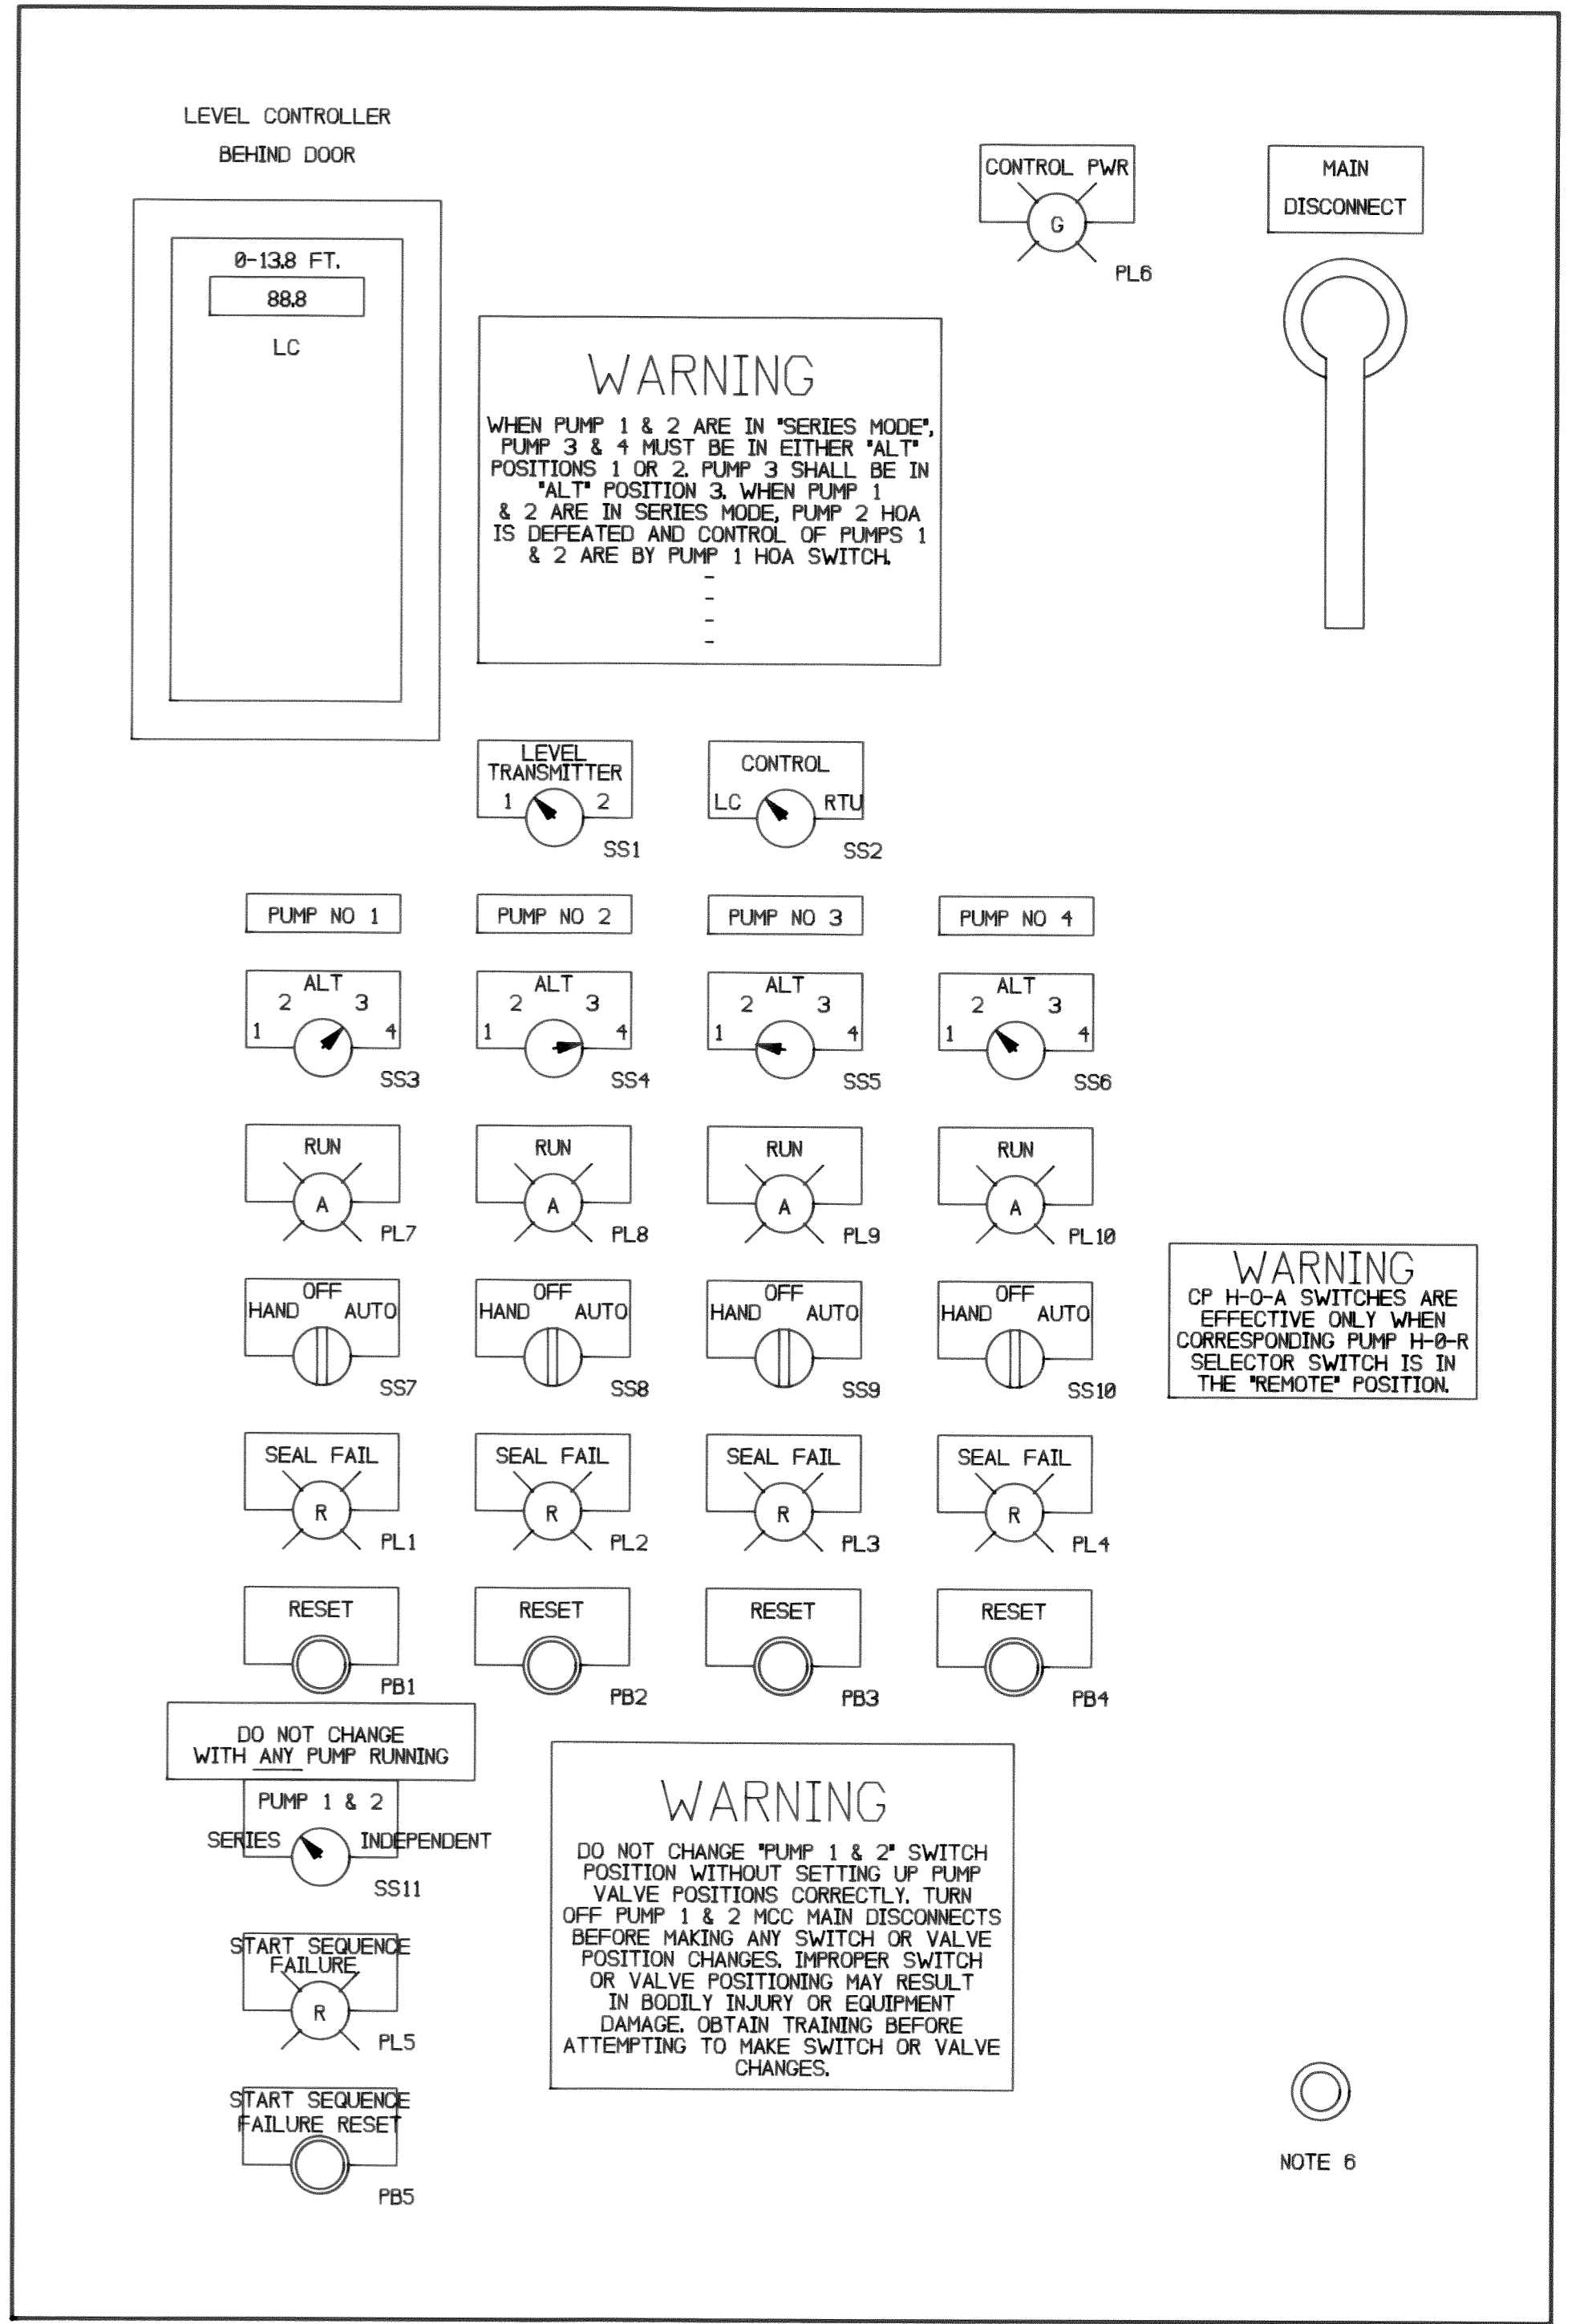

CP-1 DOOR ELEVATION
NOT TO SCALE

SCHEMATIC WIRING DIAGRAM, CONTROL PANEL CP-1

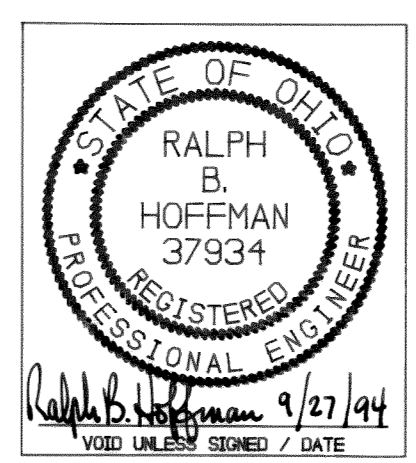

09/15/94
9409BELL
E11

DELAWARE COUNTY, OHIO
ALUM CREEK PUMPING STATION
ELECTRICAL REVISIONS - 1994
HOFFMAN ENGINEERING CO.
CONSULTING ELECTRICAL & INSTRUMENTATION ENGINEERS
WESTERVILLE, OHIO
TEL: (614) 890-6272, FAX (614) 794-2030

ELECTRICAL LEGEND

NOTE: ANY SYMBOL MAY BE MODIFIED BY WP=WEATHER PROOF. ANY SYMBOL USED IN A CLASSIFIED LOCATION SHALL BE MADE NEMA 7 CLASS 1 DIV. 1. GRP. D AND LISTED FOR W.P. USE IF LOCATED OUTDOORS. (ALL SYMBOLS DO NOT NECESSARILY APPLY)

SYMBOL	DESCRIPTION
	CEILING OUTLET, INCANDESCENT LIGHTING FIXTURE
	WALL OUTLET, INCANDESCENT LIGHTING FIXTURE NOTE: INSCRIBED LETTER DENOTES FIXTURE TYPE. (SEE FIXTURE SCHEDULE) NUMBER DENOTES CRT. BKR. NO., LOWER CASE LETTER DENOTES CONTROLLING SWITCH.
	CONVENIENCE OUTLET, SINGLE (GFI=GROUND FAULT INTERRUPTER)
	CONVENIENCE OUTLET, DUPLEX (GFI=GROUND FAULT INTERRUPTER) NUMBER DENOTES CB, LOWER CASE LTR. DENOTES CONTROLLING SW. 'T' MEANS MOUNT ABOVE TABLE OR LAB BENCH HEIGHT. COORDINATE HEIGHT WITH OTHER TRADES.
	WIRED JUNCTION BOX
	BLANK OUTLET BOX (MAY HAVE PULLED WIRE FOR FUTURE LOAD)
	CLOCK OUTLET
	SPECIAL OUTLET, AS REQUIRED
	CEILING MOUNTED EXIT LIGHT (WITH ARROWS AS INDICATED) WIRE AHEAD OF AREA LTG. SW.
	WALL MOUNTED EXIT LIGHT (WITH ARROWS AS INDICATED) WIRE AHEAD OF AREA LTG. SW.
	THERMOSTAT
	TELEPHONE OUTLET (T=TABLE HEIGHT, SEE NOTE)
	SW. LOCATION 3=THREE WAY, 4=FOUR WAY, ETC. a,b,c, ETC. CORRESPONDS TO CONTROLLED OUTLETS
	MANUAL MOTOR STARTER (MP=WITH PILOT LIGHT)
	SWITCH LOCATION K=KEY OPERATED, P=PILOT LIGHT 3,4 & a,b,c ETC. AS ABOVE
	ELECTRIC PANEL SURFACE MOUNTED FLUSH MOUNTED
	NON-FUSED SAFETY DISCONNECT SW. INDOOR=NEMA 1 , OUTDOOR=NEMA 4X , HORSEPOWER, VOLTAGE & NO. POLES RATED FOR LOAD CONCERNED, HEAVY DUTY (SEE BELOW FOR RATING CONVENTION)
	FUSED SAFETY SWITCH. INDOOR=NEMA 1 OUTDOOR=NEMA 4X . NEMA HEAVY DUTY. <div style="display: flex; align-items: center; justify-content: center;"> <div style="margin-right: 10px;">NO. OF FUSES</div> <div style="margin-right: 10px;">3</div> <div style="margin-right: 10px;">20</div> <div style="margin-right: 10px;">S/N</div> <div style="margin-right: 10px;">FUSE RATING (XX=NON FUSED)</div> </div> <div style="display: flex; align-items: center; justify-content: center;"> <div style="margin-right: 10px;">FUSE CLIPS</div> <div style="margin-right: 10px;">30</div> <div style="margin-right: 10px;">S/N</div> <div>SOLID NEUTRAL</div> </div>
	SINGLE PHASE MOTOR OUTLET. INCLUDES LIQUID TIGHT FLEXIBLE METAL CONDUIT AND WIRED GROUND. NO. INDICATES MOTOR HORSE-POWER.
	POLYPHASE MOTOR OUTLET. INCLUDES LIQUID TIGHT FLEXIBLE METAL CONDUIT AND WIRED GROUND. NO. INDICATES MOTOR HORSE-POWER.
	CEILING OUTLET. FLEX. FLUORESCENT LIGHTING FIXTURE. INSCRIBED LETTER DENOTES FIXTURE TYPE. NUMBER DENOTES CRT. BKR. LOWER CASE LETTER DENOTES CONTROLLING SWITCH.
	CONTROL STATION. NEMA HEAVY DUTY. NEMA 4/13 ENCLOSURE.
	DUAL HEAD BATTERY POWERED EMERGENCY EGRESS LTG. WITH INTEGRAL CHARGER, WIRE AHEAD OF AREA LTG. SW.
	COMBINATION MOTOR STR. NEMA 1 INDOOR NEMA 4X OUTDOORS 2/HV FUSES, CPT, 1LV FUSE, 120 CONTROL, PUSH TO TEST TRANSFORMER, AMBER P.L., OTHER CONTROL DEVICES BY NOTE.

SYMBOL	DESCRIPTION
	CONDUIT, EXPOSED
	CONDUIT IN SLAB, WALLS, OR UNDERGROUND (MAY ALSO INDICATE HIDDEN IN VIEW SHOWN - SUCH AS IN ROOM BELOW)
	CONDUIT TURNED DOWN
	CONDUIT TURNED UP

ELECTRICAL ABBREVIATIONS


TBD	TO BE DETERMINED AT A LATER DATE WHEN MISSING INFORMA- TION BECOMES AVAILABLE.
PROVIDE	FURNISH AND INSTALL ALL MATERIAL AND LABOR.
FURNISH	SUPPLY EQUIPMENT, INSTALLATION BY OTHERS
INSTALL	INSTALL AND/OR CONNECT EQUIPMENT FURNISHED BY OTHERS.
WP	WEATHER PROOF
EXP	EXPLOSION PROOF (CLASS, DIV, GRP. CORROSION RESISTANCE, WEATHER RESISTANCE PER LOCATION INVOLVED.)
F	FUSED (APPLIED TO SWITCHES, COMBINATION STARTERS, ETC.)
NF	NON-FUSED (AS APPLIED TO SWITCHES, COMBO. STARTERS, ETC.)
C	CONDUIT, THREADED, GALVANIZED RIGID METAL UNLESS FURTHER MODIFIED. SEE SPECIFICATIONS FOR OTHER PERMITTED ALTERNATIVES UNDER SPECIFIED CONDITIONS.
J OR JB	JUNCTION BOX
LP	LIGHTING PANEL OR PANEL BOARD
PP	POWER PANEL
AFF	ABOVE FINISHED FLOOR
AFG	ABOVE FINAL GRADE
BFG	BELOW FINAL GRADE
GRD OR GND	GROUND (ELECTRICAL SENSE - AS IN ROD, EQUIP. GRD., NEC 250)
REQ'D	REQUIRED BY APPLICATION, CODE, GOOD ENGINEERING PRACTICE
HP	HORSE POWER
DS OR DCS	DISCONNECT SWITCH
PB	PULL BOX
CB	THERMAL-MAGNETIC TRIP CIRCUIT BREAKER (IT - WITH INTER- CHANGABLE TRIP UNIT) WITH THE FOLLOWING FEATURE/..
W/	WITH THE FOLLOWING FEATURE/..
FLEX	FLEXIBLE METAL CONDUIT
LTFMC	LIQUID TIGHT FLEXIBLE METAL CONDUIT
LTG	LIGHT OR LIGHTING
MCC	MOTOR CONTROL CENTER
CP	CONTROL PANEL (MAY BE FURTHER IDENTIFIED W/NUMBER)
PS	PRESSURE SWITCH
FS	FLOAT SWITCH
VAC	VOLTS ALTERNATING CURRENT
VDC	VOLTS DIRECT CURRENT
VM	VOLT METER
AM	AMMETER
VS	VOLTMETER SELECTOR SWITCH
AS	AMMETER SELECTOR SWITCH
GFI	PERSONNEL PROTECTIVE GROUND FAULT CIRCUIT-INTERRUPTER
GFE	GROUND FAULT PROTECTION OF EQUIPMENT
CT	CURRENT TRANSFORMER
PT	POTENTIAL TRANSFORMER
CU	COPPER
USE	UNDERGROUND SERVICE ENTRANCE CABLE
UF	UNDERGROUND FEEDER CABLE
AIC	AMPERE INTERRUPTING CAPACITY (SYMMETRICAL)
KAIC	THOUSAND AMPERE INTERRUPTING CAPACITY (SYMMETRICAL)
KW	KILOWATTS
VA	VOLT AMPERES
KVA	KILOVOLT AMPERES
THW, THHN, (ETC.)	WIRE INSULATIONS WITH NEC CHAPTER 3 MEANING (ETC.)
NPC	NAME PLATE CURRENT
FLC	FULL LOAD CURRENT
FLA	FULL LOAD AMPERES
LRC	LOCKED ROTOR CURRENT
LRA	LOCKED ROTOR AMPERES

CONTROL PANEL CP-1

PARTIAL BILL OF MATERIAL, SEE DWGS. AND SPECS. FOR ADDITIONAL REQUIREMENTS		
SYMBOL	QTY.	DESCRIPTION OF MATERIAL
	AS REQ'D	TERMINAL BLOCKS + ACCESSORIES, AB 1492-CA1 + ACCESSORIES
FLYGT	3	FLYGT PROPRIETARY COMBINATION LEAK AND OVERTEMPERATURE
CAS PUMP MONITOR		PUMP PROTECTIVE MODULE. WIRE FROM DIAGRAM PROVIDED WITH UNIT.
PB1,2,3,4,5	5	PUSH BUTTON, BLACK, FLUSH HEAD, AB 800T-A2A
SS7,8,9,10	4	SELECTOR SWITCH, H-O-A, 1 NO, 1 NC, AB 800T-J2A
SS11	1	SELECTOR SWITCH, 8 POLE, DOUBLE THROW, POWER RATED, KEY OPERATED, ELECTROSWITCH, SERIES 31, ASSEMBLAGE 2, CAT. NO. 31204B, SET FOR 2 STOPS OR POSITIONS, WITH KEY OPERATED HANDLE CAT. NO. 65204B. SWITCH SHALL BE NON-SHORTING, PROVIDE STRAPPING LINKS OR STRAPPING JUMPERS AS REQUIRED.
PL1,2,3,4,5	5	PILOT LIGHT, PUSH TO TEST, TRANSFORMER, RED, AB 800T-PT16R
PL6	1	PILOT LIGHT, 24 VAC, GREEN, AB 800T-Q24G
TDA,B,C	3	RELAY, TIME DELAY, DELAY ON ENERGIZING, AB 700-PT200-A1
CR1,6,8,10	4	RELAY, 24 VAC COIL, AB 700-HB33A24, 3PDT
CR3,4A,4B,5,7,9	6	RELAY, 115 VAC COIL, 3PDT, AB 700-HB33A1
FU1,2,3,4,5,6	6	FUSE & FUSE BLOCK. FUSE BUS FNM-2A, MARATHON 6M30A1SPQ
TD1,2,3,4,5	5	RELAY, TIME DELAY, DELAY ON ENERGIZING, AB 700-PT200-A1
TS1,2,3,4	4	SWITCH, TOGGLE, 15 A, 125 VAC, 1/2 HP, HONEYWELL 11TS15-2. APPLY RING TERMINALS TO SWITCH SCREWS.
CR25,26,27,28	4	RELAY, INDUSTRIAL, 120 VAC COIL, AB-700-PXXX-A1. SELECT CONTACTS REQUIRED BY APPLICATION. ADHERE TO BALANCE OR DUMMY CARTRIDGE REQUIREMENTS OF MANUFACTURER.
PL7,8,9,10	4	PILOT LIGHT, PUSH TO TEST, TRANSFORMER, AMBER, AB 800T-PT16A
B1	1	CLOSING BUTTON, A-B 800T-N1
TR1	1	TRANSFORMER, STABILIER, 2000 VA, 480 VAC INPUT, 120 VAC OUTPUT, 60 HERTZ, FILTERED, GE 9T91B4184. REMOTELY MOUNTED.
F1,2	2	FUSE & FUSE BLOCK. FUSE BUS FRS-R-10, MARATHON 6F30A3B
THIS MATERIAL LIST BASED UPON REUSE OF EXISTING PANEL COMPONENTS. ADDITIONAL MATERIALS ARE REQUIRED IF CONTRACTOR CHOOSES TO PROVIDE ENTIRELY NEW PANEL.		
SEE SECTION 16910 FOR OTHER STANDARD SPECIFICATIONS FOR PILOT LIGHTS, SELECTOR SWITCHES, AND SIMILAR MATERIALS.		

NOTES

- PANEL BUILDER MAY REUSE EXISTING PANEL COMPONENTS WHERE THEY ARE IN GOOD
CONDITION AND APPROPRIATELY RATED FOR CURRENT APPLICATION. EXISTING COMPONENTS
ARE NOT ENTERED IN ABOVE PARTIAL MATERIAL LIST. SEE SHEET E8 FOR EXISTING
PANEL MATERIALS.
- PUMP MOTOR PROTECTIVE MONITOR FURNISHED BY PUMP SUPPLIER, INSTALLED IN CP-1
BY PANEL BUILDER. ALERT PUMP SUPPLIER TO THIS REQUIREMENT.

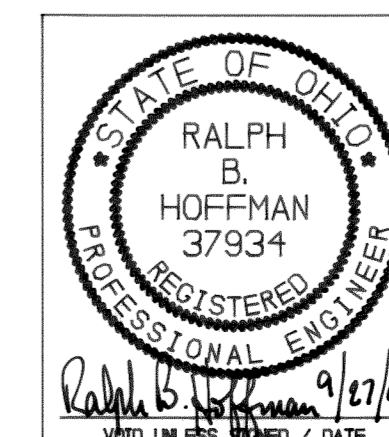


09/15/94
9409BE12
E12

DELAWARE COUNTY, OHIO

ALUM CREEK PUMPING STATION

ELECTRICAL REVISIONS - 1994

HOFFMAN ENGINEERING CO.
CONSULTING ELECTRICAL & INSTRUMENTATION ENGINEERS
WESTERVILLE, OHIO
TEL: (614) 898-6272, FAX: (614) 794-2838

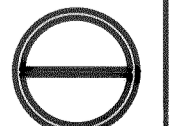

WIRE REF. NUMBER	FUNCTION / DESCRIPTION	FROM			WIRE NUMBER OR DESIGNATION	TO			WIRE GAUGE, CABLE TYPE, OR SIMILAR INFORMATION	CONDUIT REFERENCE	REMARKS OR CLARIFICATION	CHECK 1	CHECK 2
		TERMINAL EQUIP. NAME OR DESIGNATION	TERMINAL BOARD NUMBER	TERMINAL NUMBER		TERMINAL EQUIP. NAME OR DESIGNATION	TERMINAL BOARD NUMBER	TERMINAL NUMBER					
001	LEAKAGE SENSOR	MCC	PUMP 1		CP-1								
002	LEAKAGE SENSOR												
003	WINDING OT SENSOR												
004	WINDING OT SENSOR												
005	LOWER BEARING OT SENSOR												
006	LOWER BEARING OT SENSOR												
007	RUN REPORT BACK CP1 PL												
008	RUN REPORT BACK CP1 PL												
009	2 WIRE CONTROL												
010	2 WIRE CONTROL												
011	CB & OL TRIP ALARM												
012	CB & OL TRIP ALARM												
013	RUN REPORT/SEQUENCE												
014	RUN REPORT/SEQUENCE												
015	RUN REPORT BACK T/M				T/M UNIT					ROUTE VIA CP-1			
016	RUN REPORT BACK T/M												
017													
018													
019													
020	LEAKAGE SENSOR	MCC	PUMP 2		CP-1								
021	LEAKAGE SENSOR												
022	WINDING OT SENSOR												
023	WINDING OT SENSOR												
024	LOWER BEARING OT SENSOR												
025	LOWER BEARING OT SENSOR												
026	RUN REPORT BACK CP1 PL												
027	RUN REPORT BACK CP1 PL												
028	2 WIRE CONTROL												
029	2 WIRE CONTROL												
030	CB & OL TRIP ALARM												
031	CB & OL TRIP ALARM												
032	RUN REPORT/SEQUENCE												
033	RUN REPORT/SEQUENCE												
034	RUN REPORT BACK T/M				T/M UNIT					ROUTE VIA CP-1			
035	RUN REPORT BACK T/M												
036													
037													
038													
039													
040	LEAKAGE SENSOR	MCC	PUMP 3		CP-1								
041	LEAKAGE SENSOR												
042	WINDING OT SENSOR												
043	WINDING OT SENSOR												
044	LOWER BEARING OT SENSOR												
045	LOWER BEARING OT SENSOR												
046	RUN REPORT BACK CP1 PL												
047	RUN REPORT BACK CP1 PL												
048	2 WIRE CONTROL												
049	2 WIRE CONTROL												
050	CB & OL TRIP ALARM												
051	CB & OL TRIP ALARM												
052	RUN REPORT BACK T/M				T/M UNIT					ROUTE VIA CP-1			
053	RUN REPORT BACK T/M												
054													
055													
056													
057													
058													
059													
060	LEAKAGE SENSOR	MCC	PUMP 4		CP-1								
061	LEAKAGE SENSOR												
062	WINDING OT SENSOR												
063	WINDING OT SENSOR												
064	LOWER BEARING OT SENSOR												
065	LOWER BEARING OT SENSOR												
066	RUN REPORT BACK CP1 PL												
067	RUN REPORT BACK CP1 PL												
068	2 WIRE CONTROL												
069	2 WIRE CONTROL												
070	CB & OL TRIP ALARM												
071	CB & OL TRIP ALARM												
072	RUN REPORT BACK T/M				T/M UNIT					ROUTE VIA CP-1			
073	RUN REPORT BACK T/M												
074													
075													
076	WET WELL LEVEL SENSOR	1	NOTE 4	PT1	CP-1		NOTE 2		NOTE 3				
077	WET WELL LEVEL SENSOR	2	NOTE 4	PT2	CP-1		NOTE 2		NOTE 3				
078	LEVEL CONTROLLER			CP-1	RTU		BELDEN 8719		LEVEL SG. REPEATER				
079	FLOW SIGNAL			RECORDER	RTU		BELDEN 8719		ROUTE VIA CP-1				
080													
081													
082													

WIRE REF. NUMBER	FUNCTION / DESCRIPTION	FROM			WIRE NUMBER OR DESIGNATION	TO			WIRE GAUGE, CABLE TYPE, OR SIMILAR INFORMATION	CONDUIT REFERENCE	REMARKS OR CLARIFICATION	CHECK 1	CHECK 2
		TERMINAL EQUIP. NAME OR DESIGNATION	TERMINAL BOARD NUMBER	TERMINAL NUMBER		TERMINAL EQUIP. NAME OR DESIGNATION	TERMINAL BOARD NUMBER	TERMINAL NUMBER					
083	PANEL TEMP ALARM				CP1								
084	PANEL TEMP ALARM									RTU			
085	PUMP 1 FAIL												
086	PUMP 1 FAIL												
087	PUMP 2 FAIL												
088	PUMP 2 FAIL												
089	PUMP 3 FAIL												
090	PUMP 3 FAIL												
091	PUMP 4 FAIL												
092	PUMP 4 FAIL												
093	PUMP 1 SEAL LEAK												
094	PUMP 1 SEAL LEAK												
095	PUMP 2 SEAL LEAK												
096	PUMP 2 SEAL LEAK												
097	PUMP 3 SEAL LEAK												
098	PUMP 3 SEAL LEAK												
099	PUMP 4 SEAL LEAK												
100	PUMP 4 SEAL LEAK												
101	LEVEL ALARM												
102	LEVEL ALARM												
103	ATS GEN POSITION									ATS			CLOSED IN "EMG" POSITION
104	ATS GEN POSITION									ATS			CLOSED IN "EMG" POSITION
105	PUMP SEQUENCE FAIL									AUTODIALER			
106	PUMP SEQUENCE FAIL									AUTODIALER			
107	T/M POWER									T/M			
108	T/M POWER									T/M			
109													
110													
111													
112	RECORDER-FLOWMETER				RECORDER					FLOWMETER			NOTE 5
113	RECORDER-FLOWMETER				RECORDER					FLOWMETER			NOTE 5
114	RECORDER-FLOWMETER				RECORDER					FLOWMETER			NOTE 5
115	RECORDER-FLOWMETER				RECORDER					FLOWMETER			NOTE 5
116	RECORDER-FLOWMETER				RECORDER					FLOWMETER			NOTE 5
117	RECORDER-FLOWMETER				RECORDER					FLOWMETER			NOTE 5
118	RECORDER-FLOWMETER				RECORDER					FLOWMETER			NOTE 5
119	RECORDER-FLOWMETER				RECORDER					FLOWMETER			NOTE 5
120													
121													
122													
123													
124													
125	TELEPHONE PROVISION				TELE. BOARD					T/M UNIT			BELDEN 9566
126	TELEPHONE PROVISION				T/M UNIT					AUTODIALER			BELDEN 9566
127													
128													
NOTES

- THIS IS A PARTIAL LISTING OF WIRES AND CABLES FOR THE ENGINEERS CONVENIENCE. IT DOES NOT INCLUDE POWER CABLES IN GENERAL. CONTRACTOR IS RESPONSIBLE FOR IDENTIFYING ALL CABLES REQUIRED BY THE DRAWINGS AND SPECIFICATIONS AND SUPPLYING SAME WITH APPROPRIATE REFERENCE TO THE SPECIFICATIONS.
- MULTI-CONDUCTOR CABLE
- EXISTING CABLE OR WIRE, RECONNECT.
- LEVEL TRANSMITTER/SENSOR EXISTING, AND LOCATED IN WET WELL. RECONNECT.
- CONTRACTOR SHALL FILL IN WIRE NUMBER OR IDENTIFICATION, TERMINAL BOARD DESIGNATION, TERMINAL NUMBERS, ALL IN ACCORDANCE WITH SPECIFICATION 16013. PROVIDE TO ENGINEER BEFORE APPLICATION FOR FINAL PAYMENT.

L. D. F. AWARE COUNTY, OHIO

ALUM CREEK PUMPING STATION

ELECTRICAL REVISIONS - 1994

HOFFMAN ENGINEERING CO.
CONSULTING ELECTRICAL & INSTRUMENTATION ENGINEERS
WESTERVILLE, OHIO
TEL: (614) 890-6272, FAX (614) 794-2030

09/15/94
94090E13
E13

